
T 19 S, R4W, Sec 12 SW SW TL 400

Scale 1" = 400'

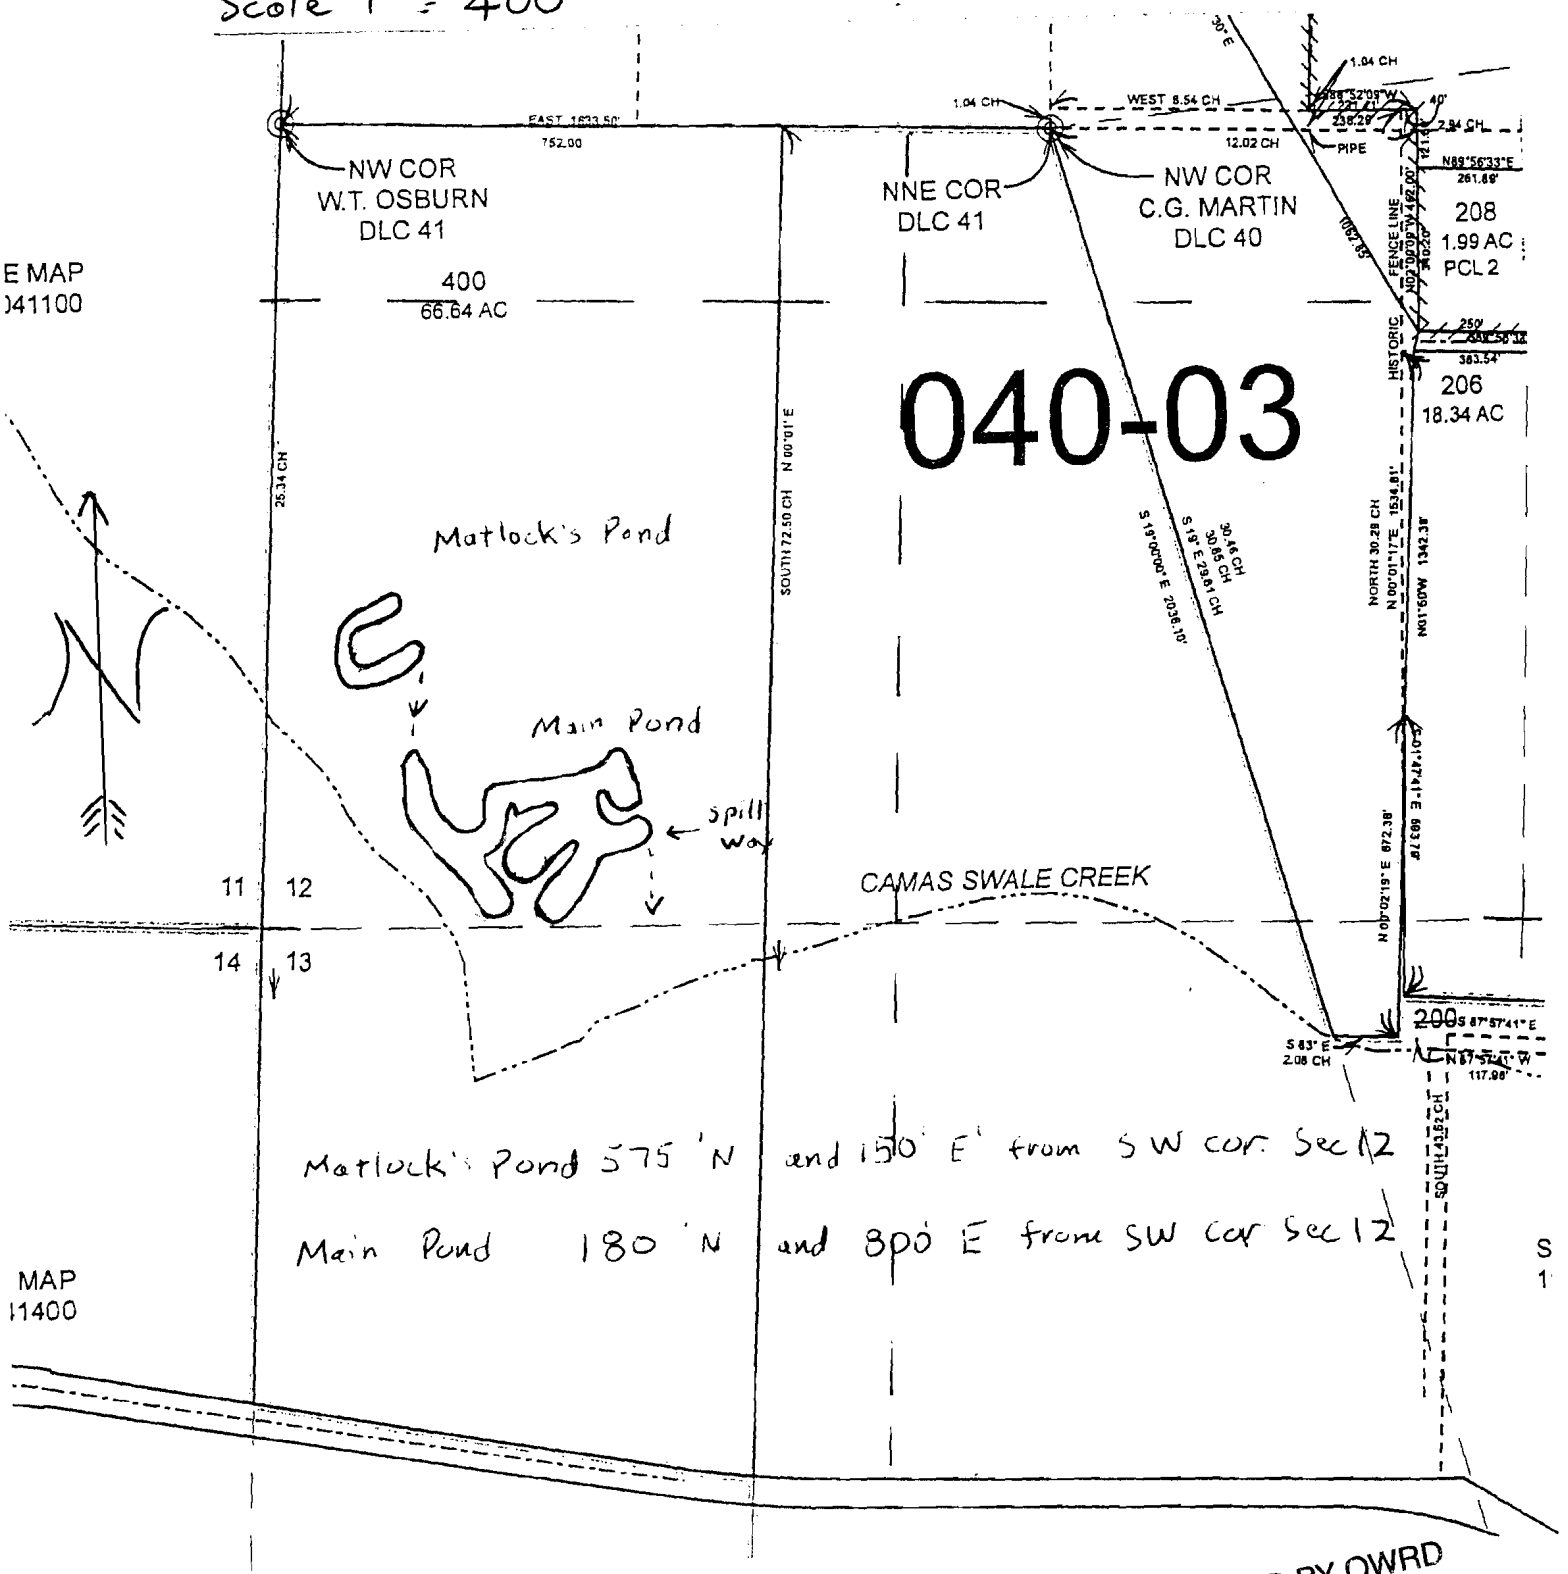


Matlock's Pond 575 'N and 150' E' from SW cor Sec 12

Main Pond 180 'N and 850 E from SW cor Sec 12

RECEIVED BY OWRD

DEC 30 2013

SALEM, OR

R-87949