


T 19 S, R 4 W, Sec 12 SW SW TL 400

scale 1" = 400'

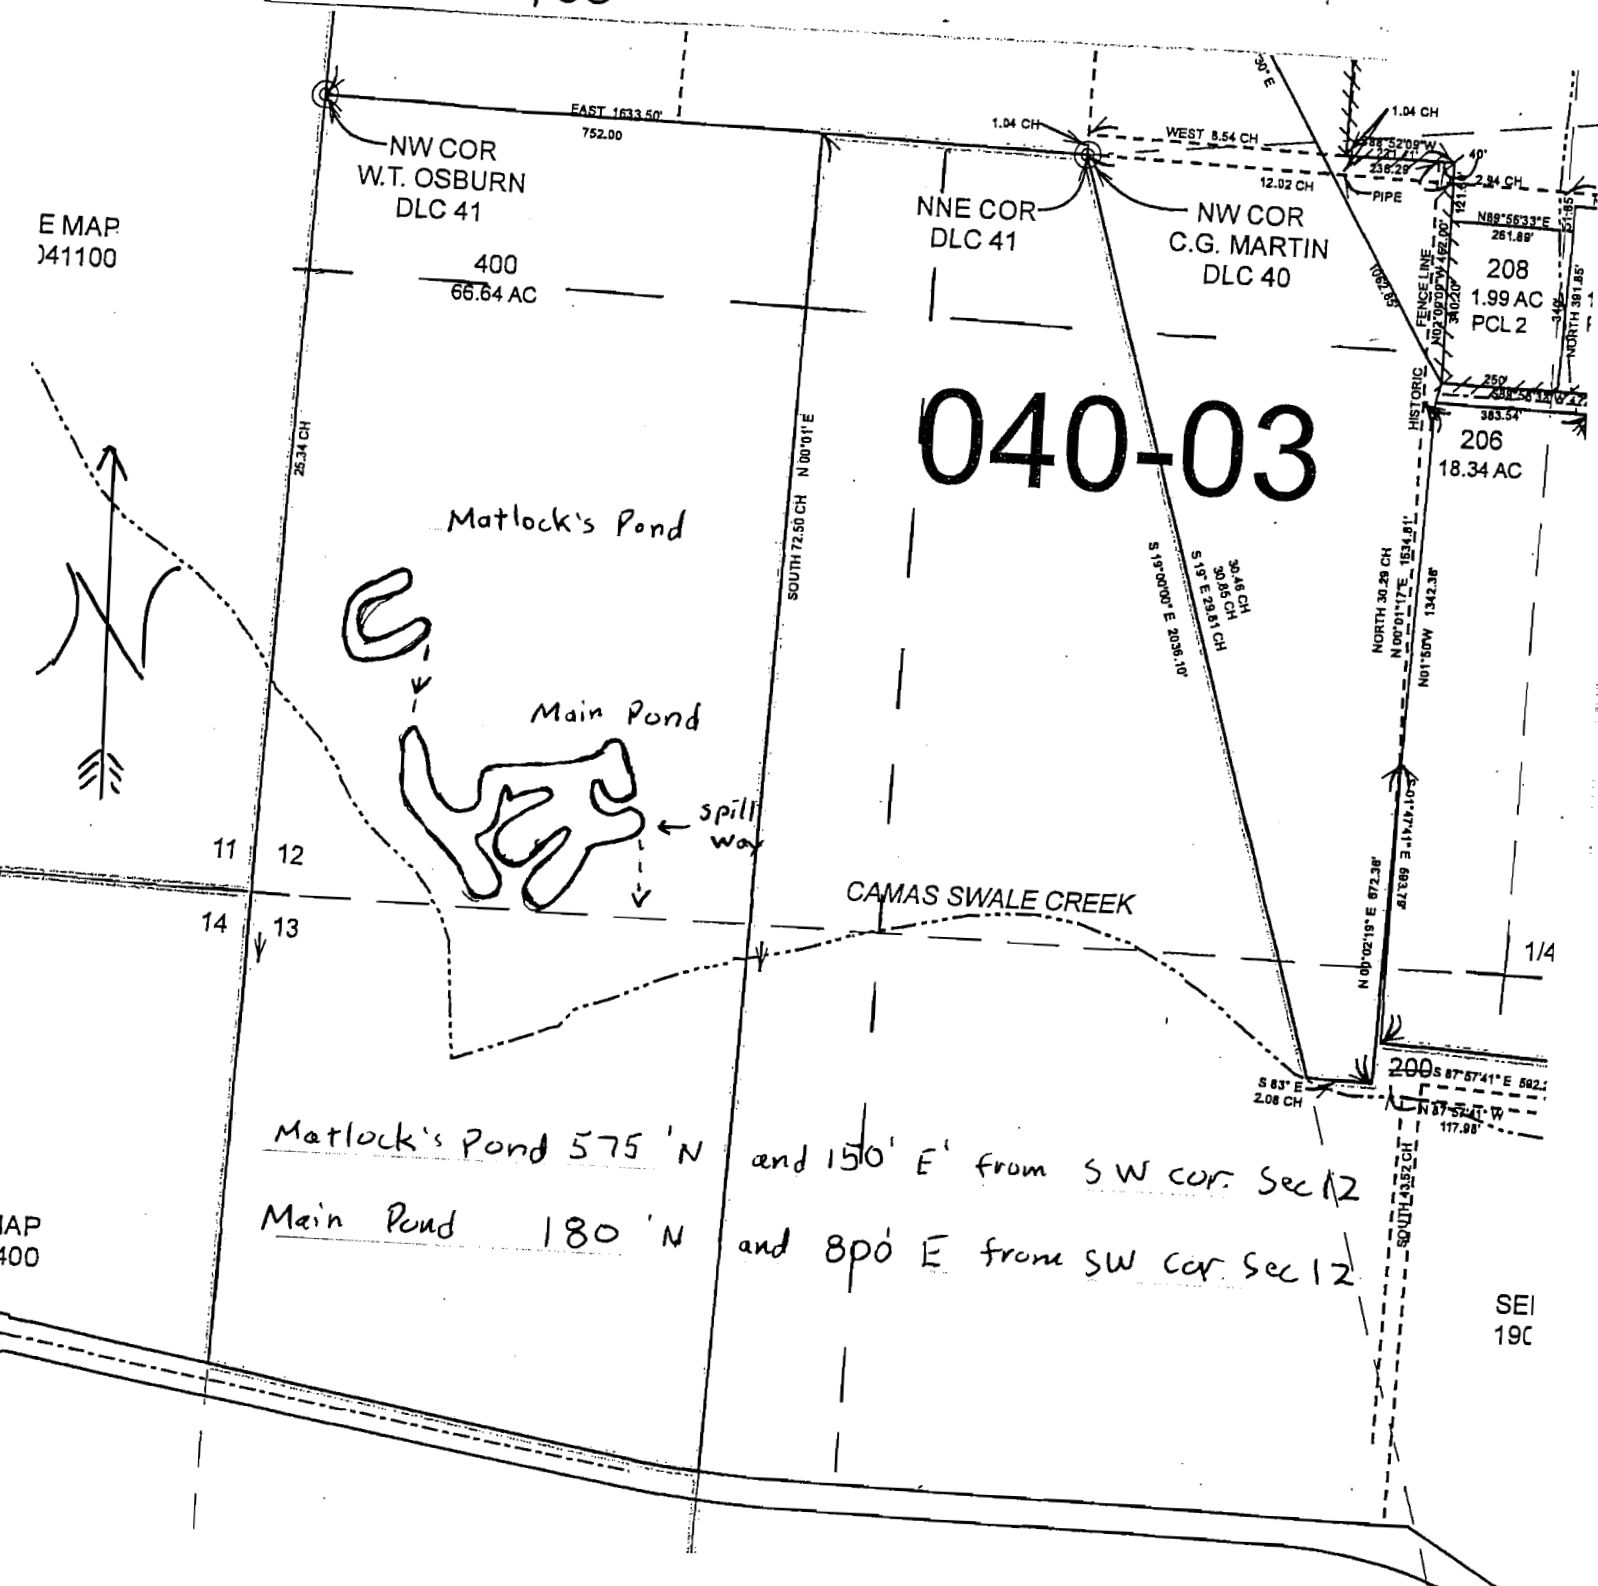

RECEIVED BY OWRD

DEC 30 2013

SALEM, OR

R- 87948