


Fitzgerald Ranches Inc.

T.36 S., R.24 E., W.M.

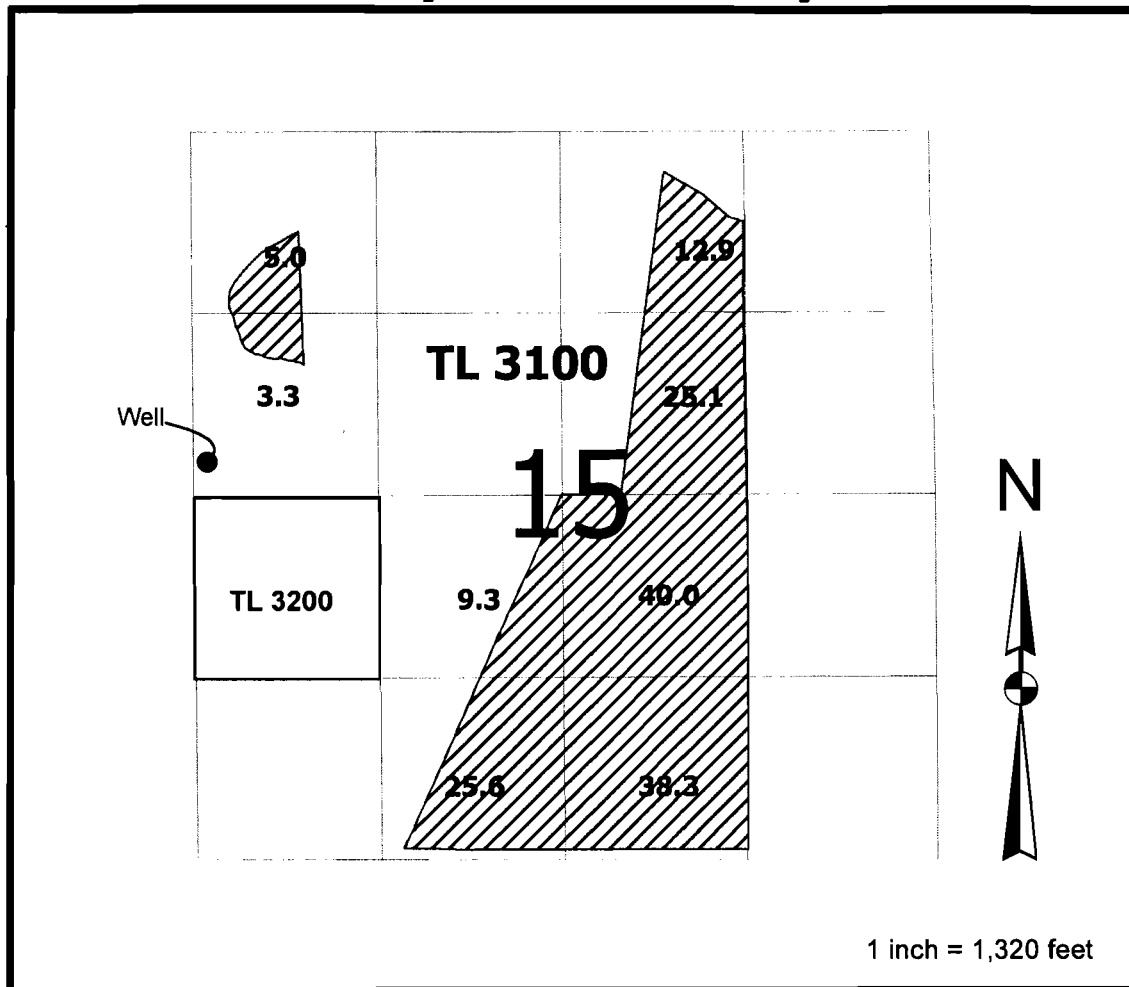

Well is located 2400 feet South and 72 feet East of the NW corner of Section 15

RECEIVED BY OWRD

JAN 10 2014

SALEM, OR