


SECTION PLAT

Section 20 Township 40S Range 36E

County of Harney State of Oregon

Ref corner is NW corner

NORTH

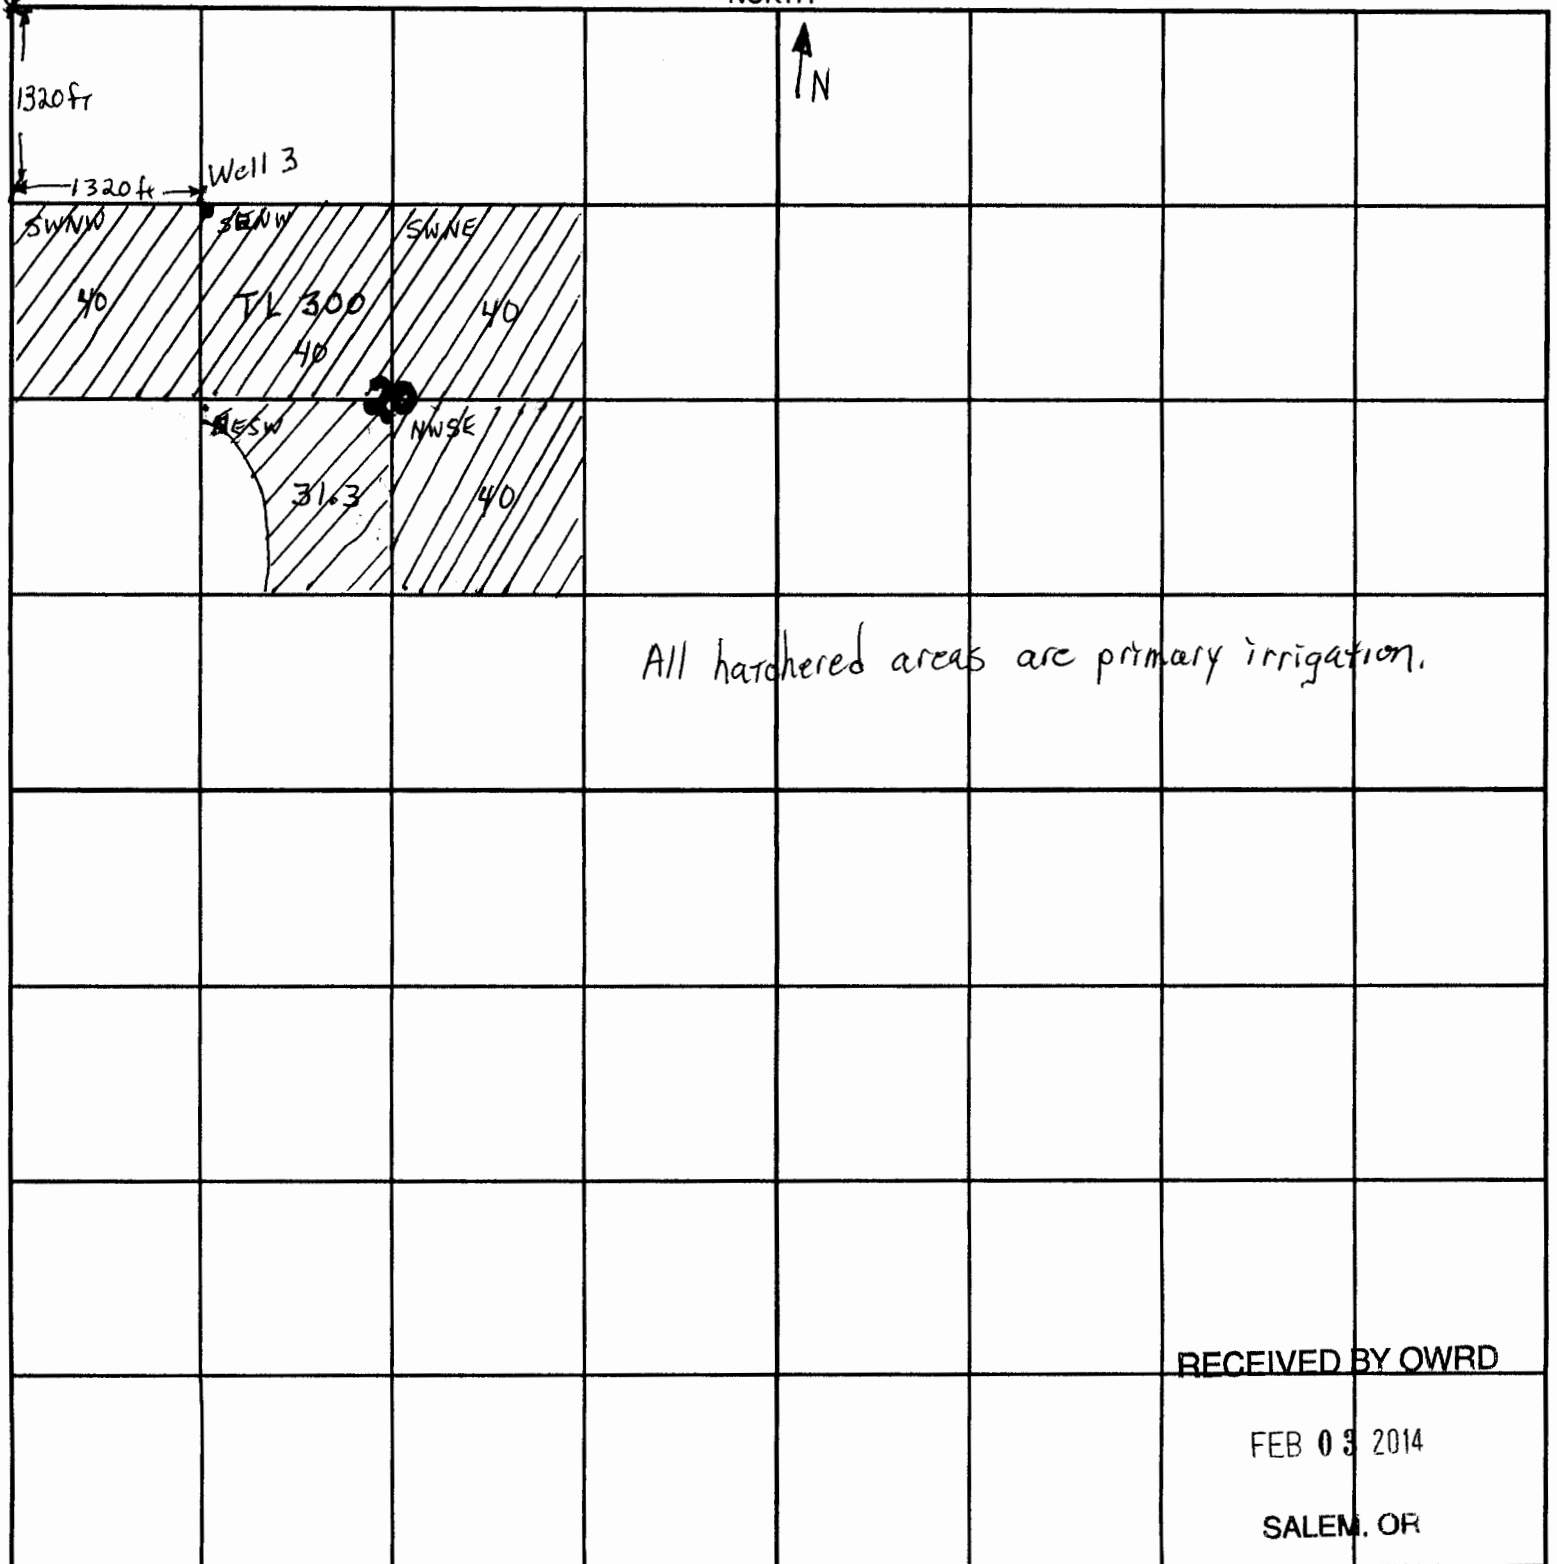

4"=1 mile