


NESE 1/4 T36S R5W Section 24

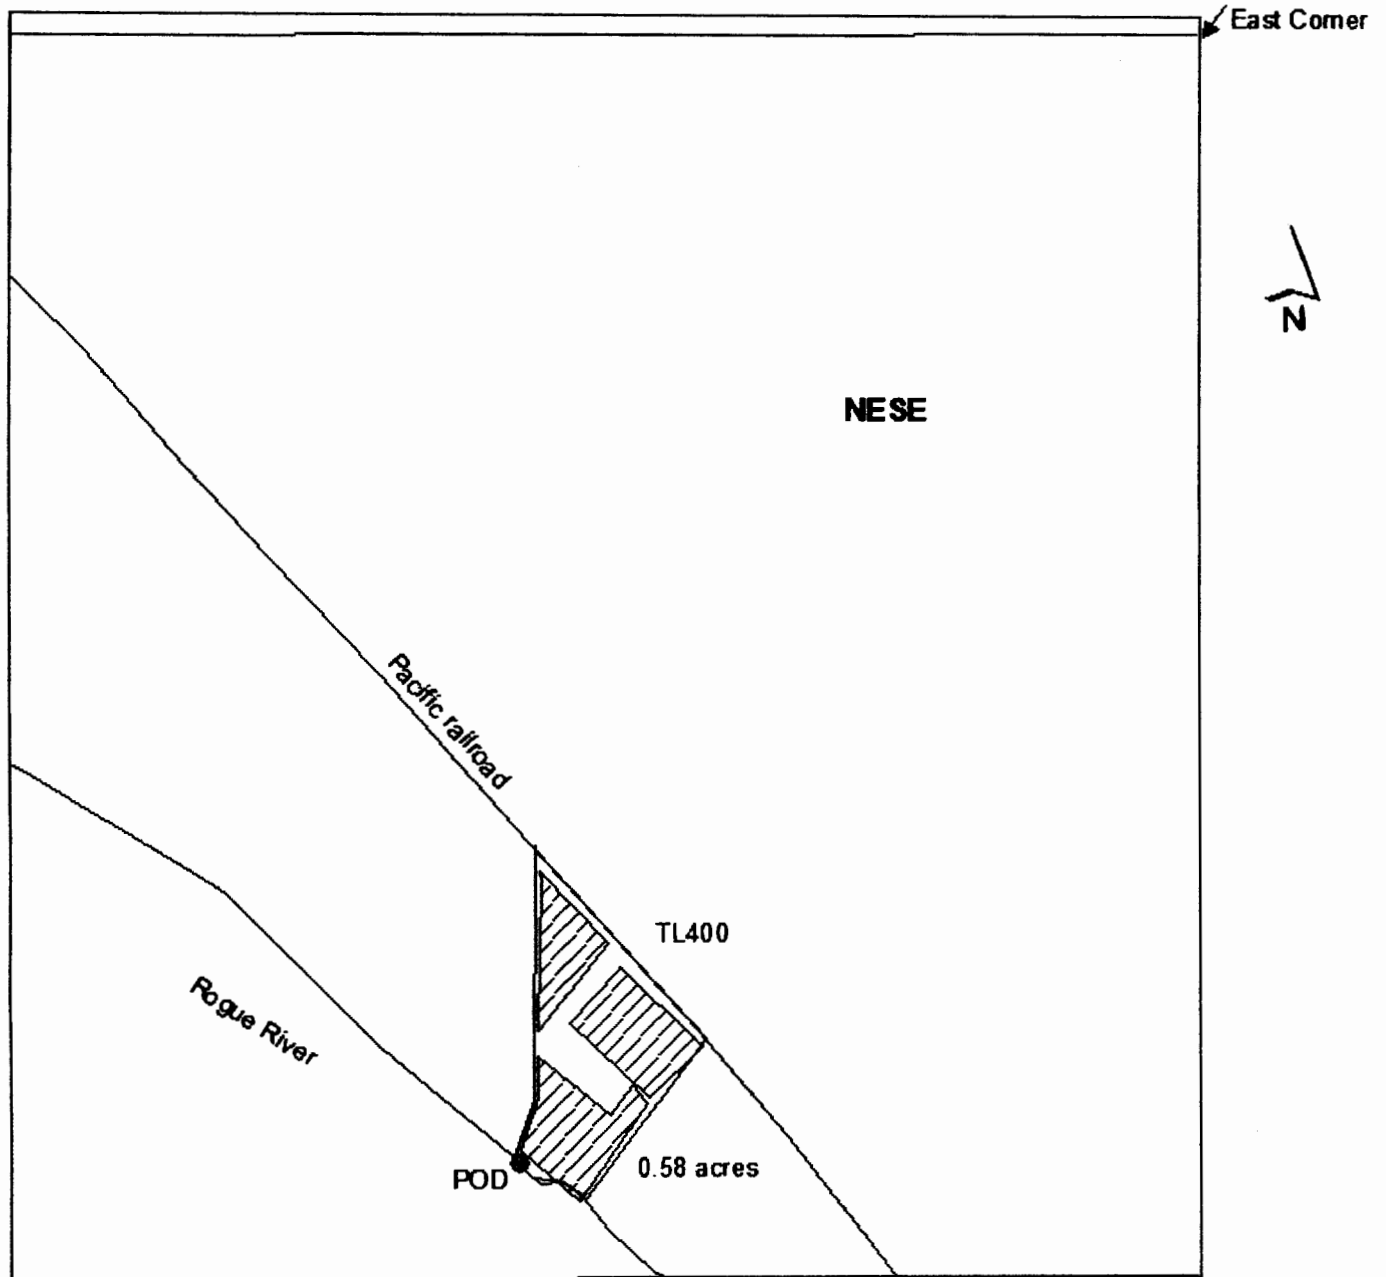

1 inch = 200 feet

POD is located 1201 ft south and 751 ft west from the east corner

RECEIVED BY OWRD

JAN 31 2014

SALEM, OR