


NOTE:  
SHADED AREA  
IS THE CITY OF  
BANKS SERVICE AREA

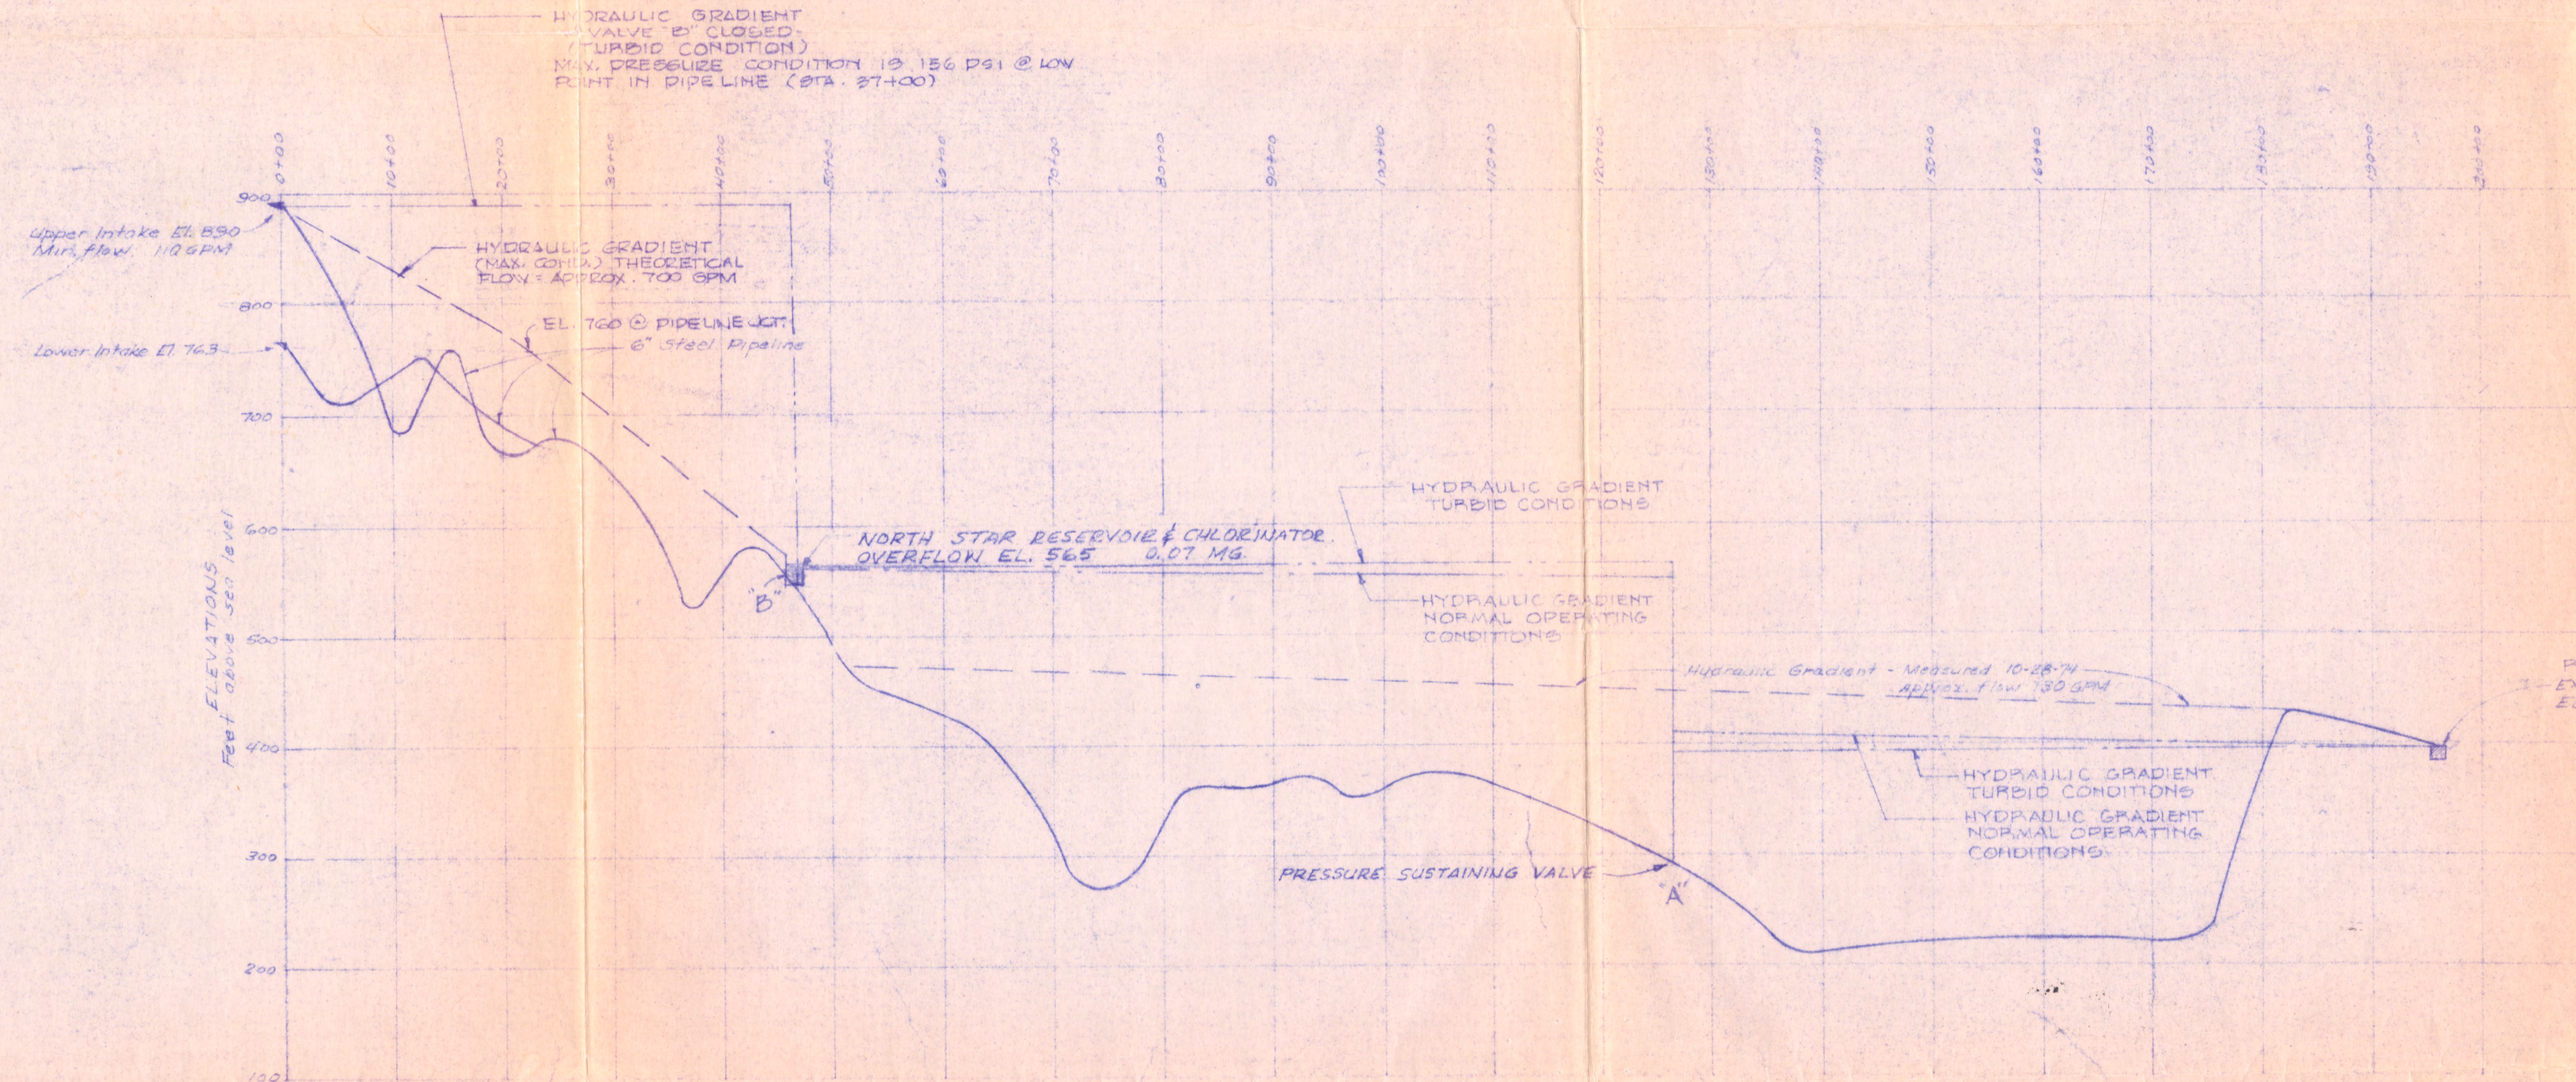

**WATER RIGHTS**  
File 9207  
Certificate No. 5353  
Priority Date - October 3, 1923  
Source - Springs  
Location - SE 1/4 NE 1/4, Sect. 12, T2N, R4W W.M.  
Quantity - 0.42 CFS.

**PROPERTY RIGHTS**  
Location Date Area  
5/4 of SE 1/4 NE 1/4, T2N, R4W 158/448 8/2/1935 20 Ac.  
NW 1/4 SW 1/4, T2N, R4W 264/147 7/15/1946 40 Ac.  
N 1/4 of NE 1/4 SW 1/4, T2N, R4W 264/147 7/15/1946 20 Ac.  
SE 1/4 of SW 1/4, T2N, R4W 264/145 8/15/1946 40 Ac.  
Less part of SE 1/4 SW 1/4, T 388/150 10/11/1935 5.2 Ac. ±

Reservoir Site Watershed ownership 116.8 Ac. ±  
SW 1/4 of 30, T2N, R4W (125 x 125) 132/241 1/12/1926 0.86 Ac. (C.R.)

RESERVOIR NO. 1  
EXISTING 0.2 MG DIST. RESERVOIR  
EL. 895

**RECEIVED**  
AUG 26 1993  
WATER RESOURCES DEPT.  
SALEM, OREGON

Application No. 65611  
Permit No. 48173

DATE	NO.	REVISION	BY
8-3-83	3	UPDATE PER 1981 AREA ANNEXATION	AK
1-28-81	2	ADDED NEW HYD. GR. & NOTES, RES. #2, REMOVED NOTES DE	DB
8-12-80	1	ADDED HYD. GRAD. PLANT SITE NOTES & FROE TREATMENT	DM

DESIGNED: DMK  
DRAWN: AK  
CHECKED: DB  
APPROVED: [Signature]  
SCALE: HORIZ. 1"=1000' VERT. 1"=100'  
DATE: OCT 1974  
FILE: [Blank]

**KLEIN CONSULTING ENGINEERS**  
CIVIL ENGINEERS - PLANNERS  
FOREST GROVE, OREGON

CITY OF BANKS, ORE.

PLAN AND PROFILE  
WATER SUPPLY SYSTEM

SHEET  
1