


James Lake
Rt. 2 Box 402
Eugene, Oregon

Scale 1" equals 660'

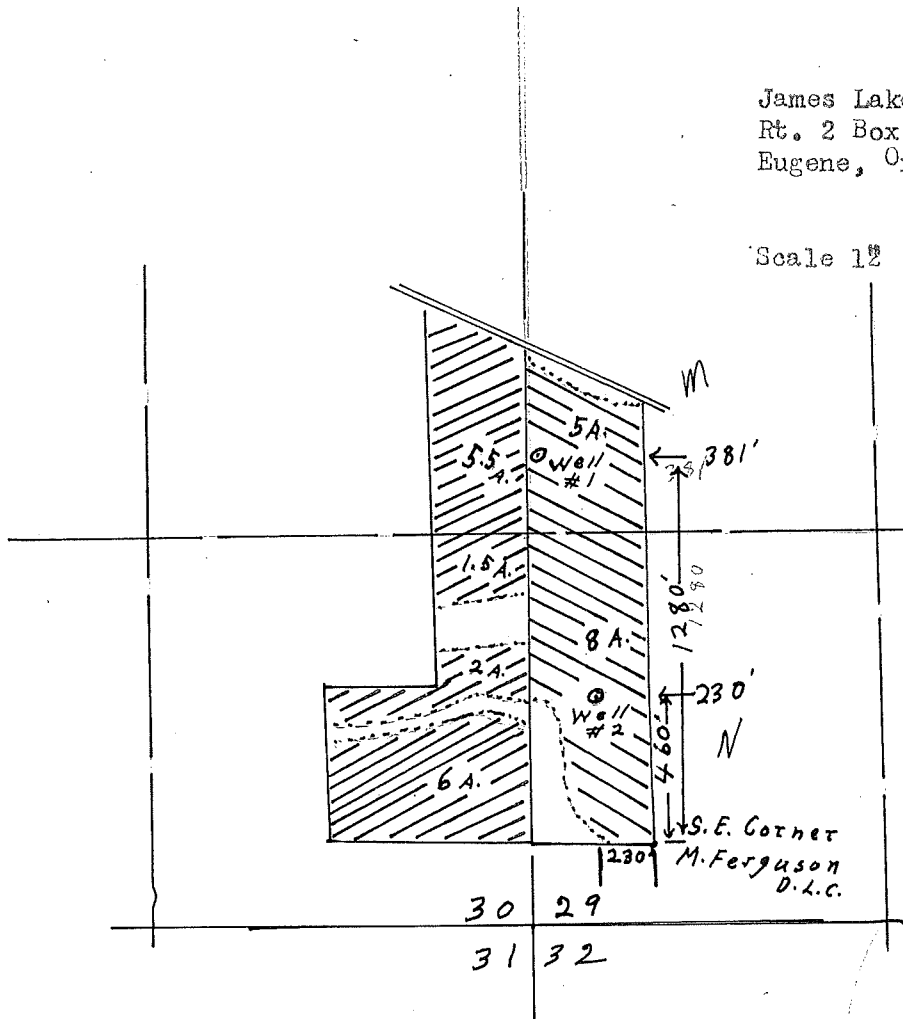

Township 16 South Range 3W WM

GR3458

Note: Wells that are being registared on located on my property. Ajoining ground that is being irrigated is leased ground.