


RECEIVED

MAR 23 2015


WATER RESOURCES DEPT
SALEM, OREGON

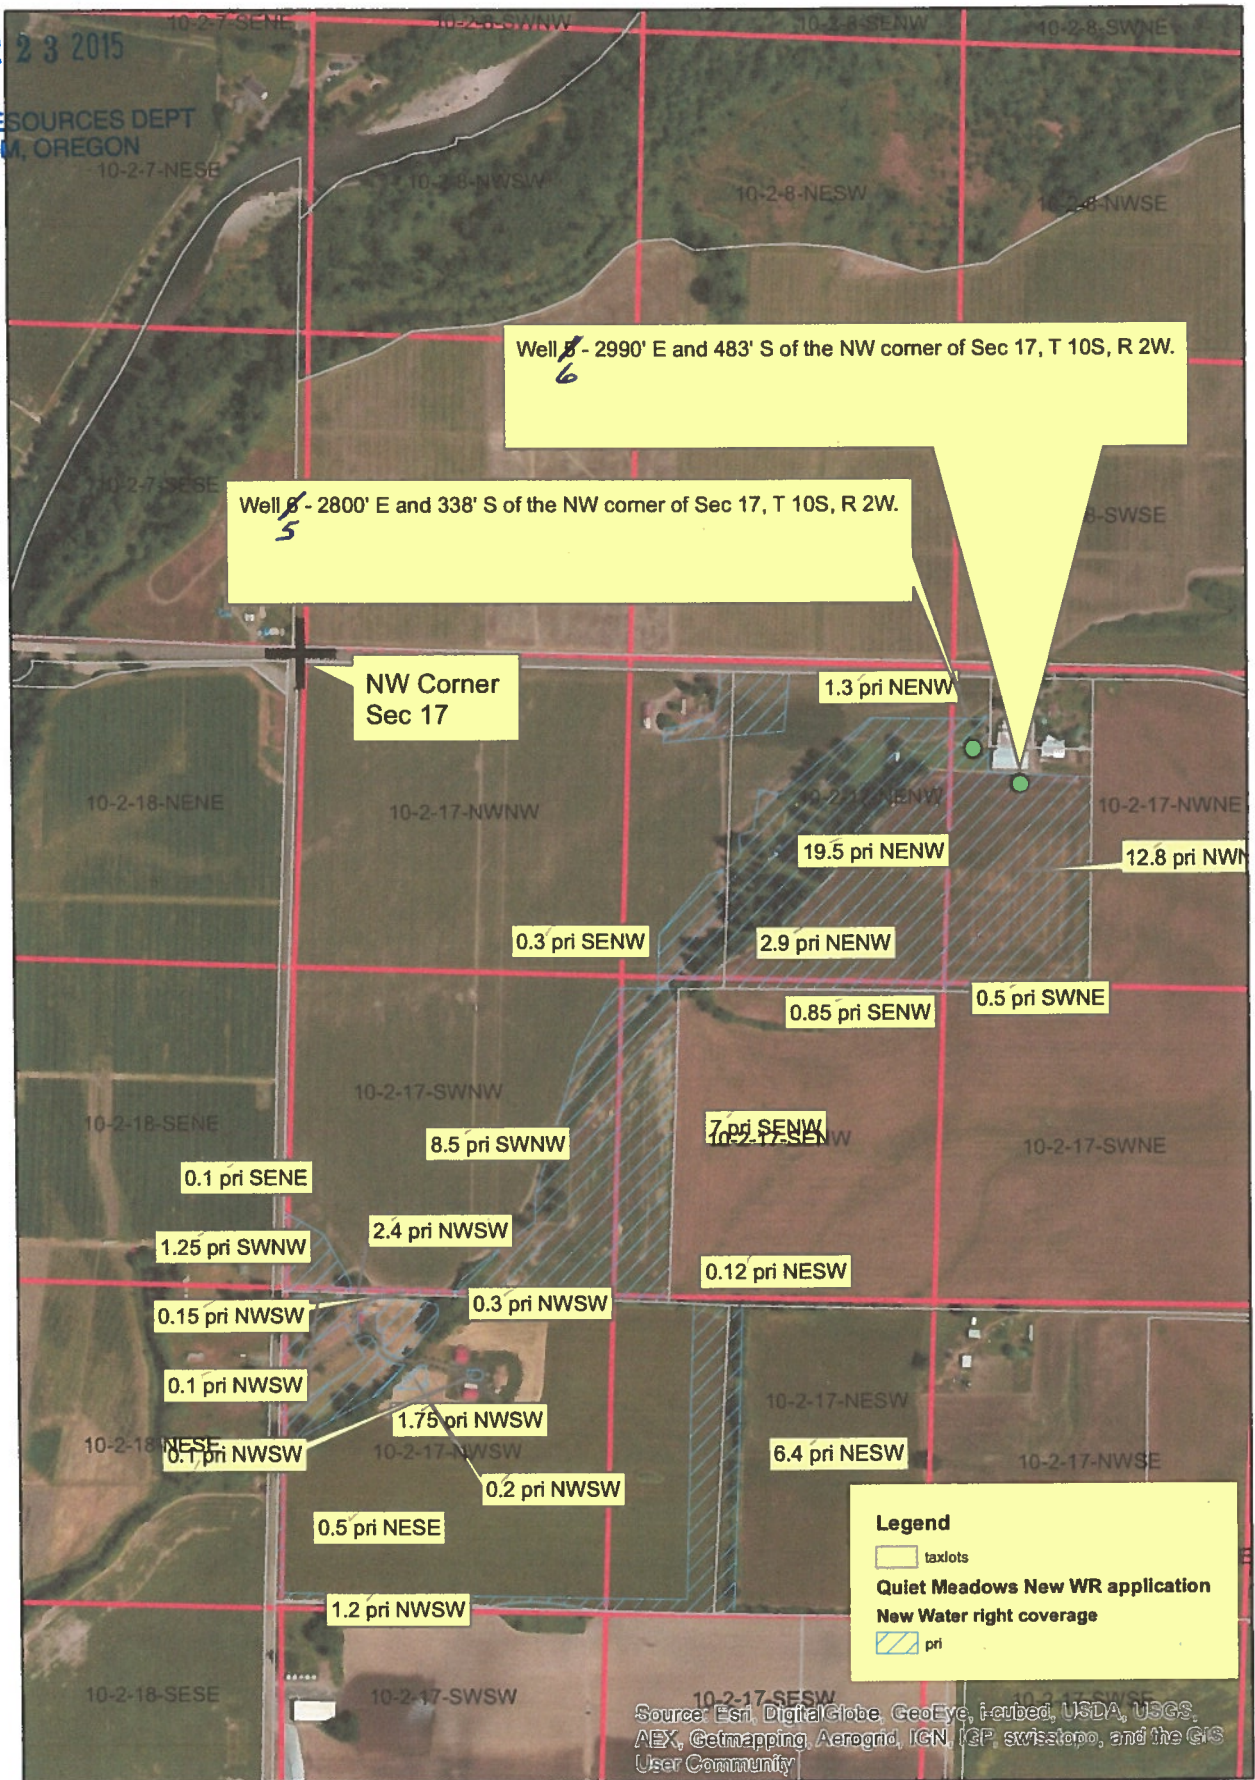

Map prepared by Brent Stevenson



T.10S. R.2W. W.M.

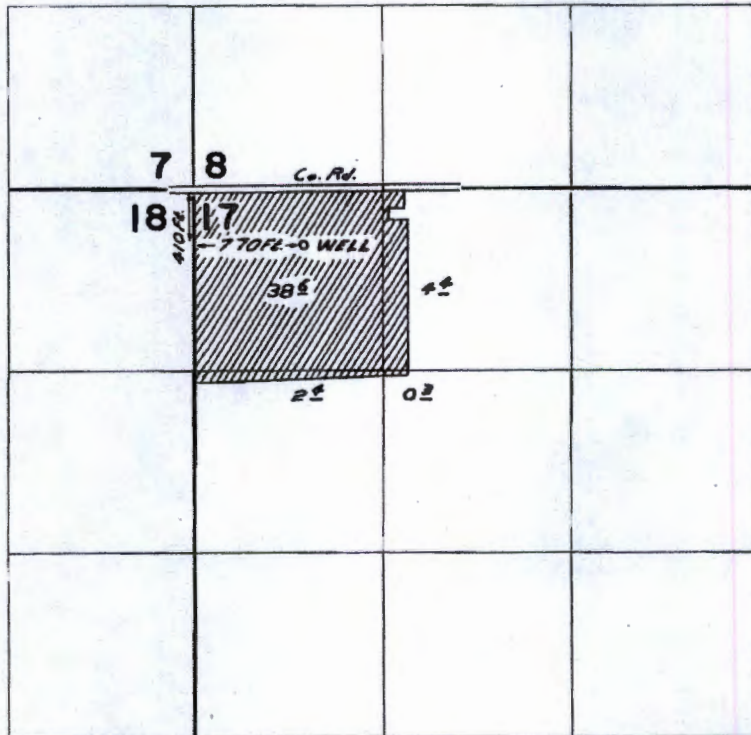

RECEIVED

MAR 07 2014

WATER RESOURCES DEPT
SALEM, OREGON

**FINAL PROOF SURVEY
UNDER**

Application No. G-2272 Permit No. G-2804
IN NAME OF

MRS. TESSA WATKINS

Surveyed SEPT 9 1965, by L. COLEBANK

1965-V 34

G-47780