



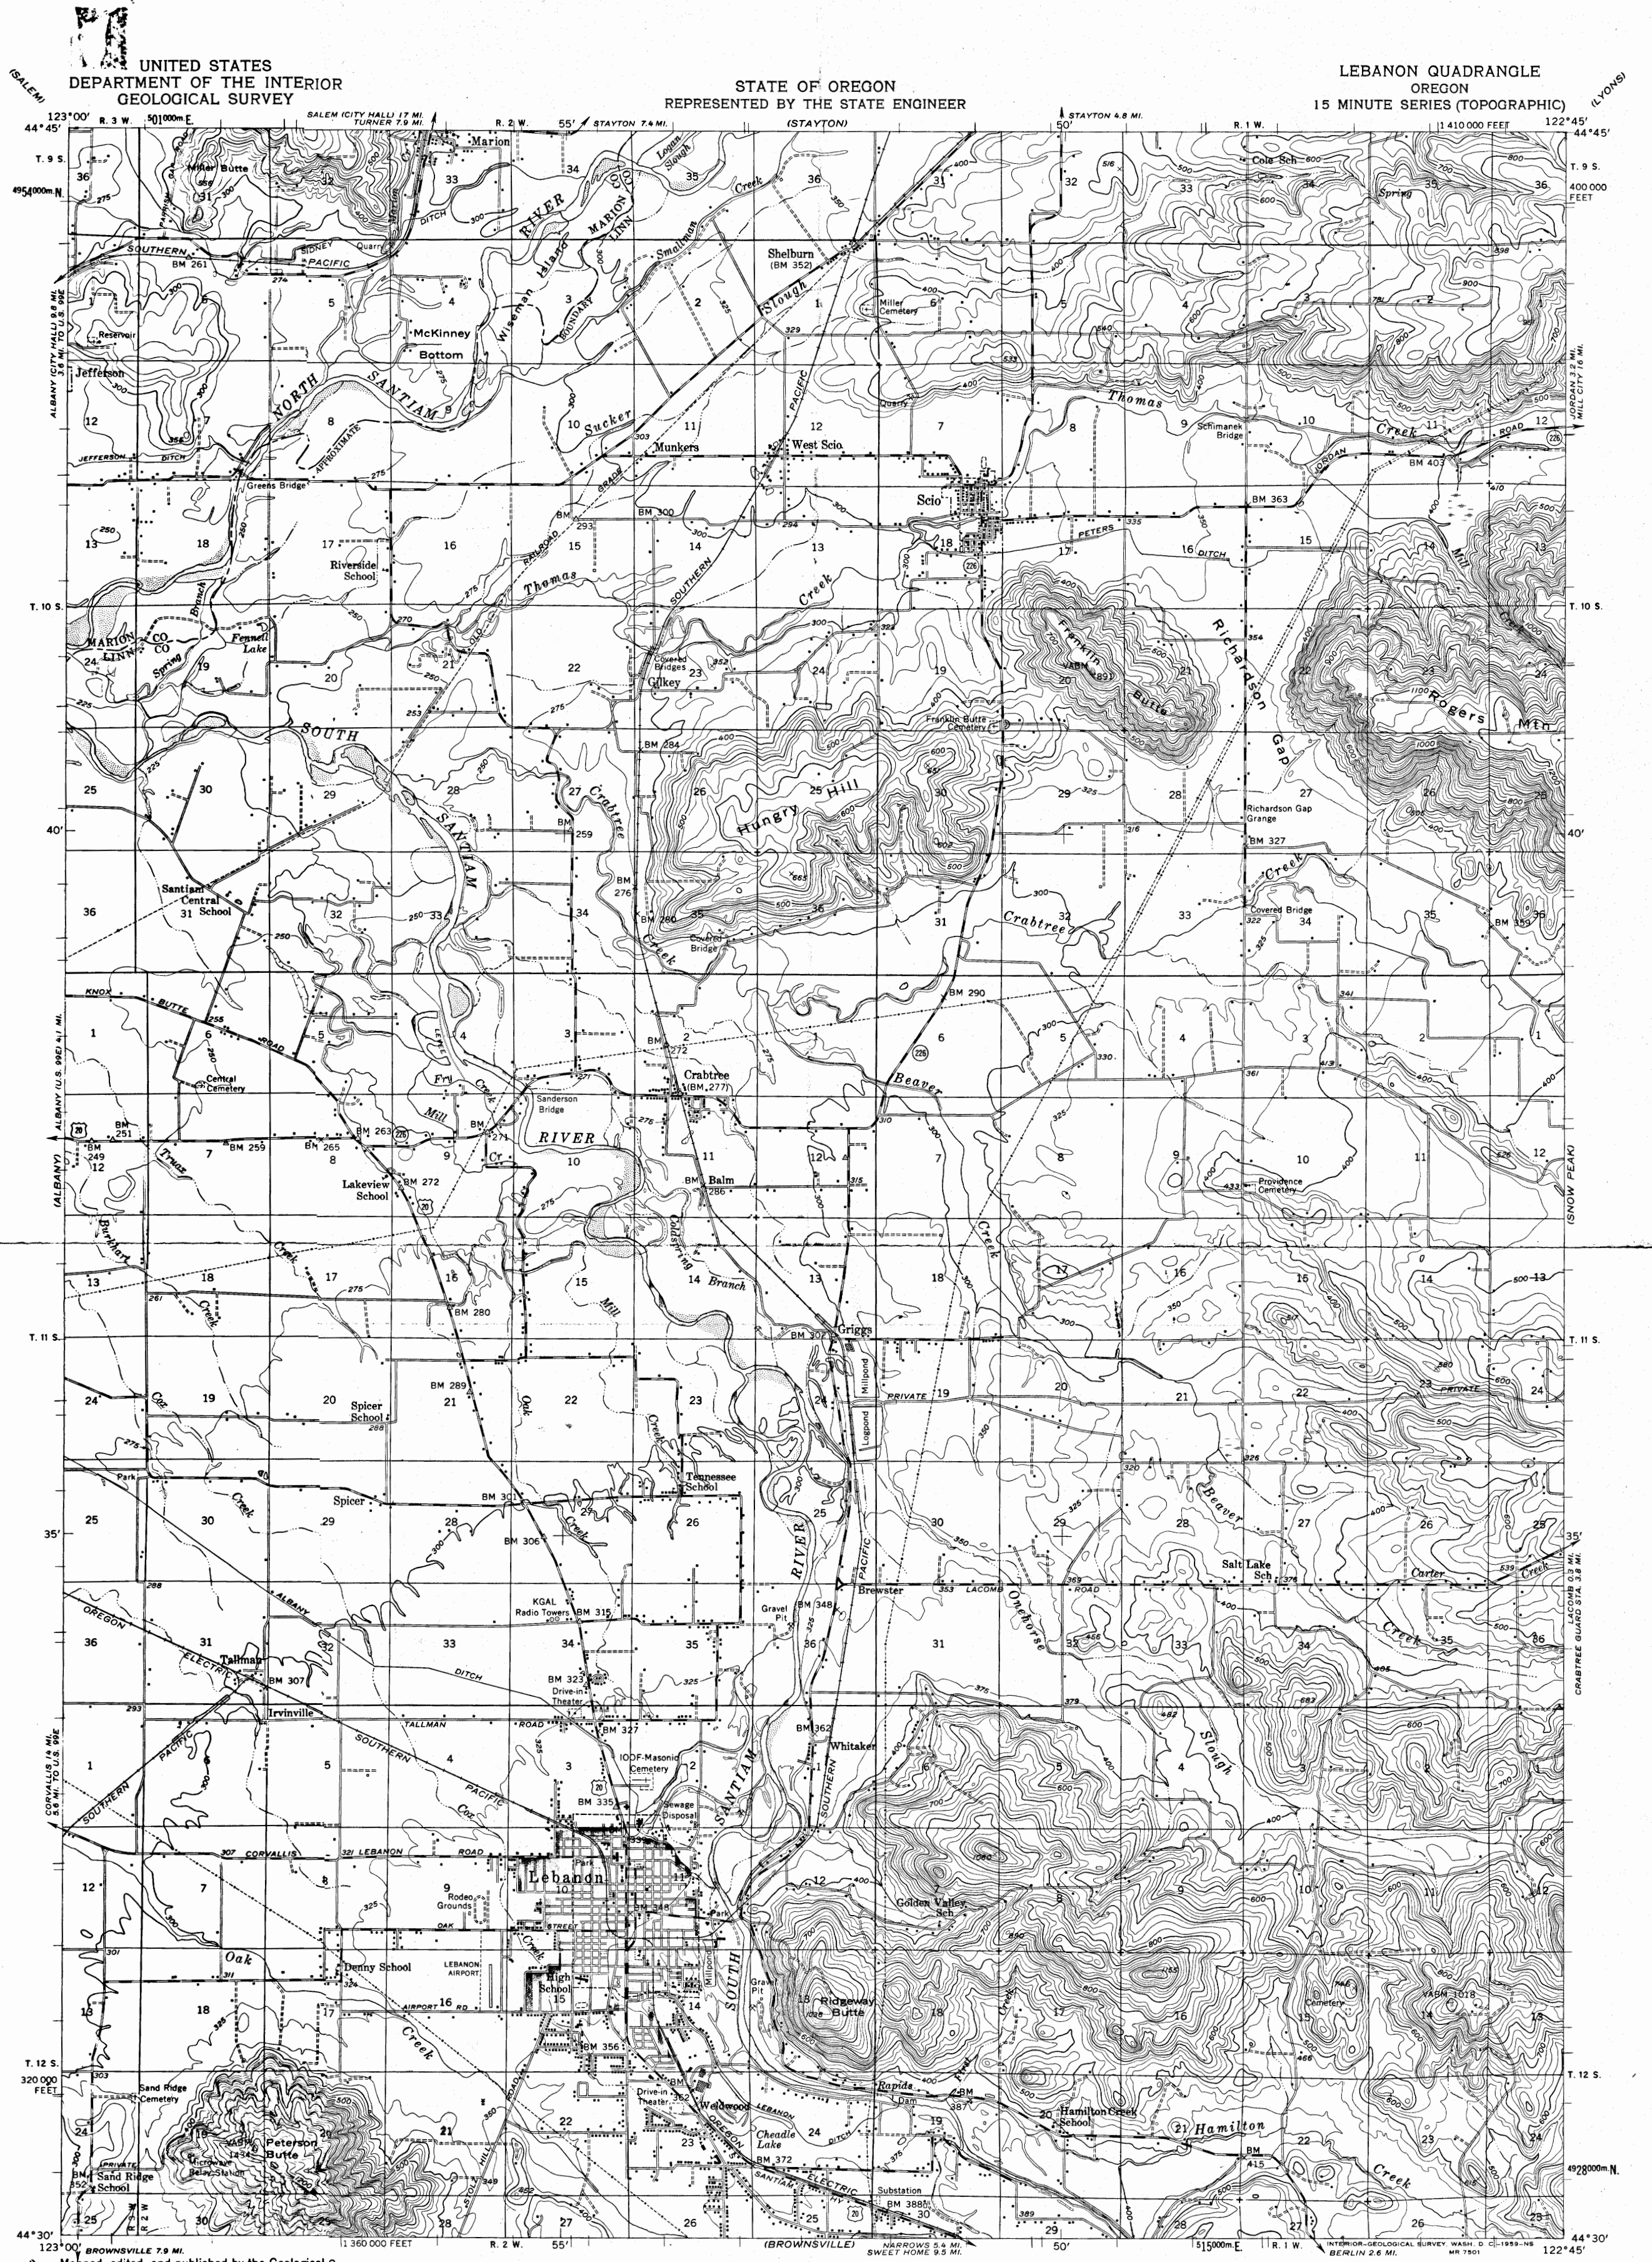

UNITED STATES
DEPARTMENT OF THE INTERIOR
GEOLOGICAL SURVEY

STATE OF OREGON
REPRESENTED BY THE STATE ENGINEER


LEBANON QUADRANGLE
OREGON
15 MINUTE SERIES (TOPOGRAPHIC)

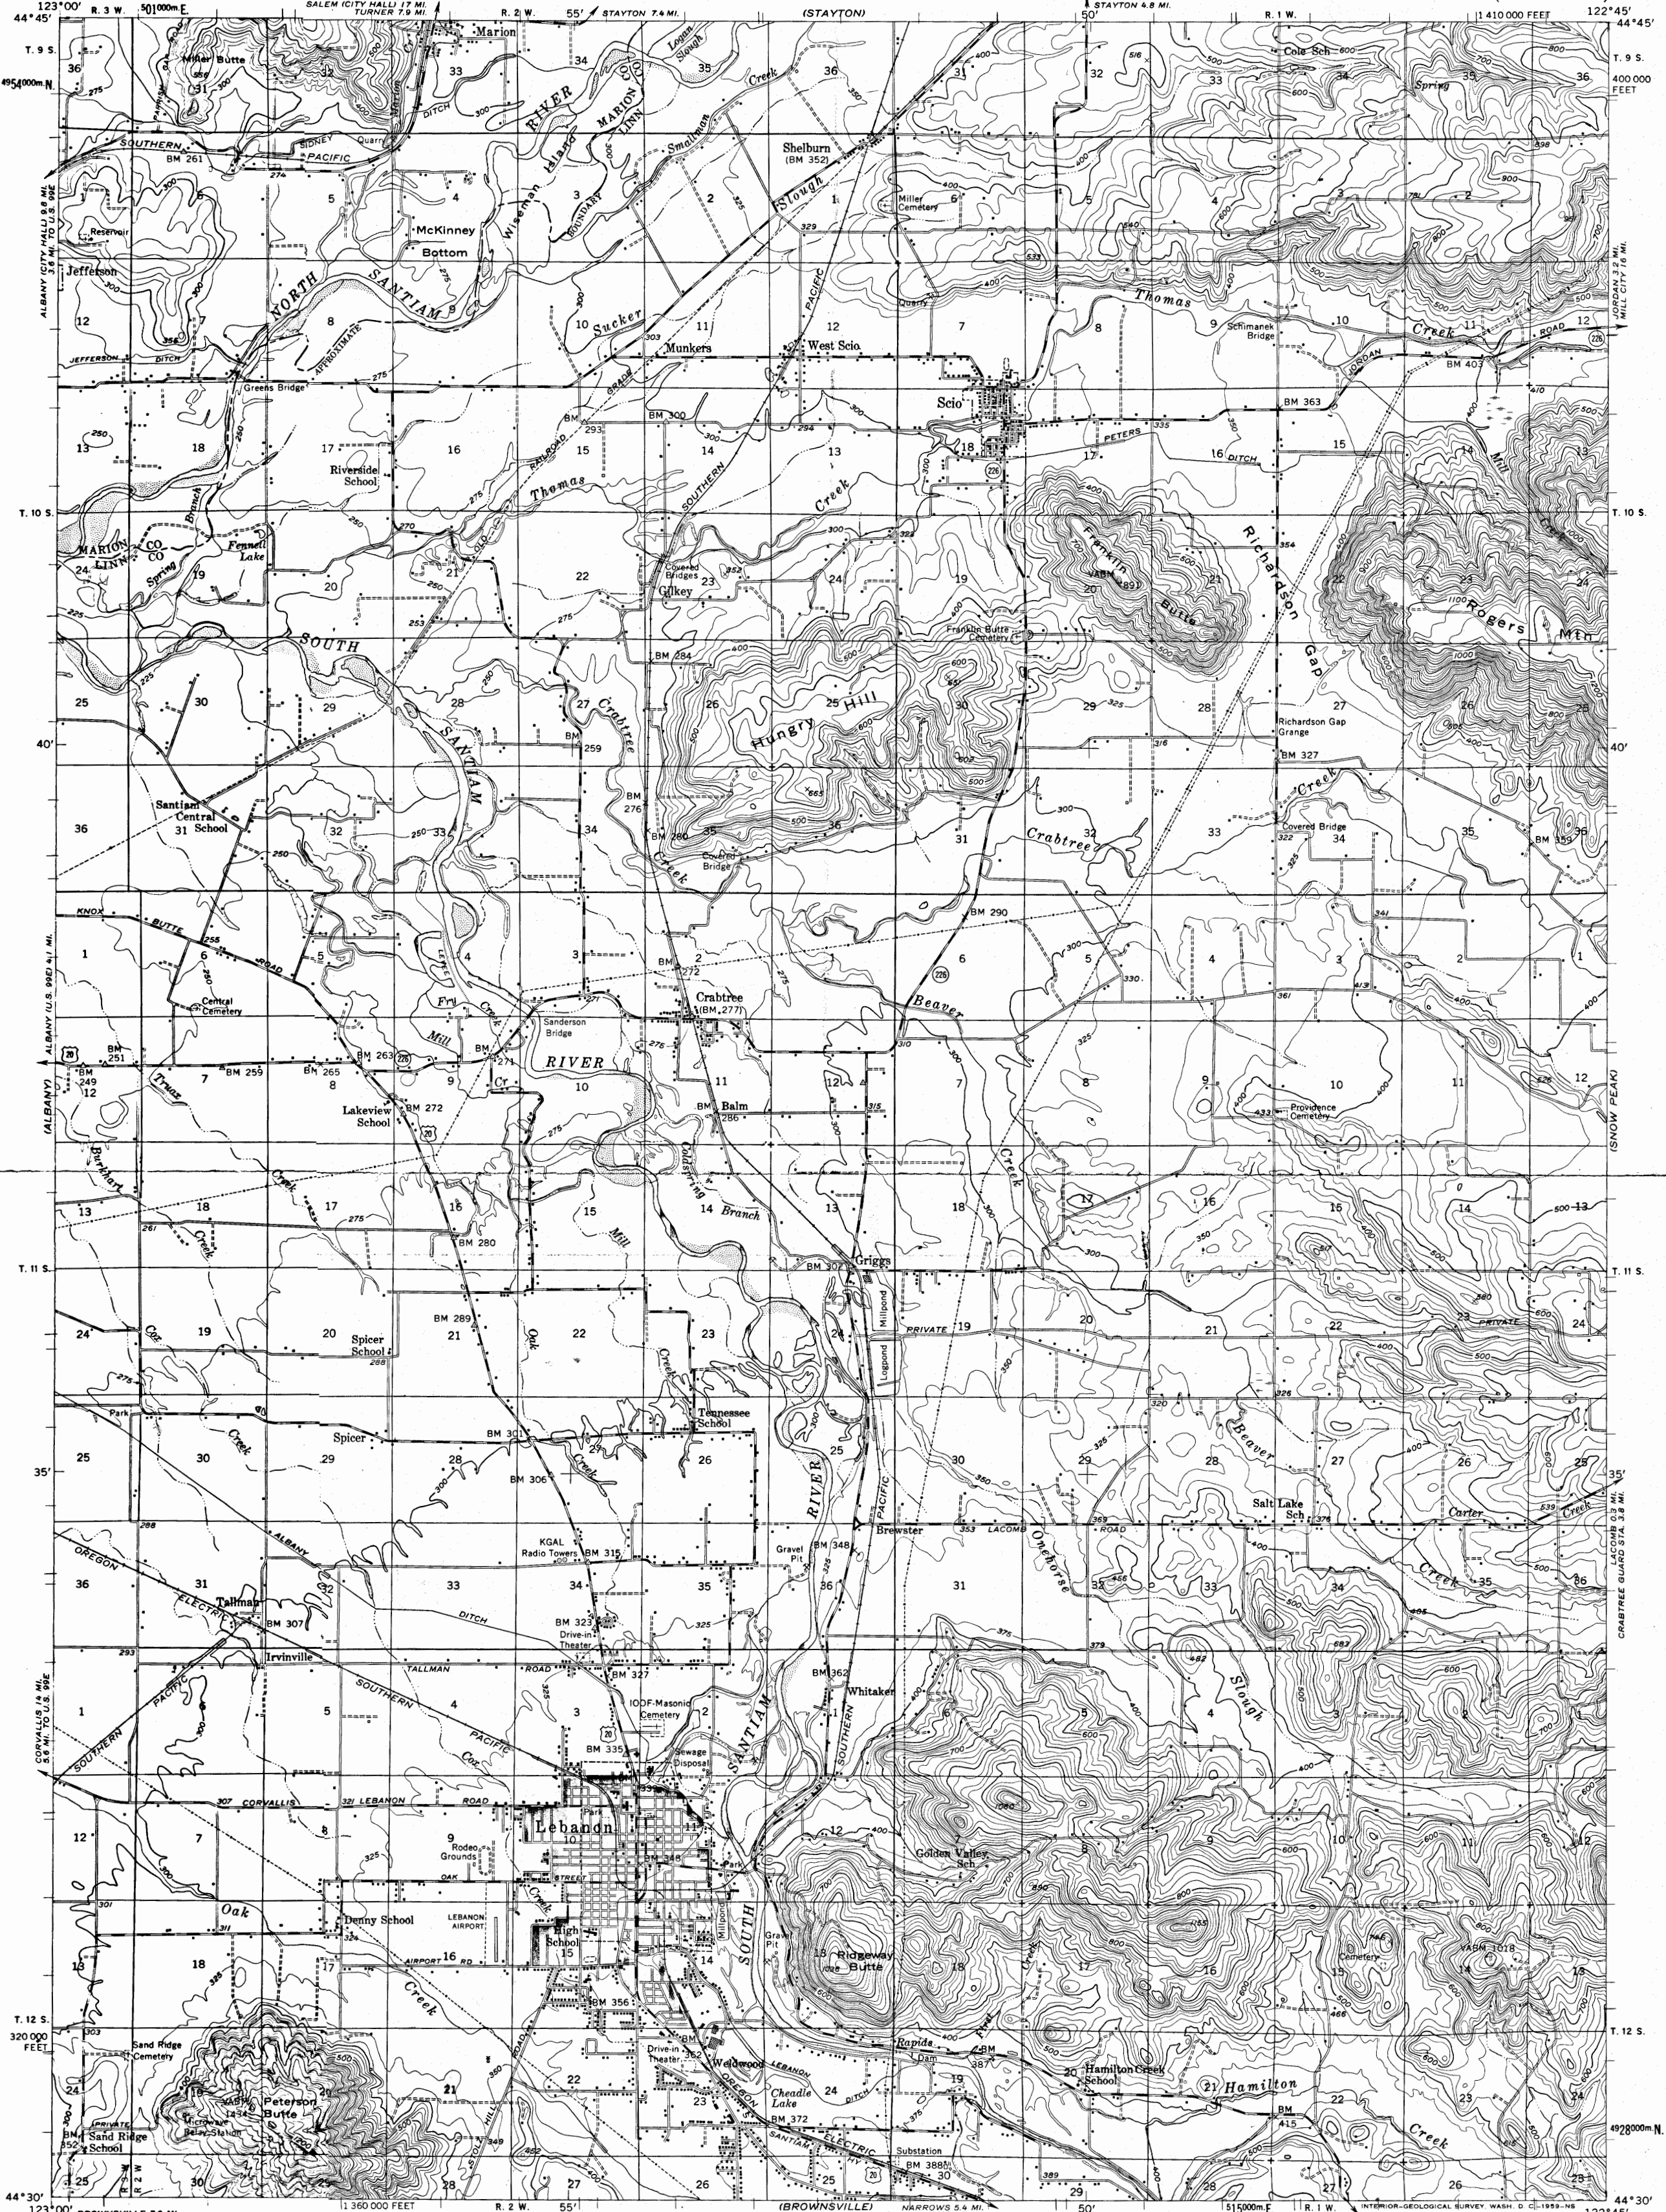

Maped, edited, and published by the Geological Survey
Control by USGS, USC&GS, and USCE
Topography by planetable surveys 1911, 1914, and 1922
Cultivated areas from aerial photographs taken 1954
Field work 1957

Projection: 1927 North American datum
Grid based on Oregon coordinate system, north zone
1000-meters Universal Transverse Mercator grid ticks,
zone 10, shown in blue

Red tint indicates area in which only
landmark buildings are shown

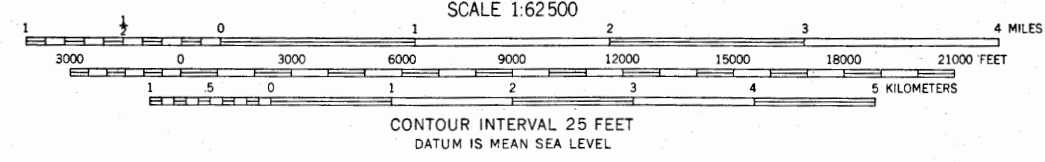

ROAD CLASSIFICATION
Medium-duty ——— Light-duty ———
Unimproved dirt ———
U. S. Route ——— State Route ———



LEBANON, OREG.
N4430-W12245/15


FOR SALE BY U. S. GEOLOGICAL SURVEY, DENVER 25, COLORADO OR WASHINGTON 25, D. C.
A FOLDER DESCRIBING TOPOGRAPHIC MAPS AND SYMBOLS IS AVAILABLE ON REQUEST

1957


UNITED STATES
DEPARTMENT OF THE INTERIOR
GEOLOGICAL SURVEY

STATE OF OREGON
REPRESENTED BY THE STATE ENGINEER
(STAYTON)

LEBANON QUADRANGLE
OREGON
15 MINUTE SERIES (TOPOGRAPHIC)

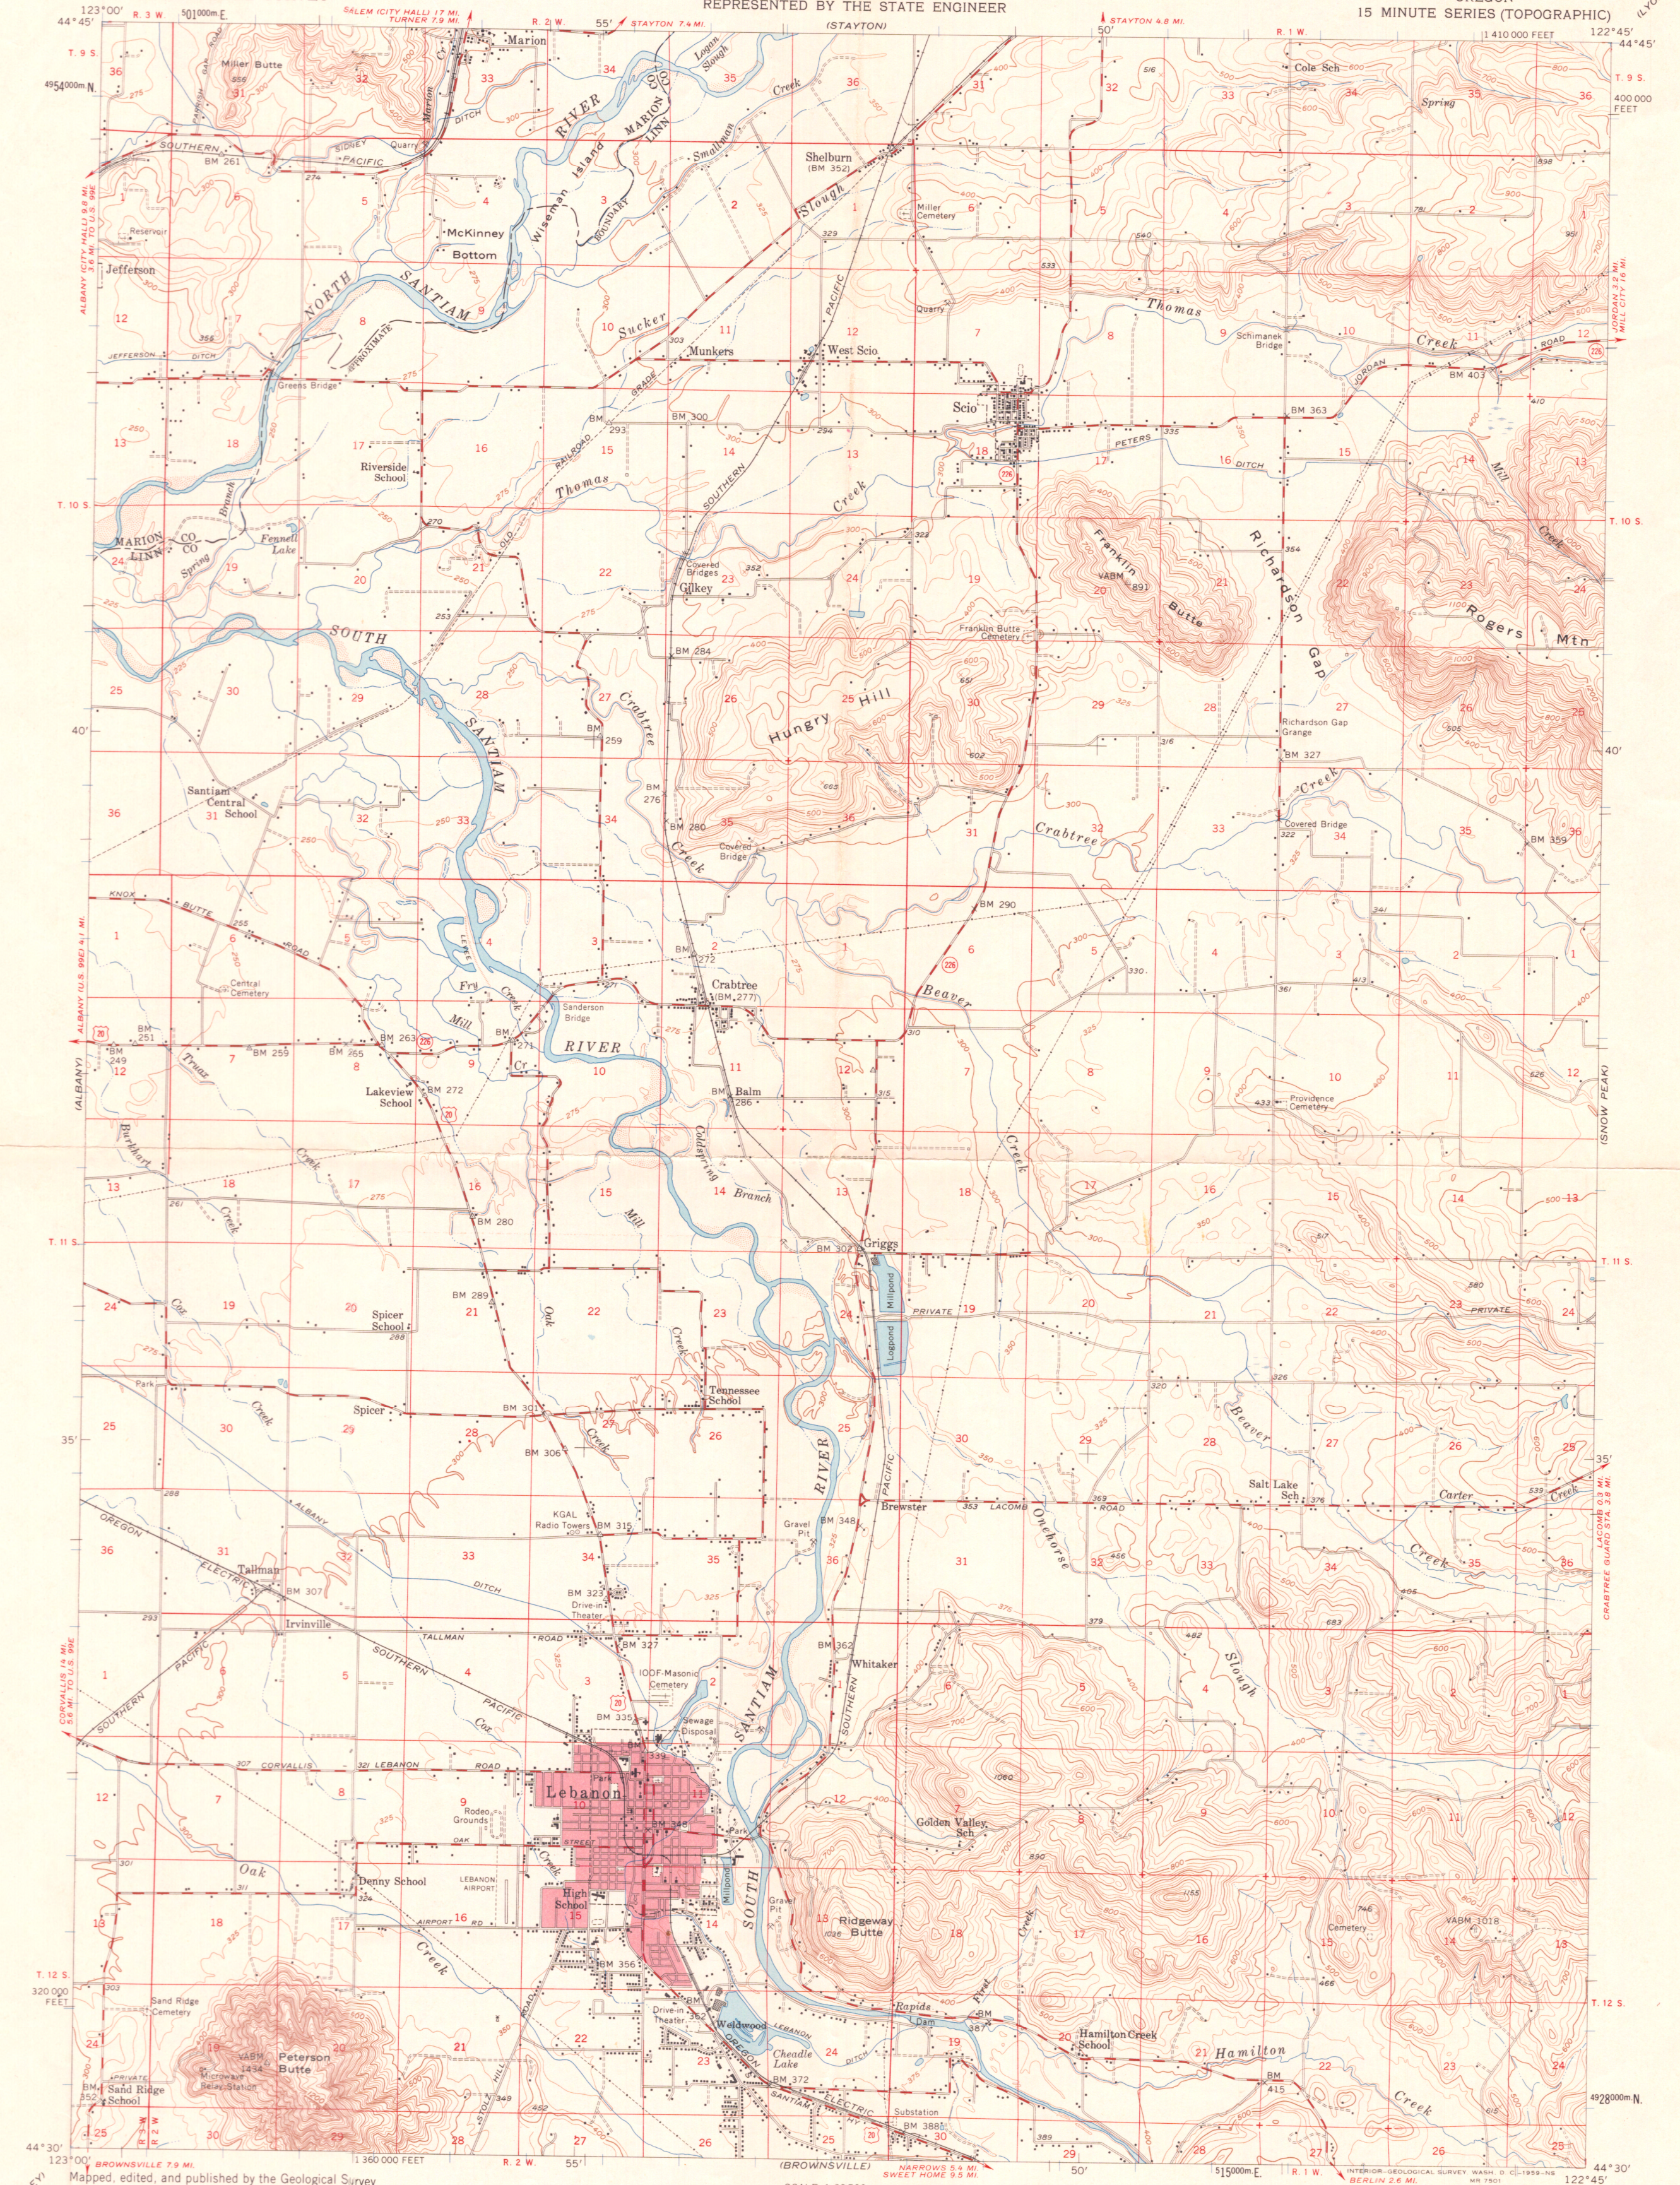


Maped, edited, and published by the Geological Survey
Control by USGS, USC&GS, and USCE
Topography by planetary surveys 1911, 1914, and 1922
Cultivated from aerial photographs taken 1954
Field 1957
Polyconic projection. 1927 North American datum
10,000-ft. grid based on Oregon coordinate system, north zone
1000-me. Universal Transverse Mercator grid ticks,
zone 10, shown in blue
Red tint indicates area in which only
landmark buildings are shown

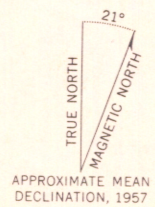

FOR SALE BY U. S. GEOLOGICAL SURVEY, DENVER 25, COLORADO OR WASHINGTON 25, D. C.
A FOLDER DESCRIBING TOPOGRAPHIC MAPS AND SYMBOLS IS AVAILABLE ON REQUEST



LEBANON, OREG.
N4430-W12245/15

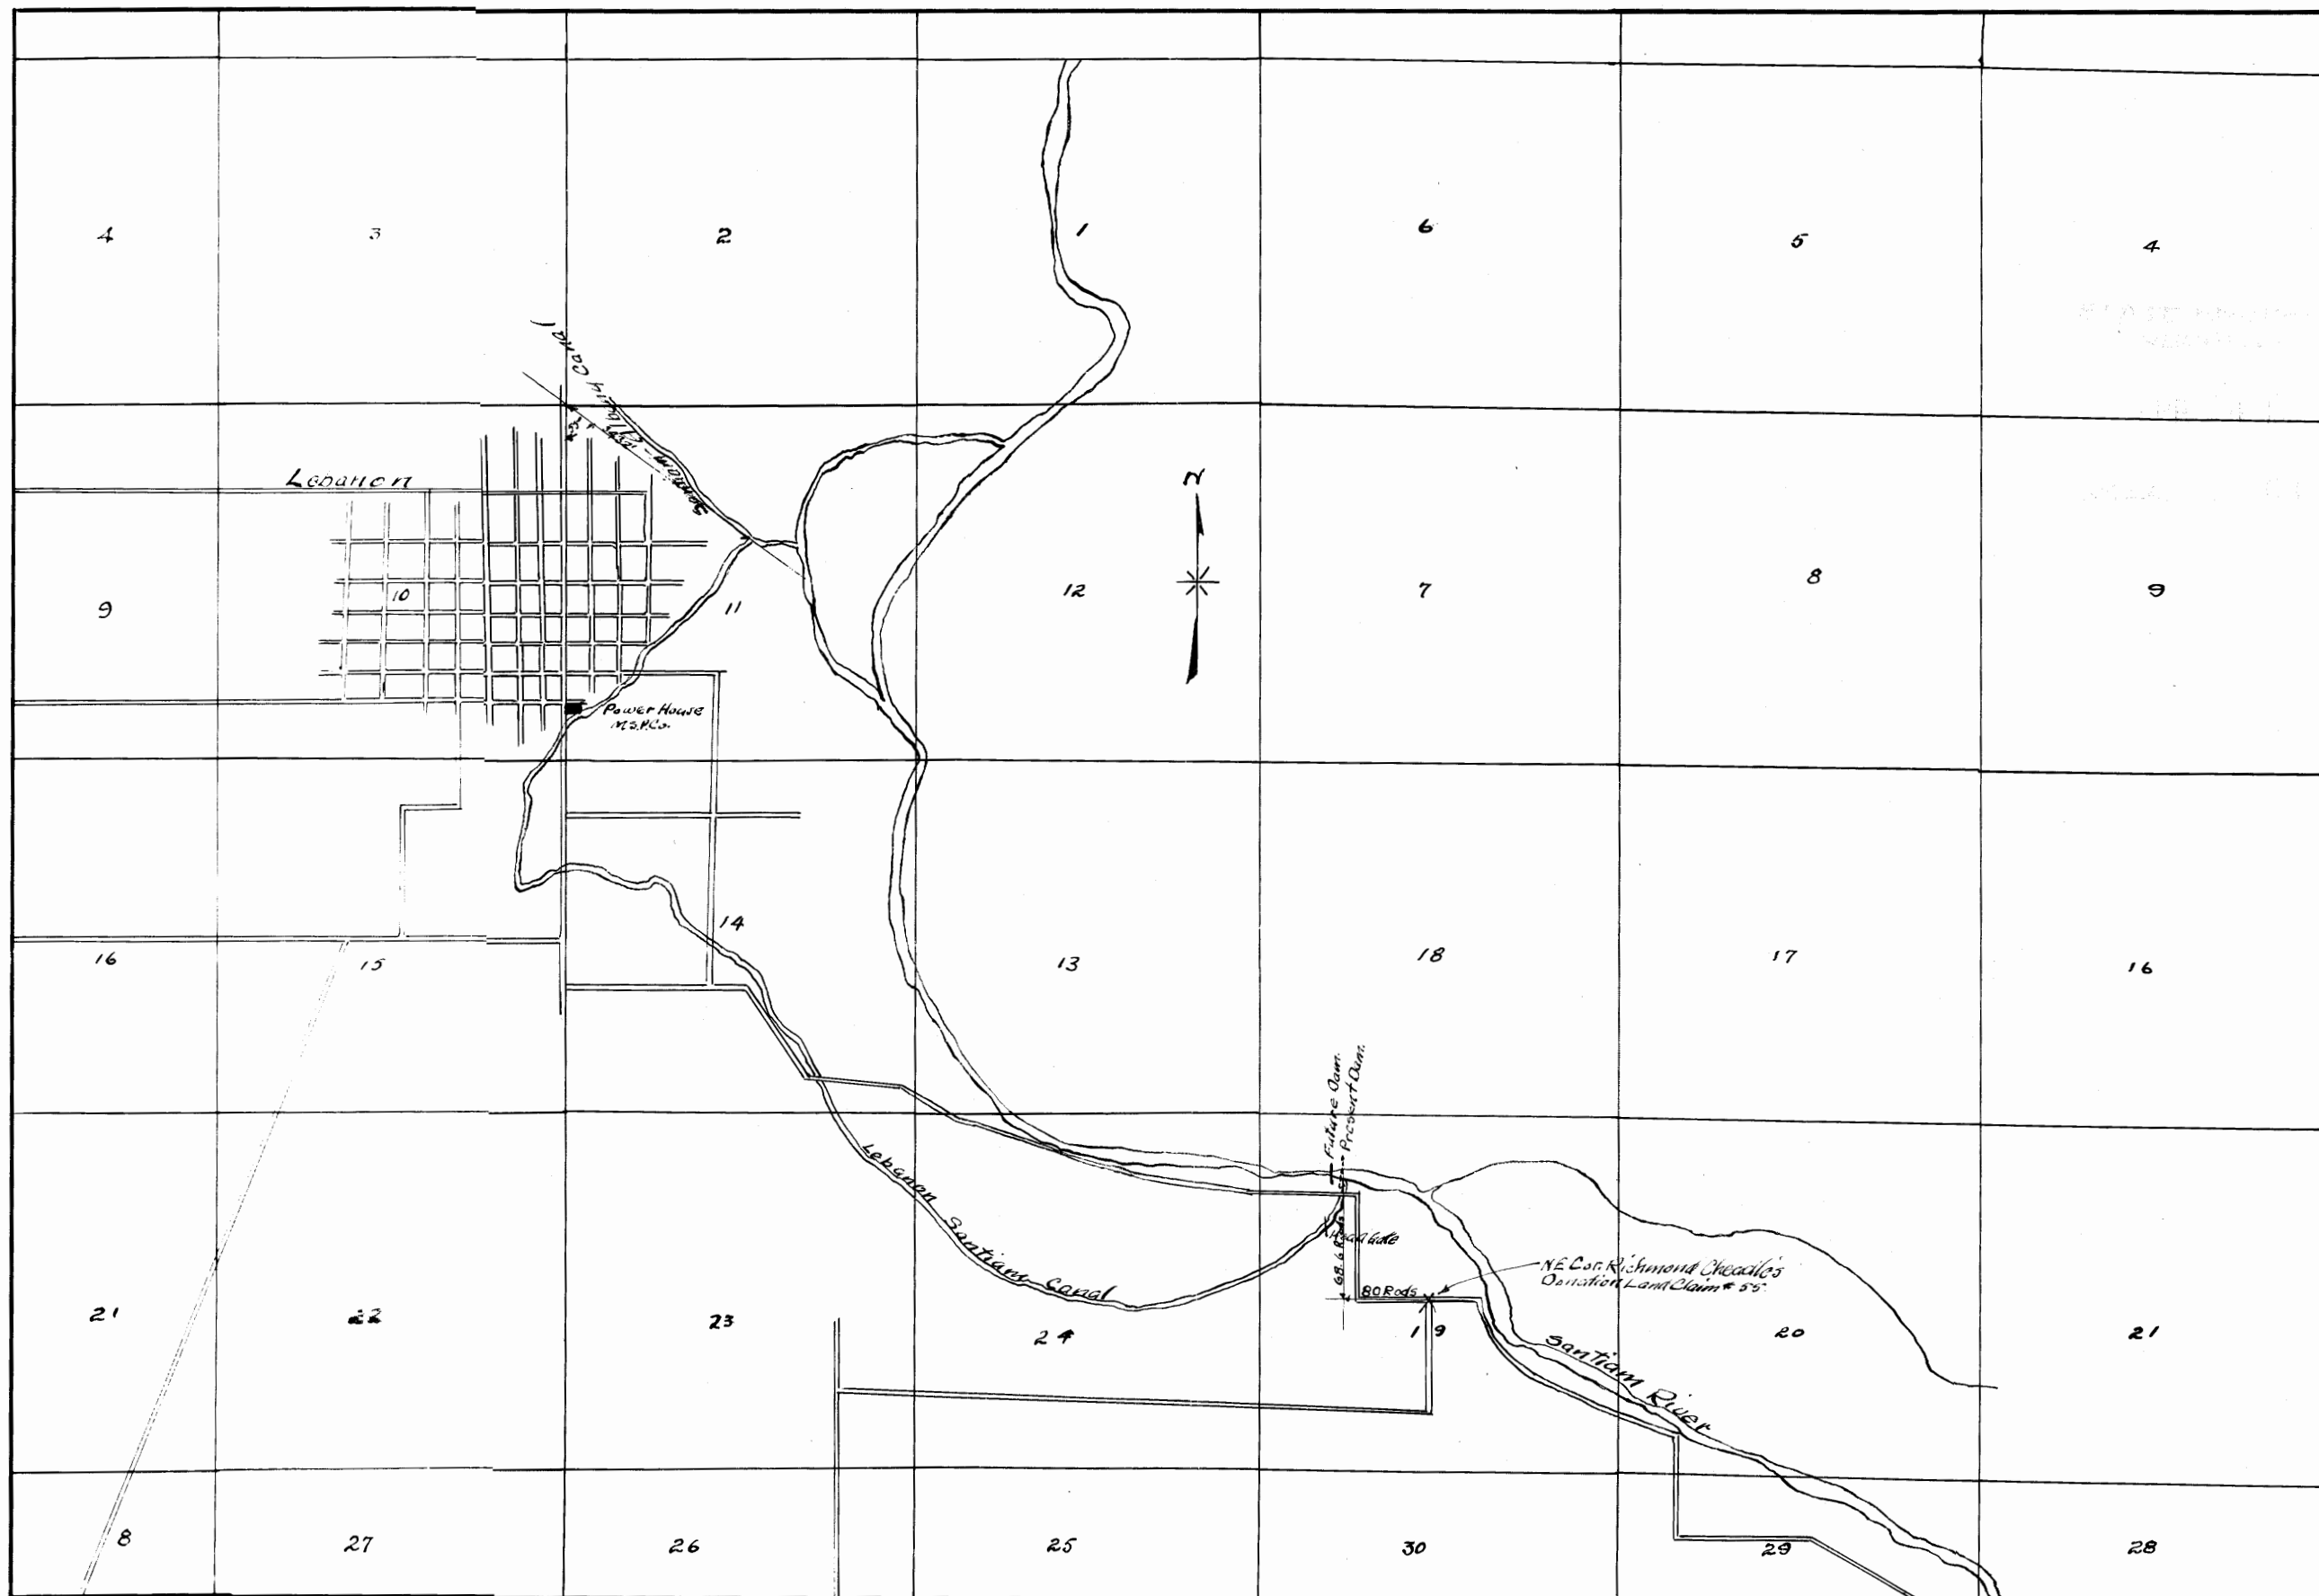

CERTIFICATE OF REGISTERED PROFESSIONAL ENGINEER
 I, S.I. Stewart, of Lebanon, Ore, do hereby certify that
 this map was made from notes taken during an actual survey
 made by (or under my immediate supervision) on Apr. 3-1925
 and that it correctly represents the works described in the
 accompanying application, together with the location of streams
 and other ditches in the immediate vicinity.
 Oregon No. 62 S.I. Stewart
 Date of Registration Nov. 8-19 Registered Professional Engr.

MOUNTAIN STATES POWER COMPANY ALBANY, ORE

Map Showing Location of Lebanon-Santiam Canal

DRAWN H.C.W.
 TRACED H.C.W.
 CHECKED H.C.W.


DATE 4-3-25

SCALE 2" = 1 Mi.




PRINT No.

No. D-45.


10130

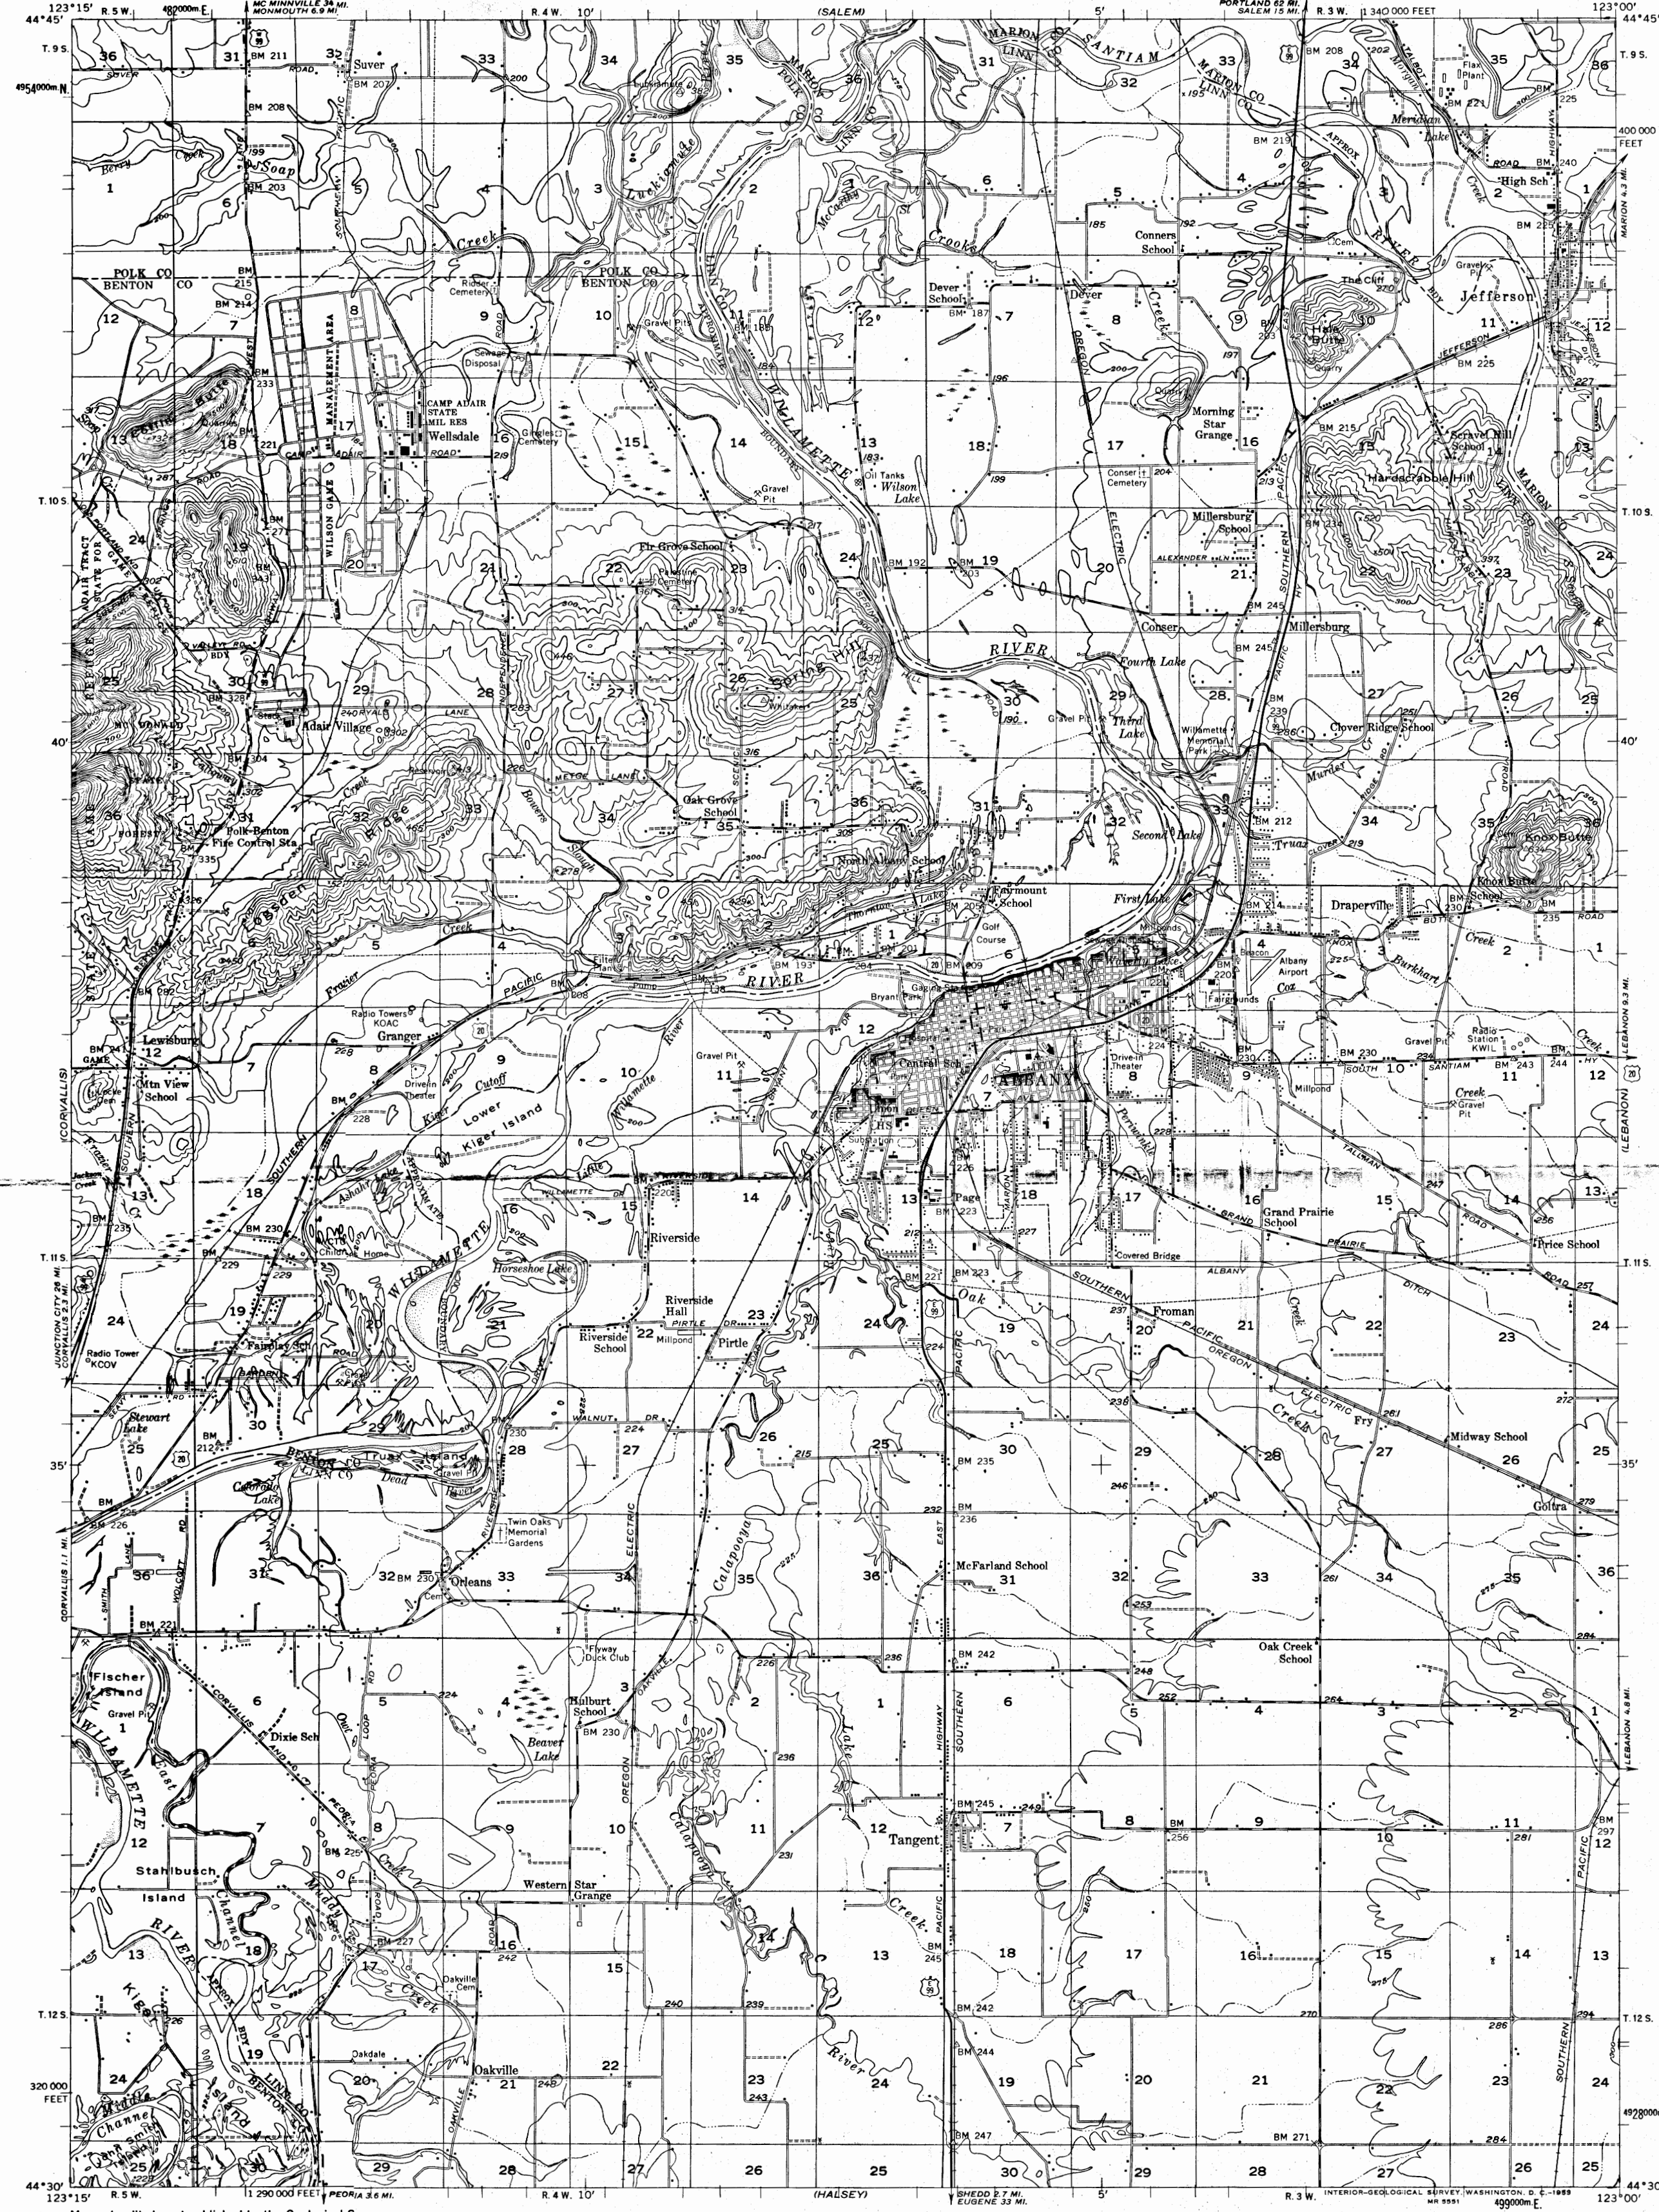

Maped, edited, and published by the Geological Survey
Control by USGS, USC&GS, USCE, and State of Oregon
Topography by planetable surveys 1911-1913
Culture revised from aerial photographs taken 1954
Field check 1957
Polyconic projection, 1927 North American datum
10,000-foot grid based on Oregon coordinate system, north zone
1000-meter Universal Transverse Mercator grid ticks,
zone 10, shown in blue
Red tint indicates areas in which only
landmark buildings are shown

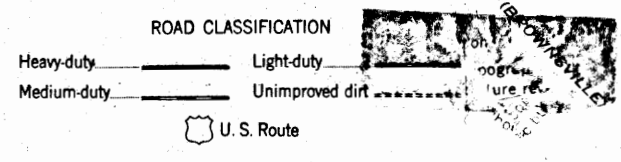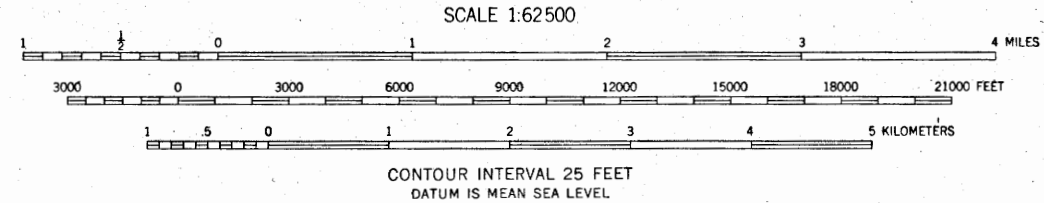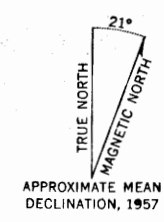

ALBANY, OREG.
N4430-W12300/15

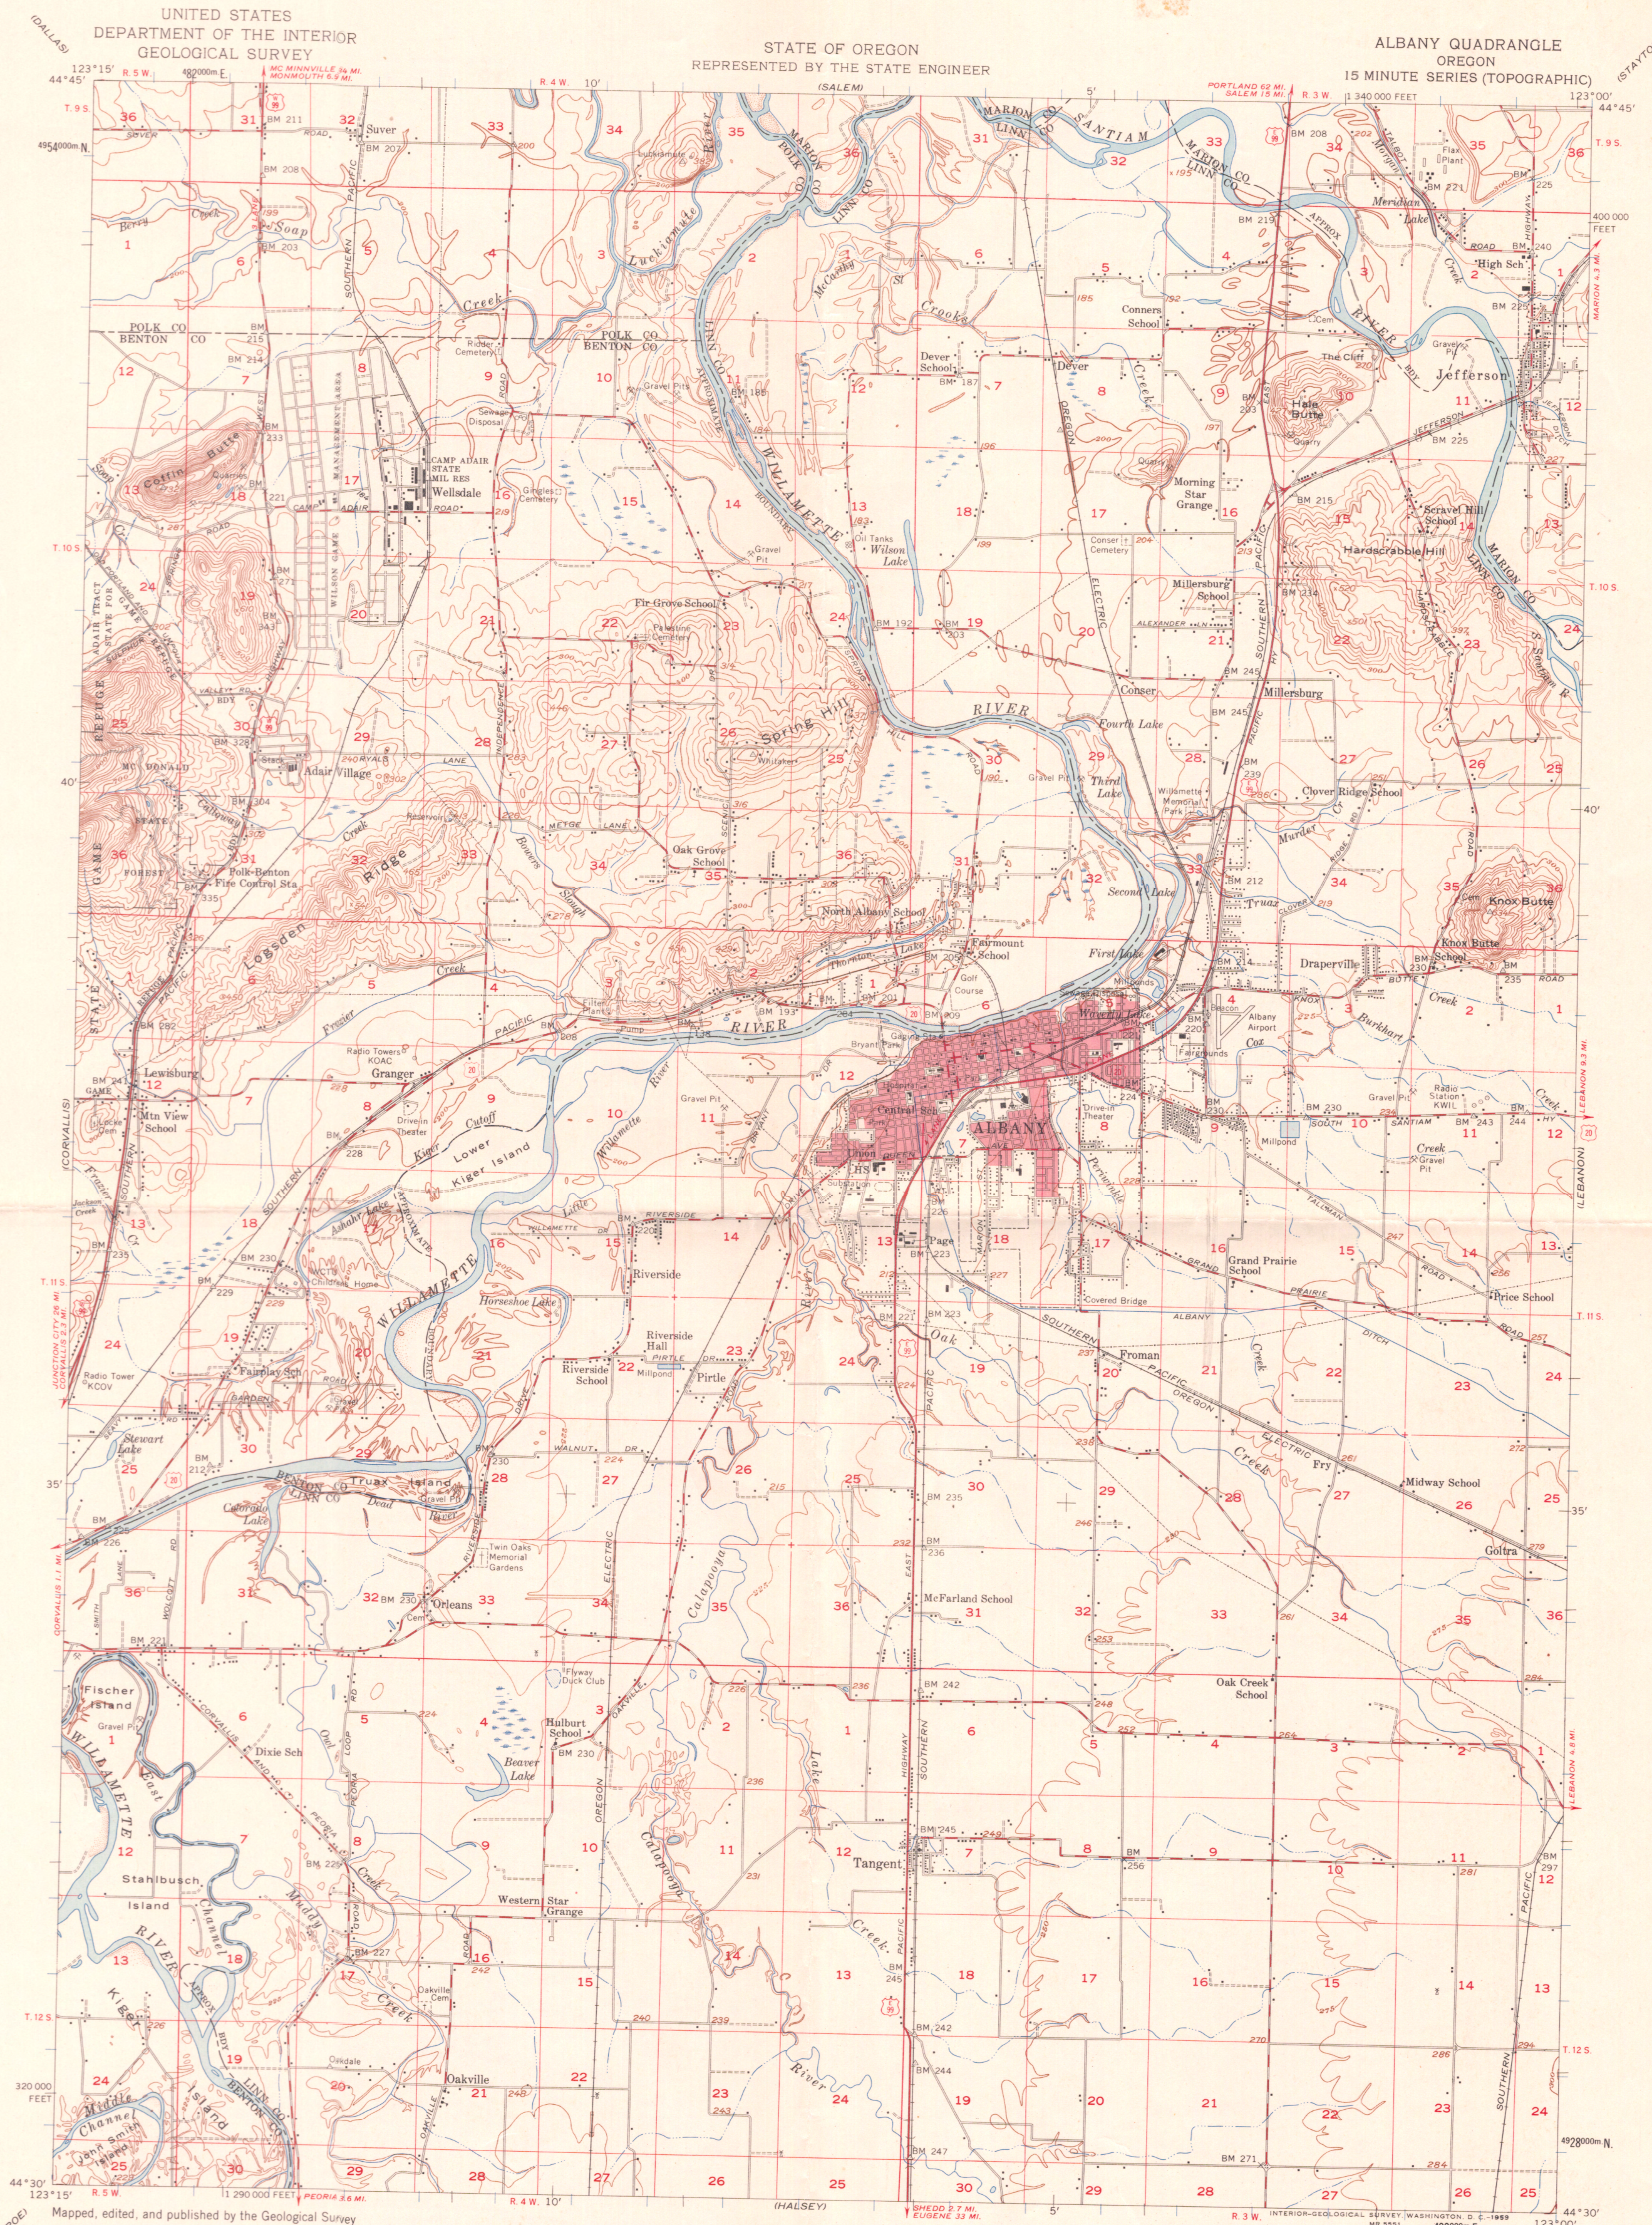

Mapped, edited, and published by the Geological Survey
Control by USGS, USC&GS, USCE, and State of Oregon
Topography by planetable surveys 1911-1913
Culture revised from aerial photographs taken 1954
Field check 1957
Polyconic projection. 1927 North American datum
10,000-foot grid based on Oregon coordinate system, north zone
1000-meter Universal Transverse Mercator grid ticks,
zone 10, shown in blue
Red tint indicates areas in which only
landmark buildings are shown

TRUE NORTH
MAGNETIC NORTH
APPROXIMATE MEAN
DECLINATION, 1957

