

501 ADDED TO	500
710	707
720	727
726	729
728-100	725
728-138	738
702	711
736	729
741	727
750 A1	703


201 ADDED TO 391E 13-101  
 200 " " 391E 130-1100  
 392E 19-1101 ADDED TO 706

Section 24 T.39S. R1E.W.M.

Scale 1" = 400'

**IMPORTANT**  
 THIS MAP FOR ASSESSMENT  
 & TAXATION PURPOSES  
 ONLY

39 IE 24

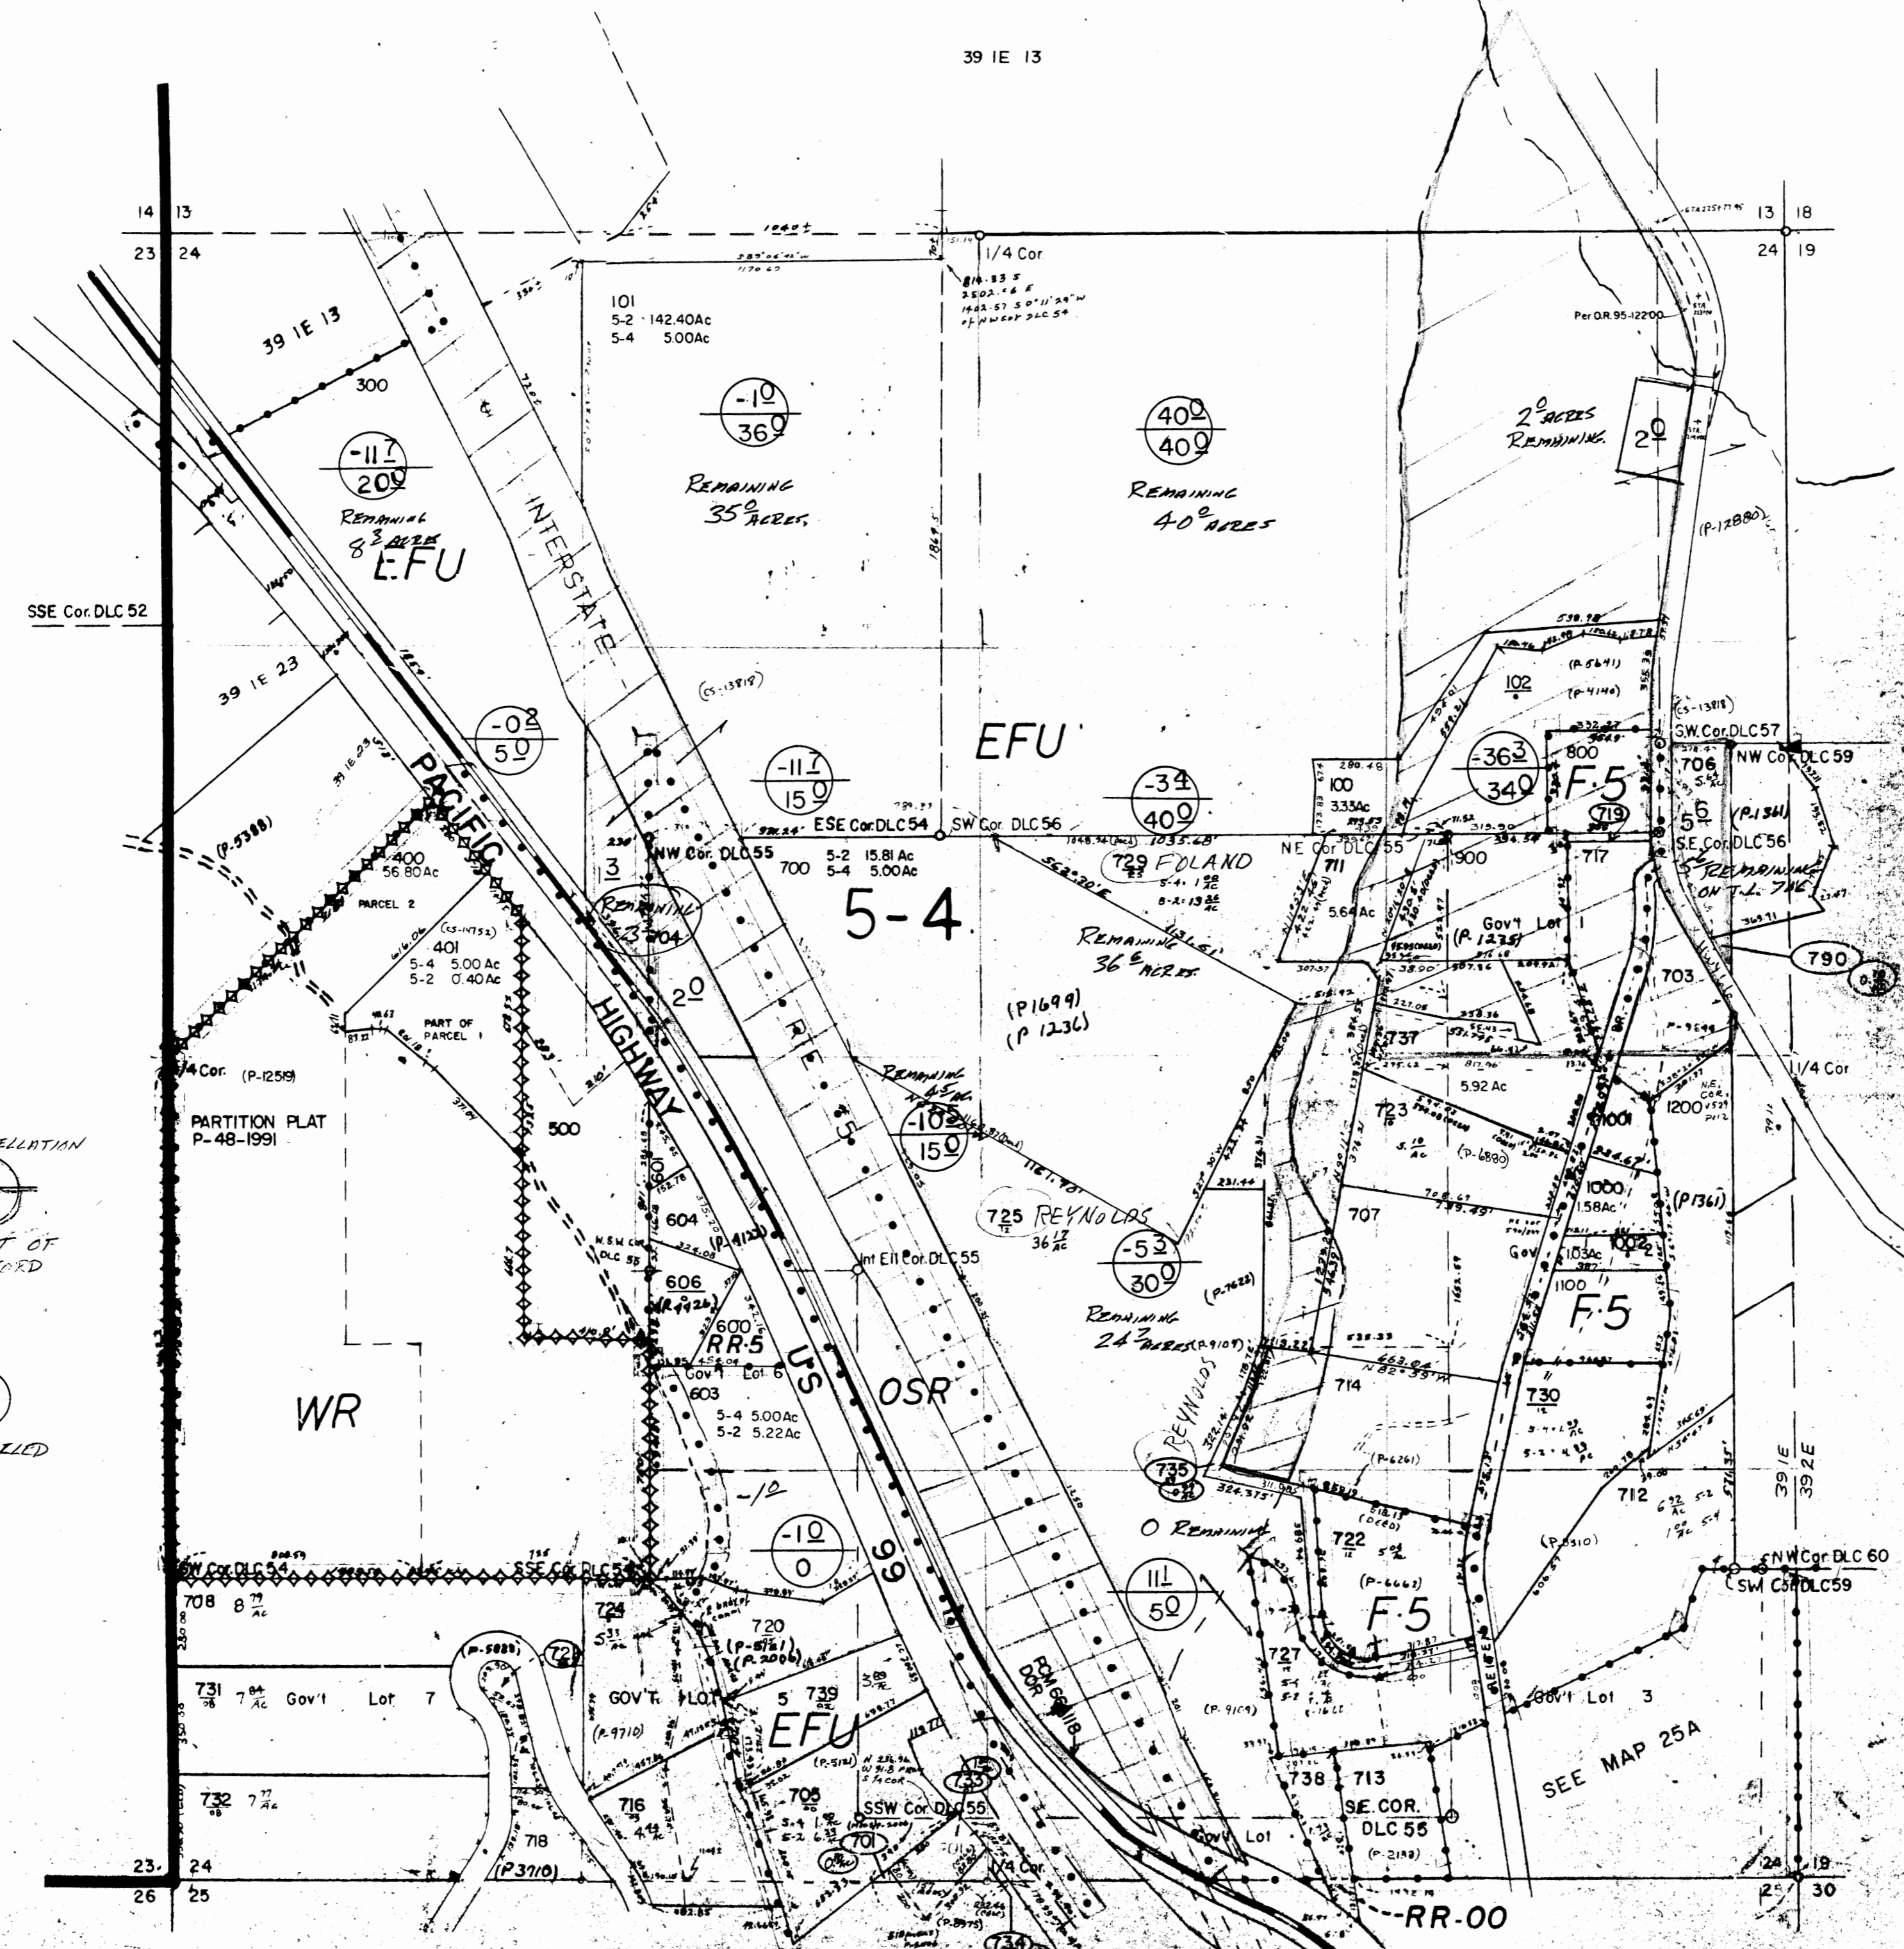


CANCELLATION  
 RIGHT OF RECORD  
 CANCELLED

SEE MAP 25A

Section 24 T.39S. R.1E. W.M.

39 IE 24

Scale 1" = 400'

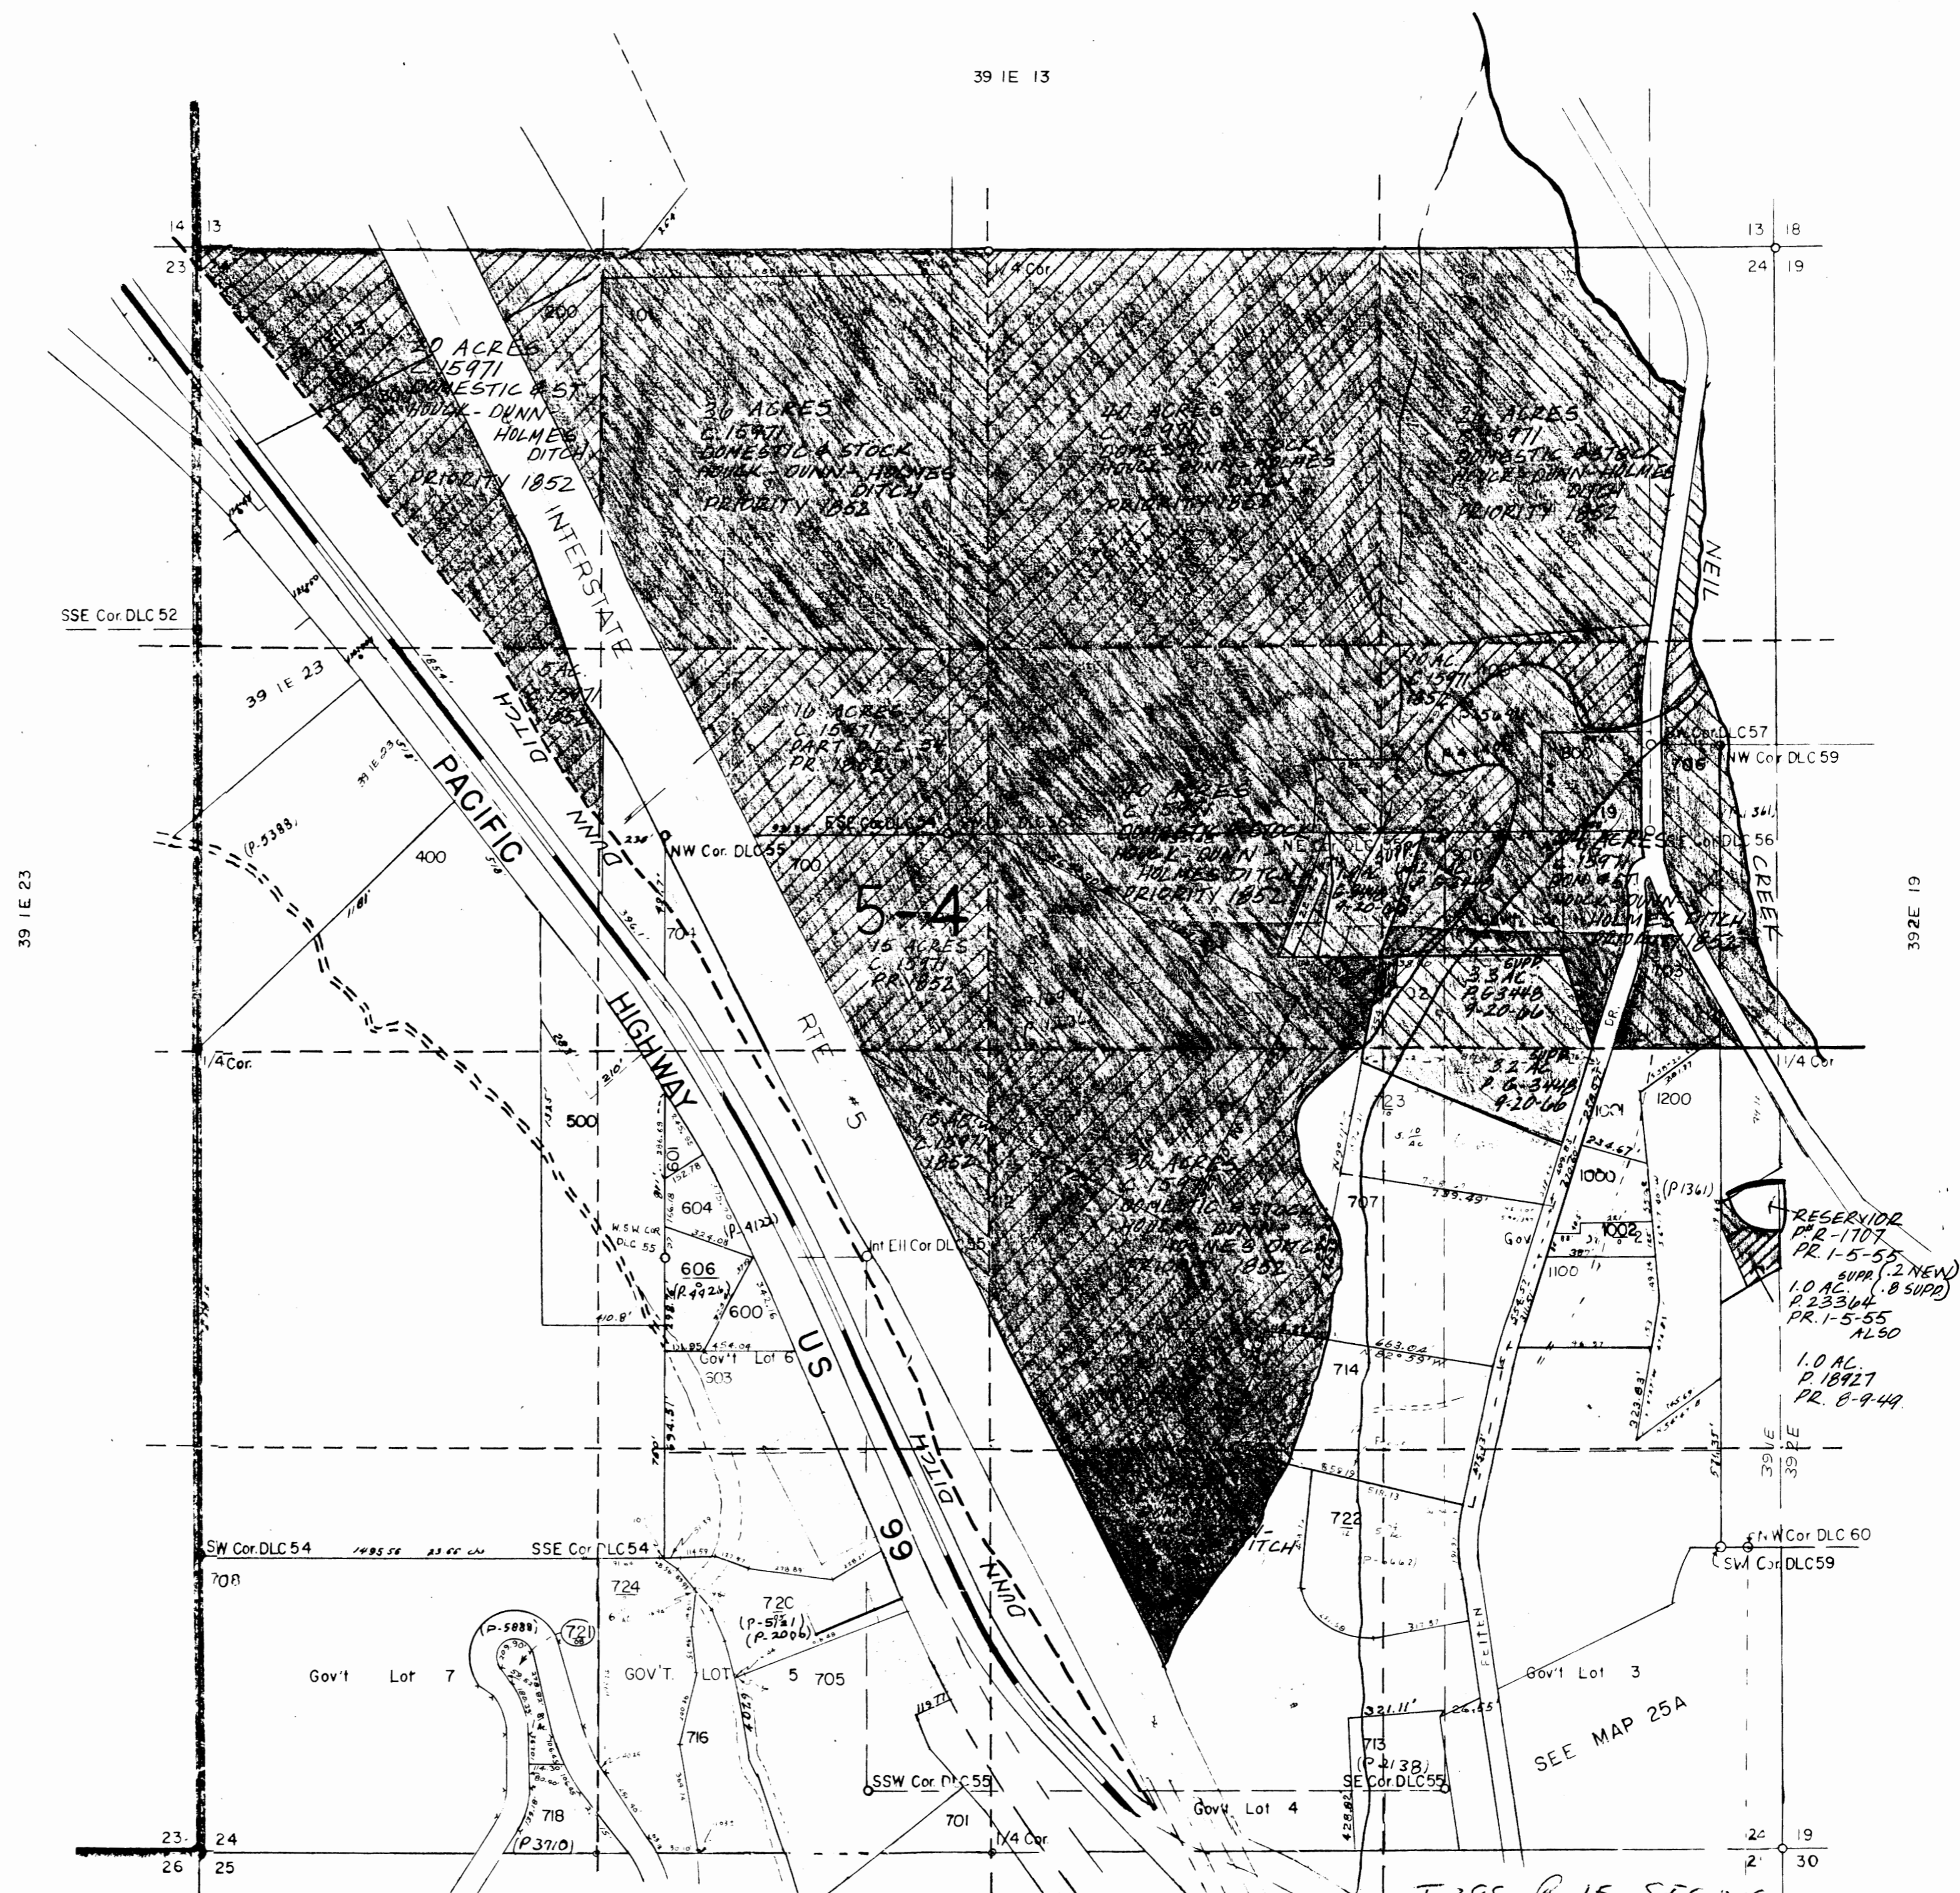

RESERVOIR  
 PR-1707  
 PR-1-5-55  
 SUPP. (2 NEW)  
 1.0 AC. (8 SUPP)  
 P. 23364  
 PR-1-5-55  
 ALSO  
 1.0 AC.  
 P. 18927  
 PR. 8-9-49

SEE MAP 25A

T.39S. R.1E. SEC. 24

3

S.W. 1/4 SEC 13 T 39S R1E WM.

SCALE 1" = 200'

12 ACRES  
P. 2420  
4-10-15  
SULPHUR SPRING 39 1E 13C

GOLF COURSE  
(ASHLAND)  
MUNICIPAL USE  
P. 11243  
PR. 4-25-34  
SULPHUR SPRING

0.4 AC.  
C. 41774  
1854

0.5 ACRES  
C. 41774  
1854

1.0 ACRES  
C. 41774  
1854

5-12

5-1

5-15

5-4

CROWSON

R1E CREEK

TOLMAN

10.2 ACRES  
C. 15971  
PR. 10-1-51  
HOLMBE DITCH

1.0 ACRES  
C. 15971  
PR. 10-1-51  
HOLMBE DITCH

39 1E 24

T. 39S R1E SEC. 13 SW 1/4

