

MAP #1

THIS MAP WAS PREPARED FOR  
ASSESSMENT PURPOSE ONLY

T.41S. R.14E. WM.  
KLAMATH COUNTY  
T-2000'

41 14  
& INDE


SEE MAP 40 14

THIS R14E  
SEC 7, 8

200 Acre  
TL 1300

Sec. 7 - 140 Acre

8 = 60 ACRE

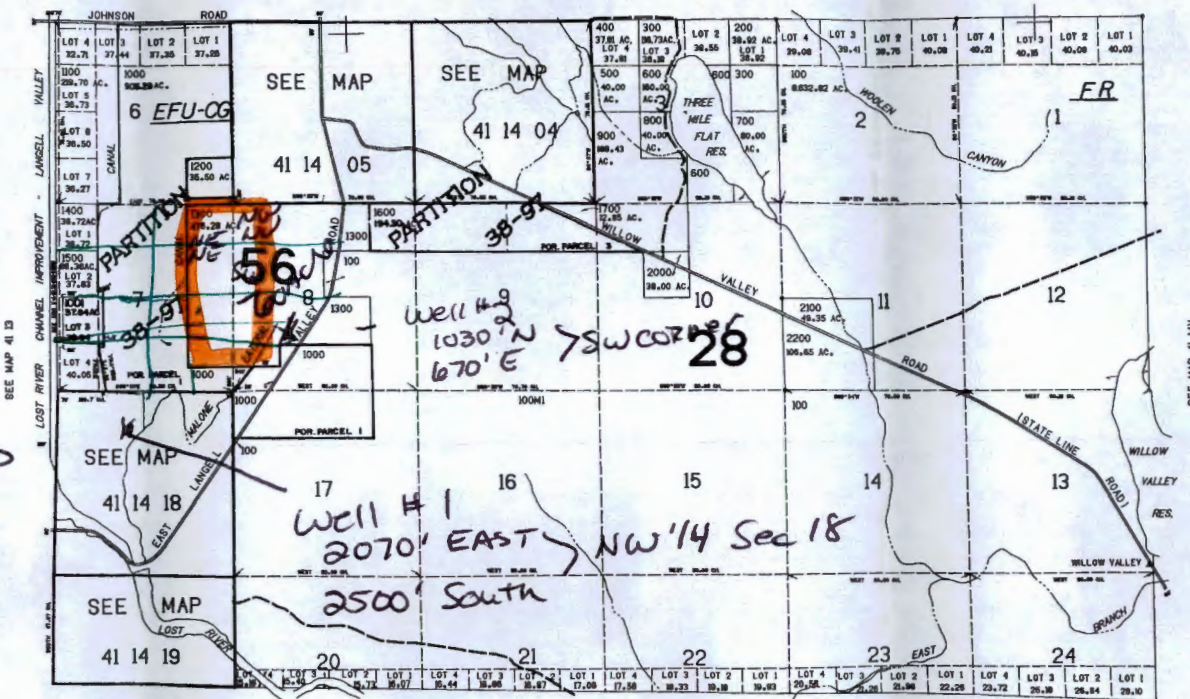

CANCELLED NOS  
1900  
1900

CALIFORNIA

180,000

41 14  
& INDEX

RECEIVED BY OWRD

APR 18 2014

SALEM, OR

Scale  
1" = 2000'