



Oregon Water Resources Department
 725 Summer Street NE, Suite A
 Salem, Oregon 97301
 (503) 986-0900
 www.wrd.state.or.us

RECEIVED BY OWRD

Request for Assignment

APR 29 2014

SALEM, OR

If for multiple rights, a separate form and fee for each right will be required.

I, Thomas + Barbara Howard G-15252
 (Name of Applicant / Permit / Transfer Holder / License Holder/GR Certificate of Registration)

P.O. Box 196 Drewsey OR 97904 541-493-2603
 (Mailing Address) (City) (State) (Zip) (Phone #)

- hereby assign all my interest in and to application/permit/transfer/license/GR Certificate of Registration;
- hereby assign all my interest in and to a portion of application/permit/transfer/license/GR Certificate of Registration; (You must include a map showing the portion of the application/permit/transfer/license/GR Certificate of Registration to be assigned.)
- hereby assign a portion of my interest in and to the entire application/permit/transfer/license/GR Certificate of Registration:

Application # G-15675; Permit # G-15252; Transfer # T-10431
 -OR-

License # _____; GR Statement # _____; GR Certificate of Registration # _____

As filed in the office of the Water Resources Director, to:

Arnold Mastre
 (Name of New Owner)

58477 Hwy 78 Burns OR 97904
 (Mailing Address) (City) (State) (Zip) (Phone #)

Note: If there are other owners of the property described in the Application, Permit, Transfer, License, or GR Certificate of Registration, you must provide a list of all other owners' names and mailing addresses and attach it to this form.

I hereby certify that I have notified all other owners of the property described in this Application, Permit, Transfer, License, or GR Certificate of Registration of this Request for Assignment

Witness my hand this 23rd day of April, 2014.

Applicant/Permit Holder Thomas Howard

Applicant/Permit Holder Barbara J. Howard

ACC 16w JAC:AC
 JS 4/29/14

DO NOT WRITE IN THIS BOX

This certifies assignment and record change at Oregon Water Resources Department effective 8:00 a.m. on date of receipt at Salem, Oregon.
 Fee receipt # 111894
 For Director by Jerry Sauter, Program Analyst in Water Rights Division

The completed "Request for Assignment" form *must* be submitted to the Department along with the recording fee of \$85.

Copy from file - Permit G-15252

RECEIVED

NOV 16 2001

WATER RESOURCES DEPT.
SALEM, OREGON

T 24 S, R 33 E, WM

Approx. Proposed Well 13bh1 (Site #1) to serve land in NW 1/4, Sec 2

RECEIVED

JAN 03 2002


WATER RESOURCES DEPT.
SALEM, OREGON

Approx. Proposed Well 16bh1 (Site #2) to serve land in SW 1/4, Sec. 25

RECEIVED BY OWRD

APR 29 2014

SALEM, OR

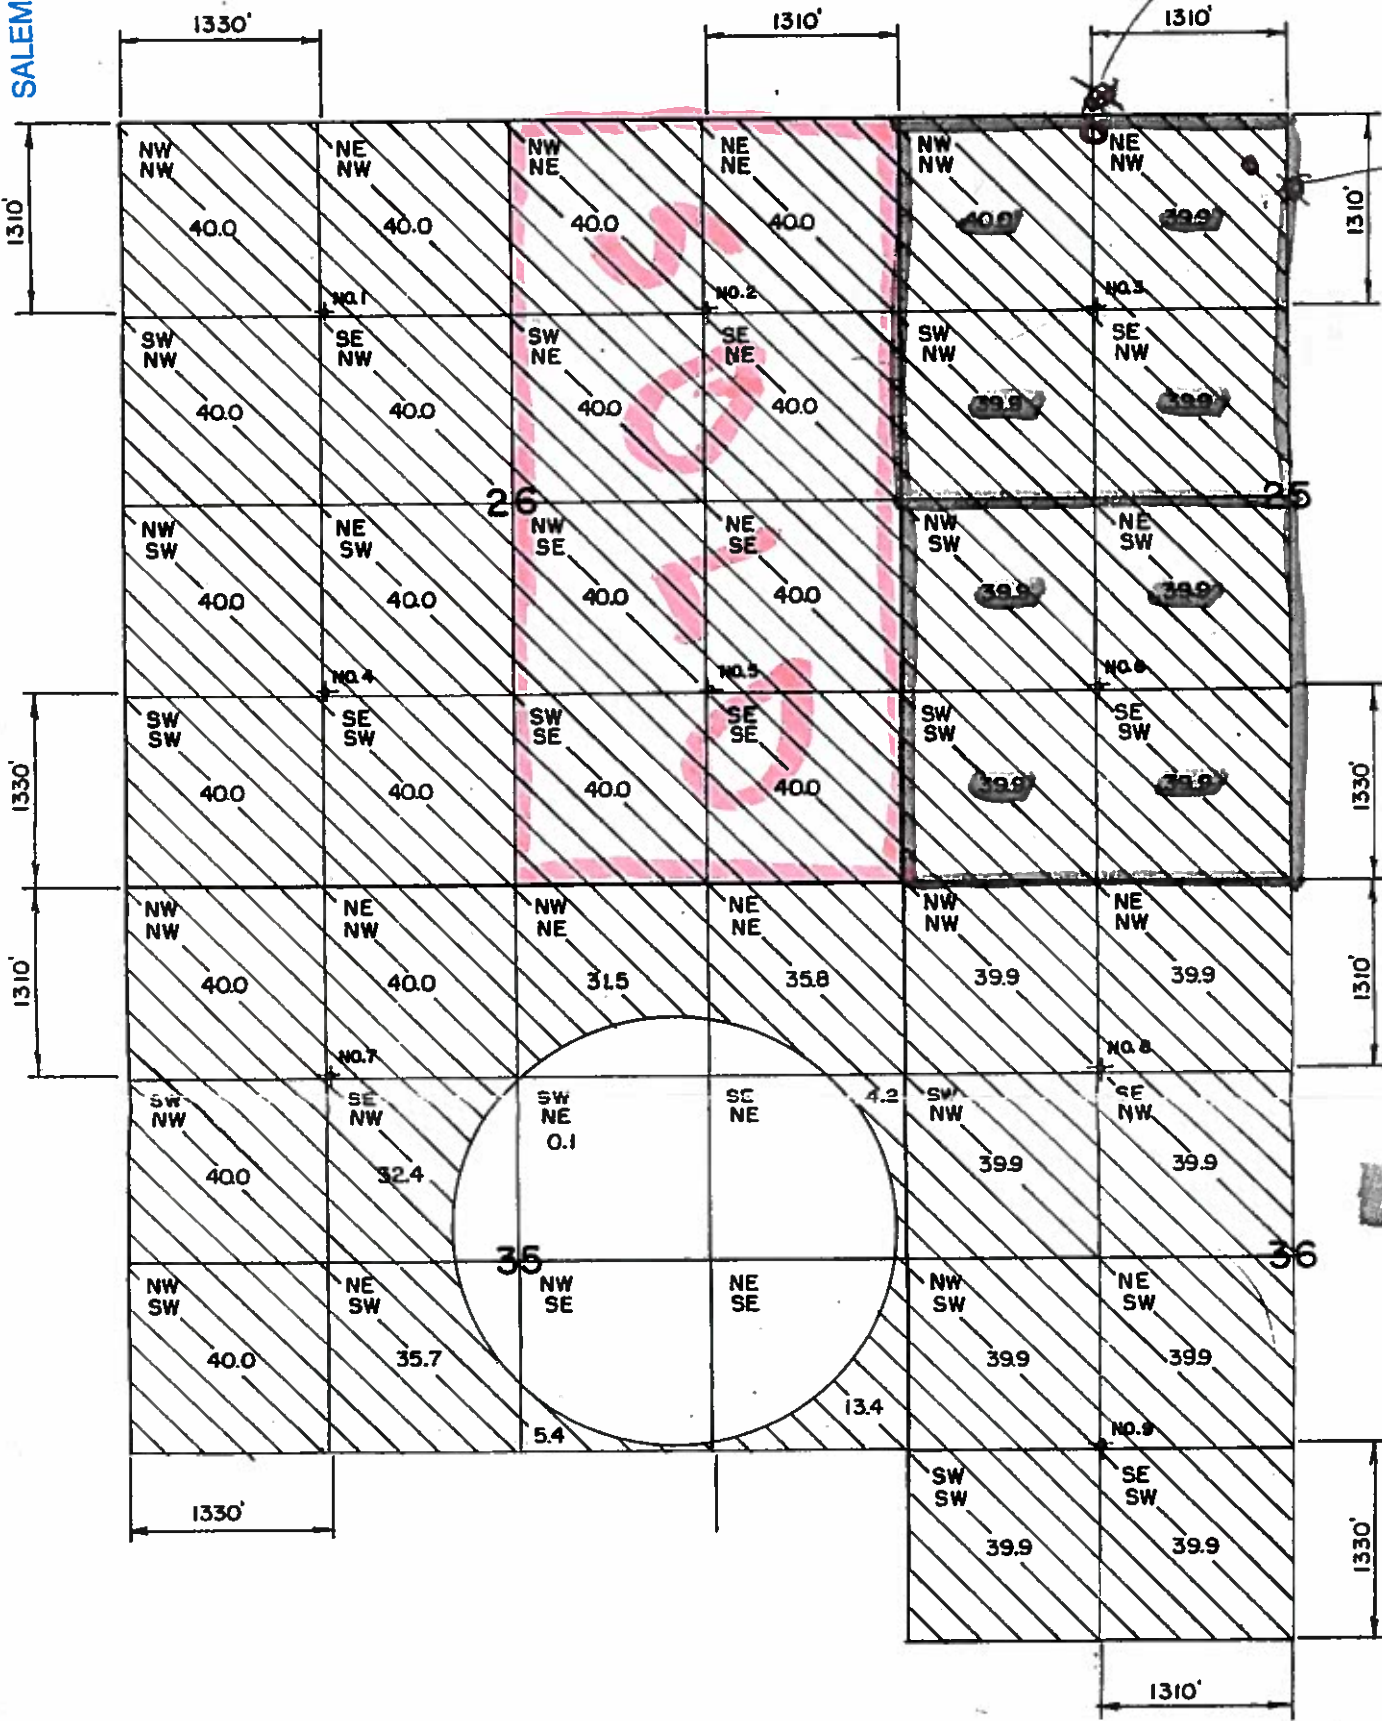

= Portion of permit being affected by T-1043

WELL LOCATIONS

Well No.	N/S Dist.	E/W Dist.	From Cor.
1	1310' S	1330' E	NW of Sec. 26
2	1310' S	1310' W	NE of Sec. 26
3	1310' S	1310' W	N1/4 of Sec. 25
4	1310' N	1330' E	SW of Sec. 26
5	1330' N	1310' W	SE of Sec. 26
6	1330' N	1310' W	S1/4 of Sec. 25
7	1310' S	1330' E	NW of Sec. 35
8	1310' S	1310' W	N1/4 of Sec. 36
9	1330' N	1310' W	S1/4 of Sec. 36


SECTIONS 25 & 36 - TAX LOT 6900
SECTION 26 - TAX LOT 7400
SECTION 35 - TAX LOT 9100

159.7 Ac

WELL LOCATIONS (TOTAL OF 9 WELLS)

THE PURPOSE OF THIS MAP IS TO IDENTIFY THE LOCATION OF THE WATER RIGHT. IT IS NOT INTENDED TO PROVIDE INFORMATION RELATIVE TO THE LOCATION OF PROPERTY OWNERSHIP.

Application No. G-15675
Permit No. G-15252

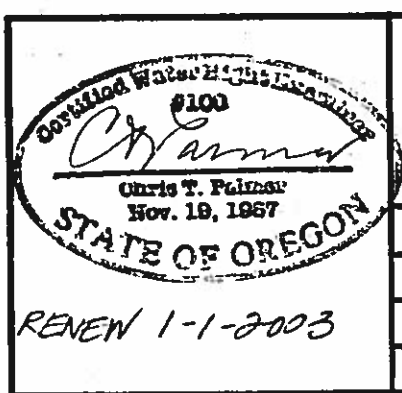

4J RANCH / CRANE

WATER RIGHT APPLICATION MAP

Scale: 4" = 1 MILE	Date: 9-15-2001	Job: 2027
Dsn:	M.A. PALMER & SONS, INC. ENGINEERING & SURVEYING 711 Ponderosa Village • Box 61 Burns, Oregon 97720	Sht. No.
Dm: CHRIS		of 1
Ckd:		