
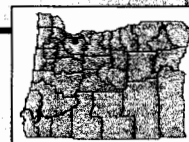


4-17-05


1" = 1000'

OR Water Resources Map

Oregon Water Resources Department
725 Summer St NE, Suite A, Salem, OR 97301
(503)986-0900

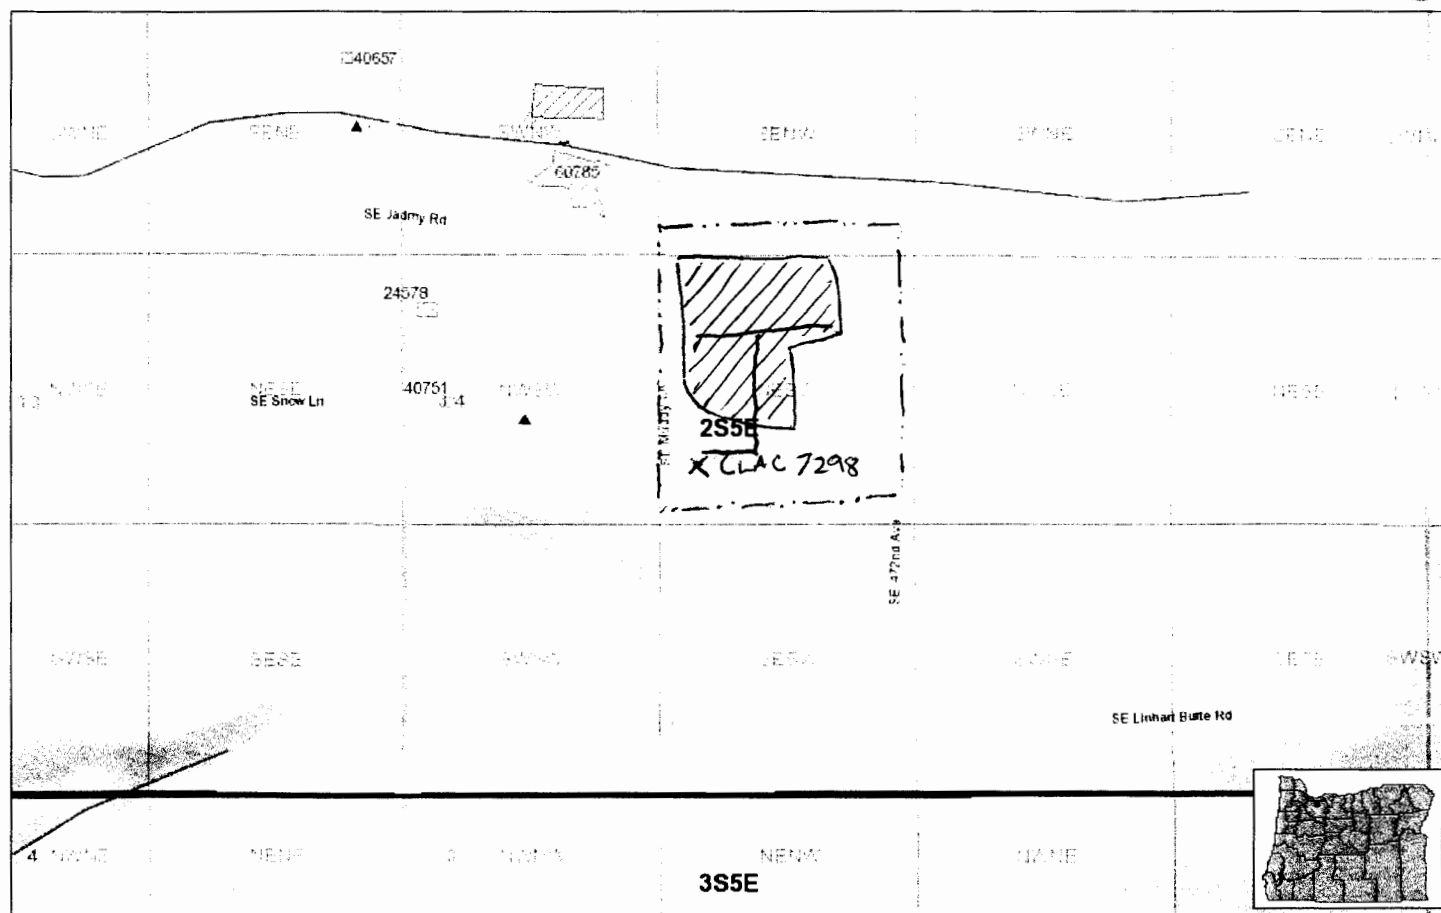

- POD - Storage water
- POU - Surface water
- POU - Storage water
- POD - Groundwater
- POD - Surface Water
- POU - Groundwater

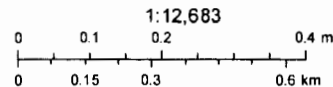

National Geographic, Esri, DeLorme, HERE, UNEP-WCMC, USGS, NASA, ESA, METI, NRCAN, GEBCO, NOAA, increment P Corp

Property Legal Boundaries
Township 2S
Range 5E
Section 34: NE 1/4 of SW 1/4

Tax Lot # 2SE 34C 00100

--- approximate property boundary line / tax lot

proposed irrigated acres (12.4 acres) (area of use)

X well location
1100' S & 1500' E from NW 1/4 SE

proposed buried irrigation water lines

RECEIVED BY OWRD

MAY 07 2014

SALEM, OR