


1" = 1320'
Tax Lot: 405, 400

North

4 South 3 East Section 6

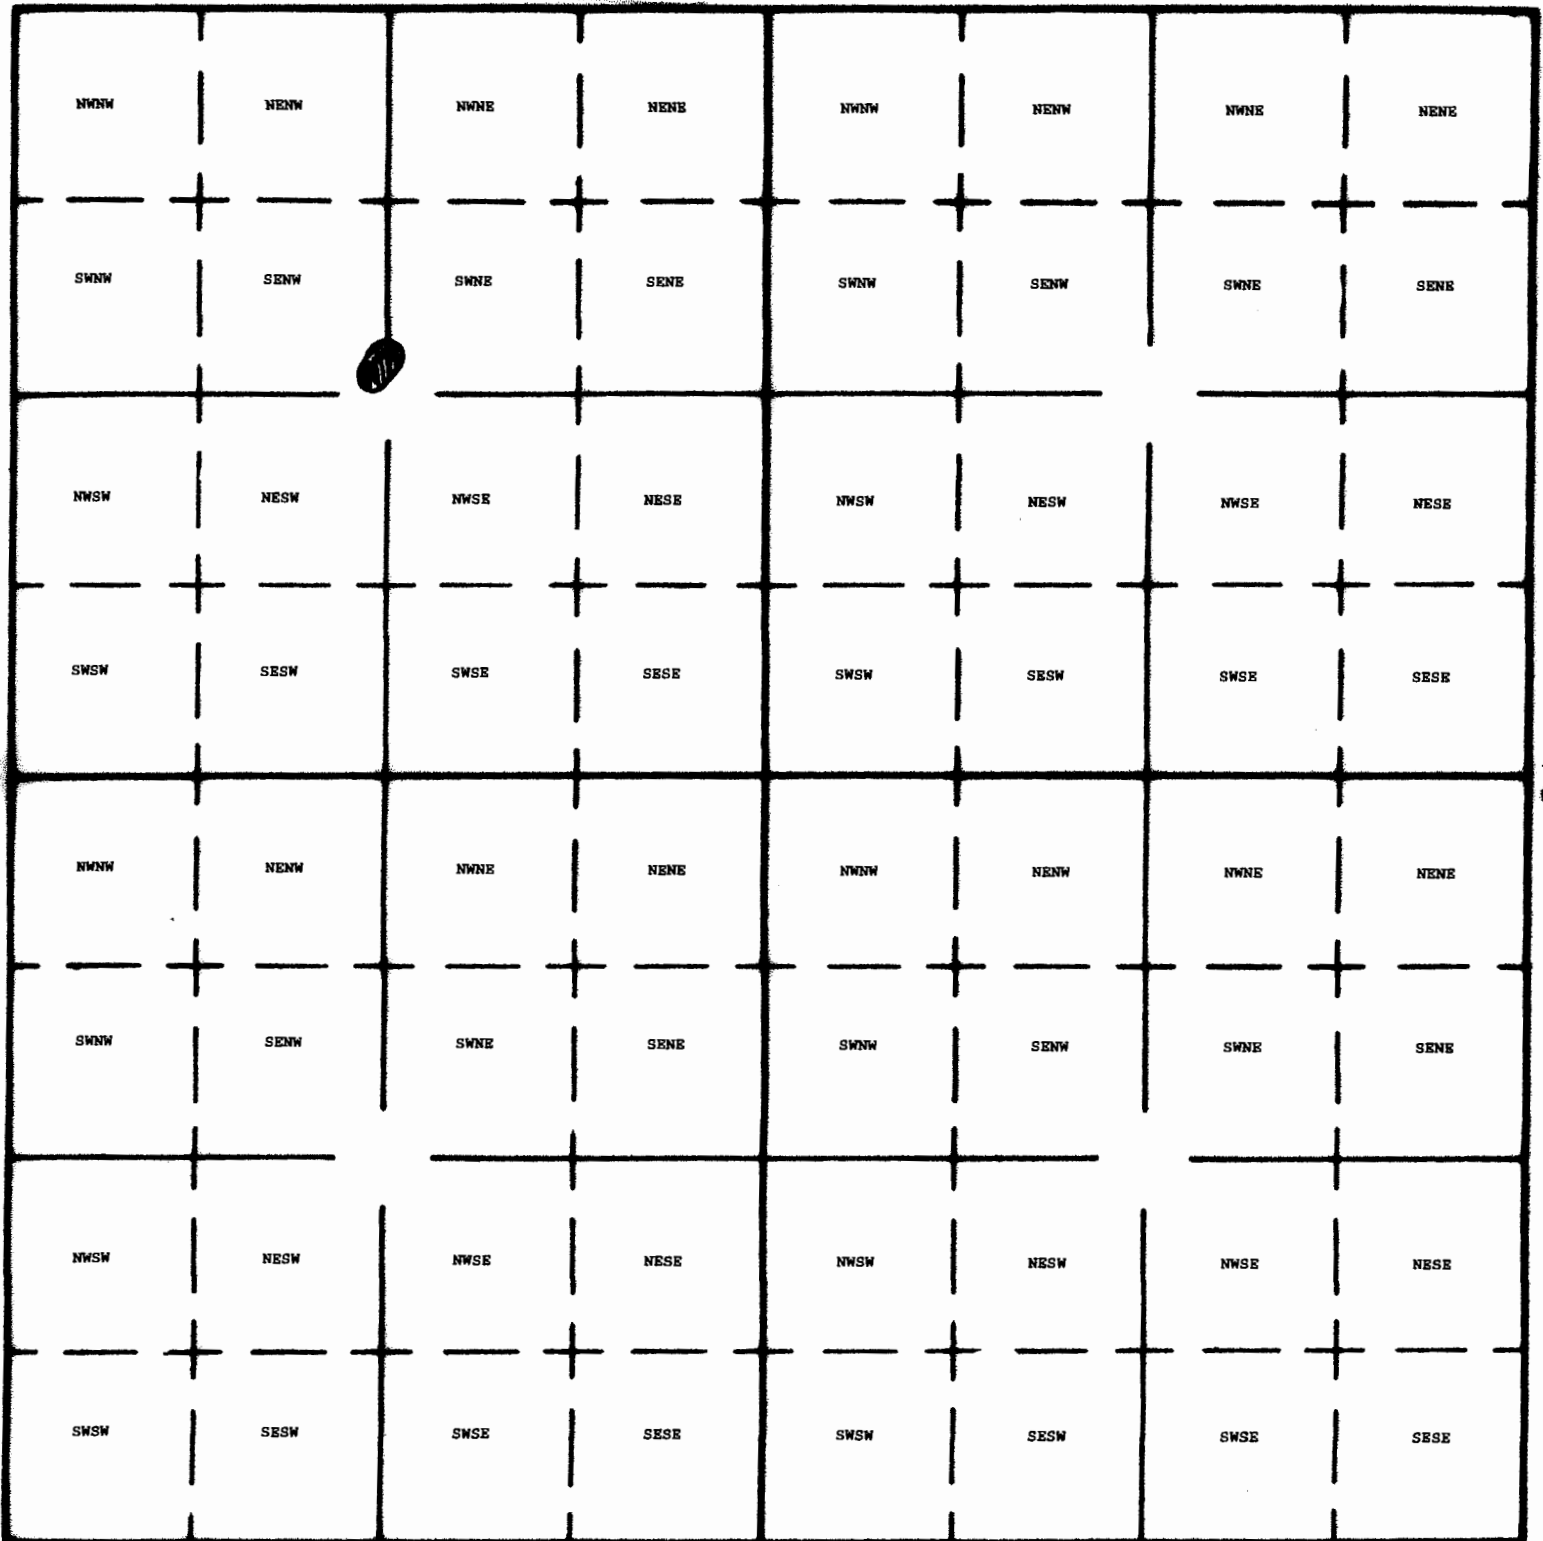

RECEIVED BY OWRD

Dam Loc

140 Feet West and 30 Feet North
from Center of Section 6

MAY 07 2014

SALEM, OR

R-0777