


Application No. 67448-R-67451
Permit No. 48319 R 9584

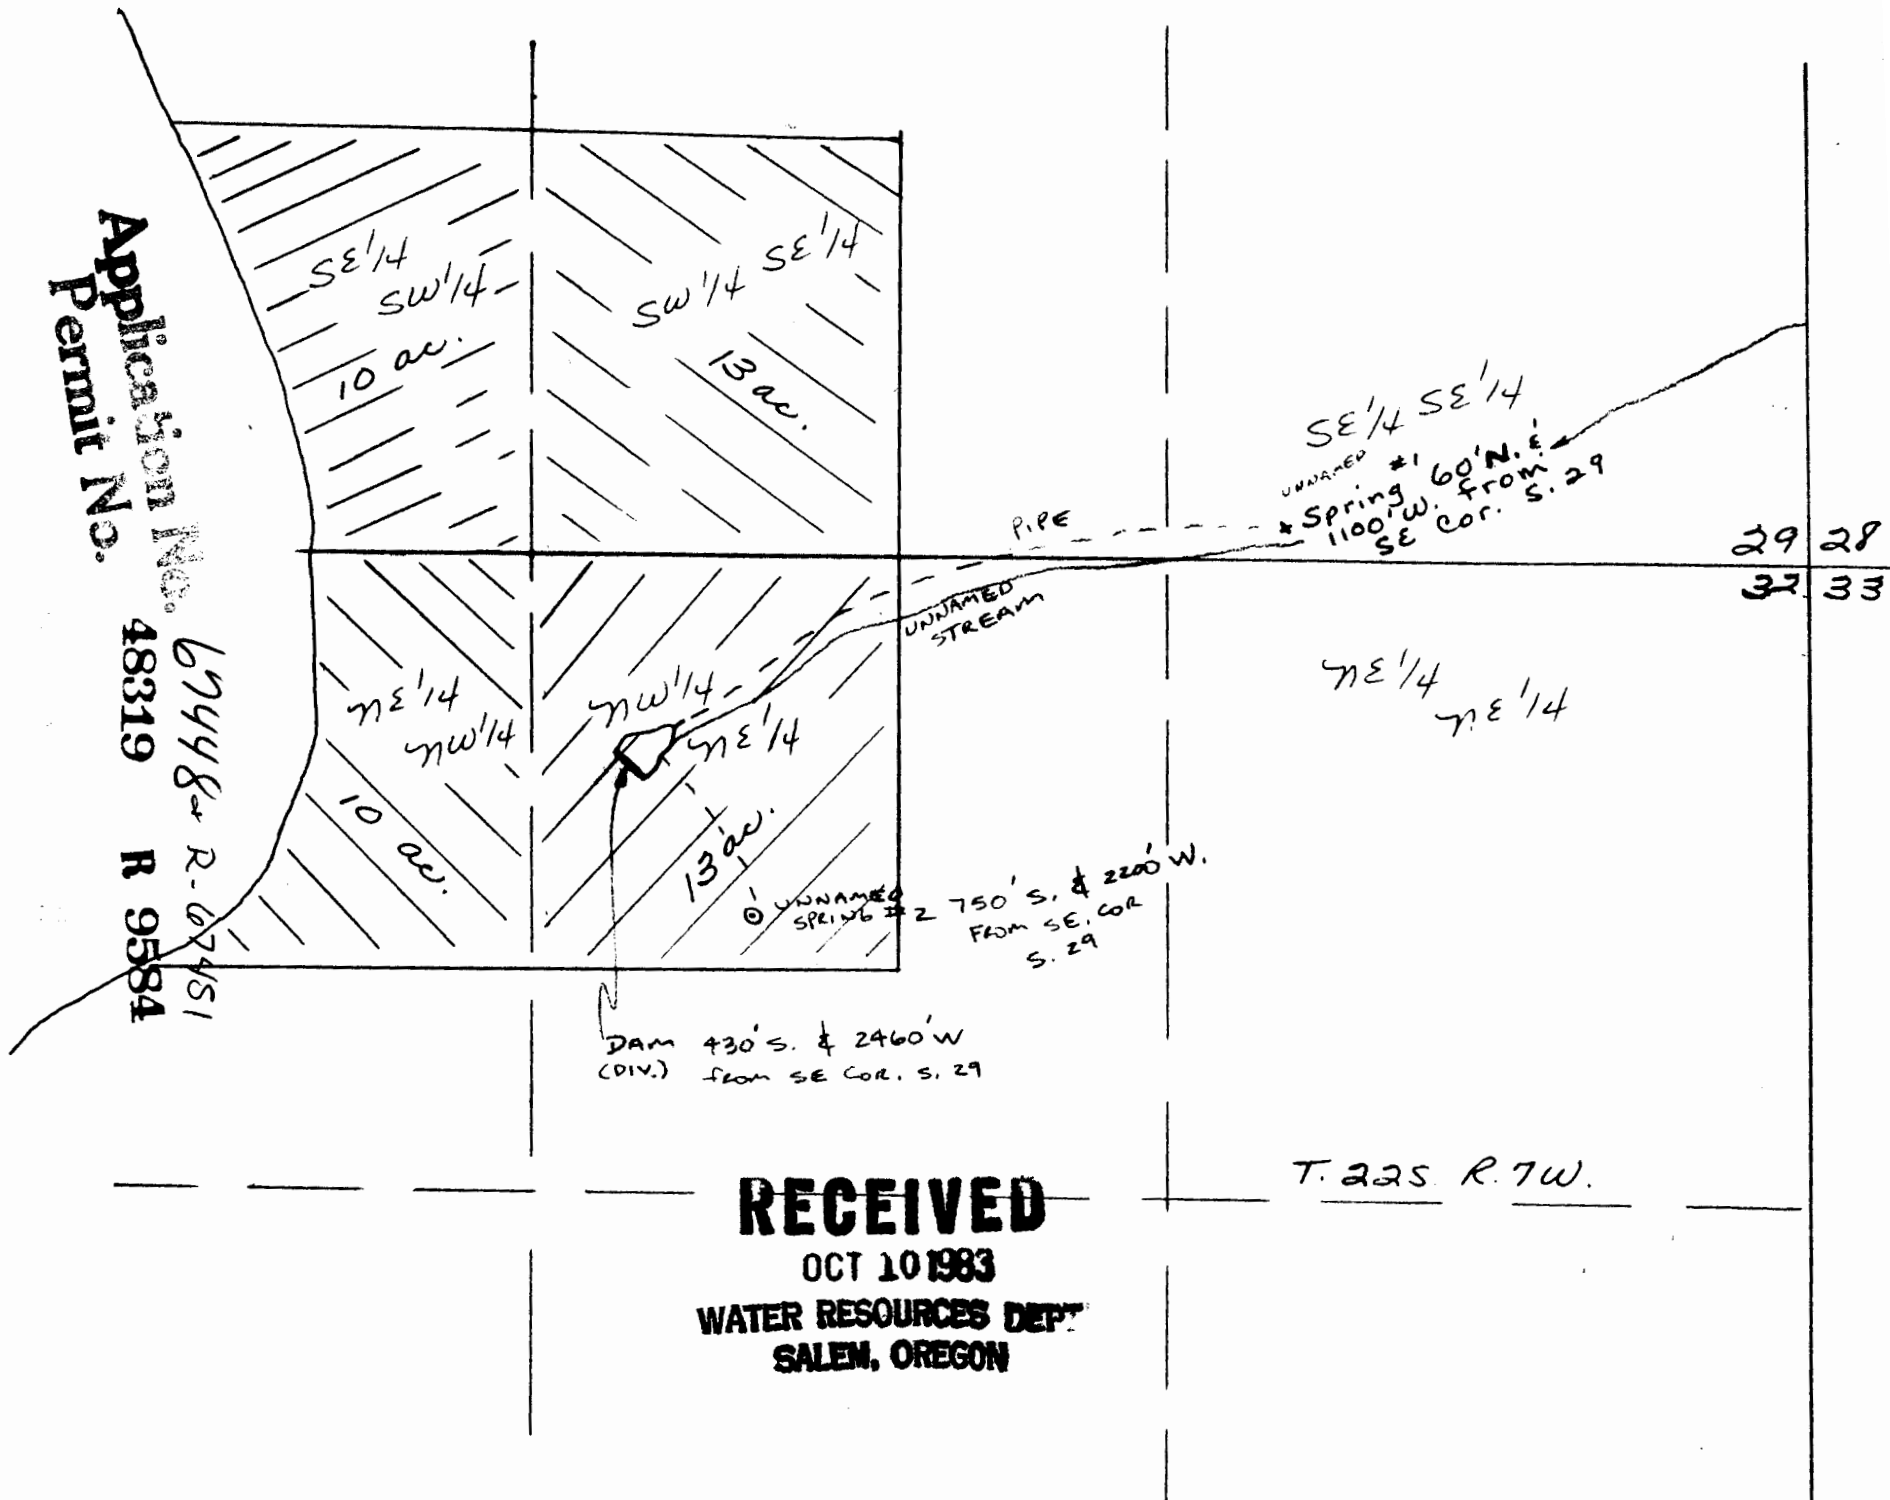

RECEIVED

OCT 10 1983

WATER RESOURCES DEPT
SALEM, OREGON

T. 22S R. 7W.

1" = 400'