


Application No. 71071  
 Permit No. 5-54139

RECEIVED

DEC 27 1990

WATER RESOURCES DEPT  
 SALEM, OREGON

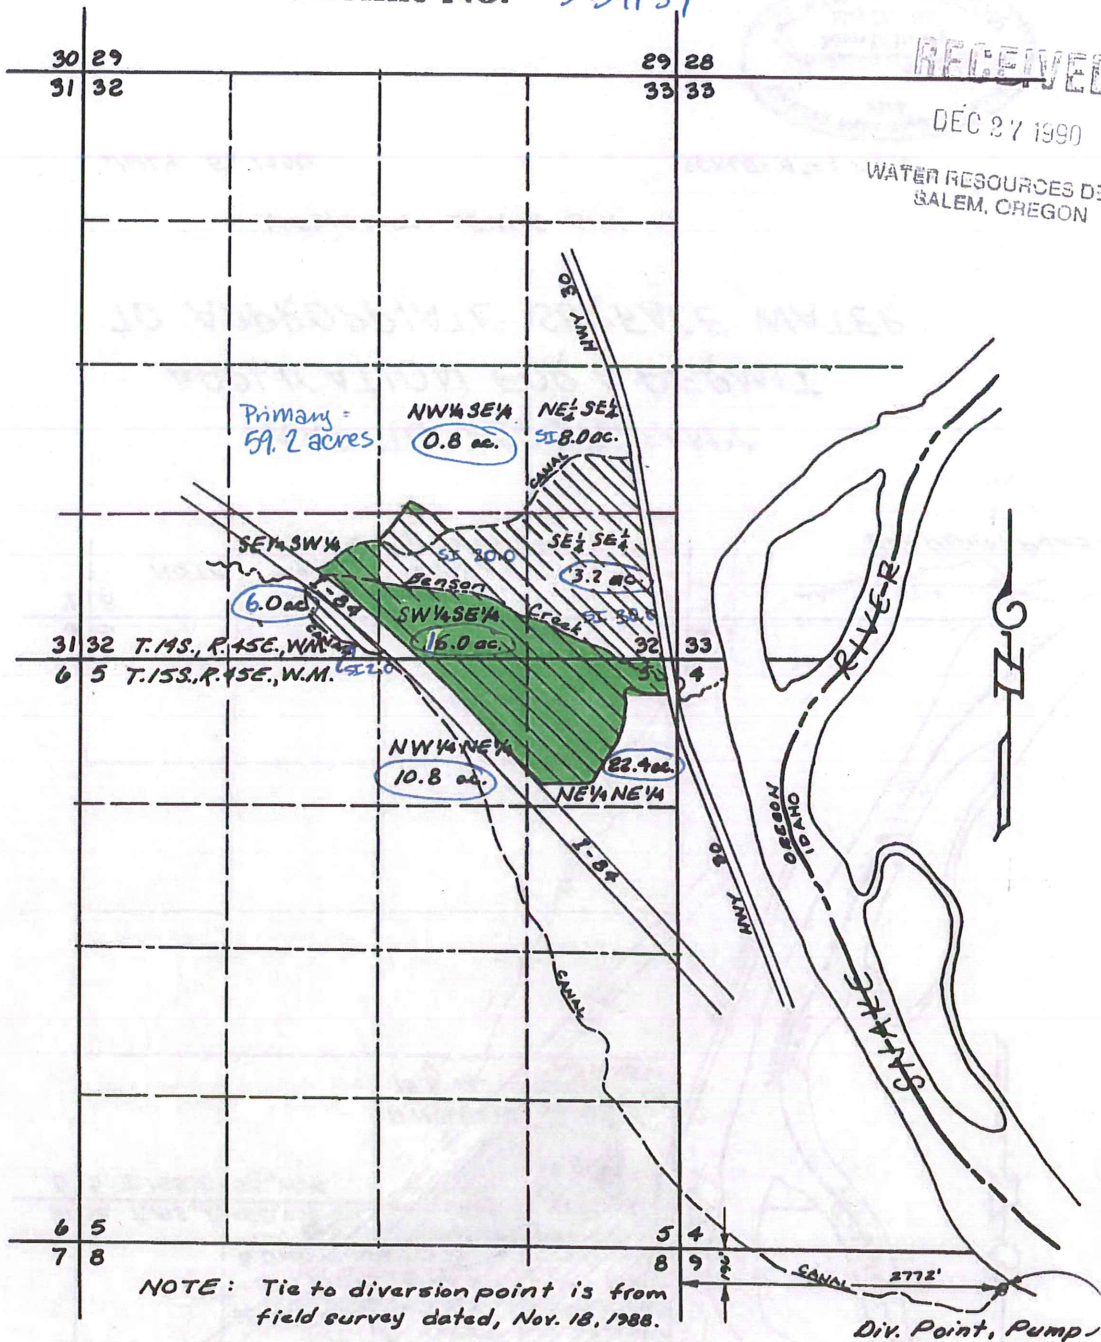

MAP TO ACCOMPANY  
 APPLICATION FOR A PERMIT  
 TO APPROPRIATE SURFACE WATER

APPLICANT: LEWIS GAY

JULY 5, 1990

SCALE: 1" = 1 Mile

- Primary Irrigation [59.2 ac]
- Supplemental Irrigation [60.0 ac]

