


MAP
 ACCOMPANYING APPLICATION
 FOR
 CHANGE IN PLACE OF USE OF WATER

Map No. 438
 Rec. No. 204

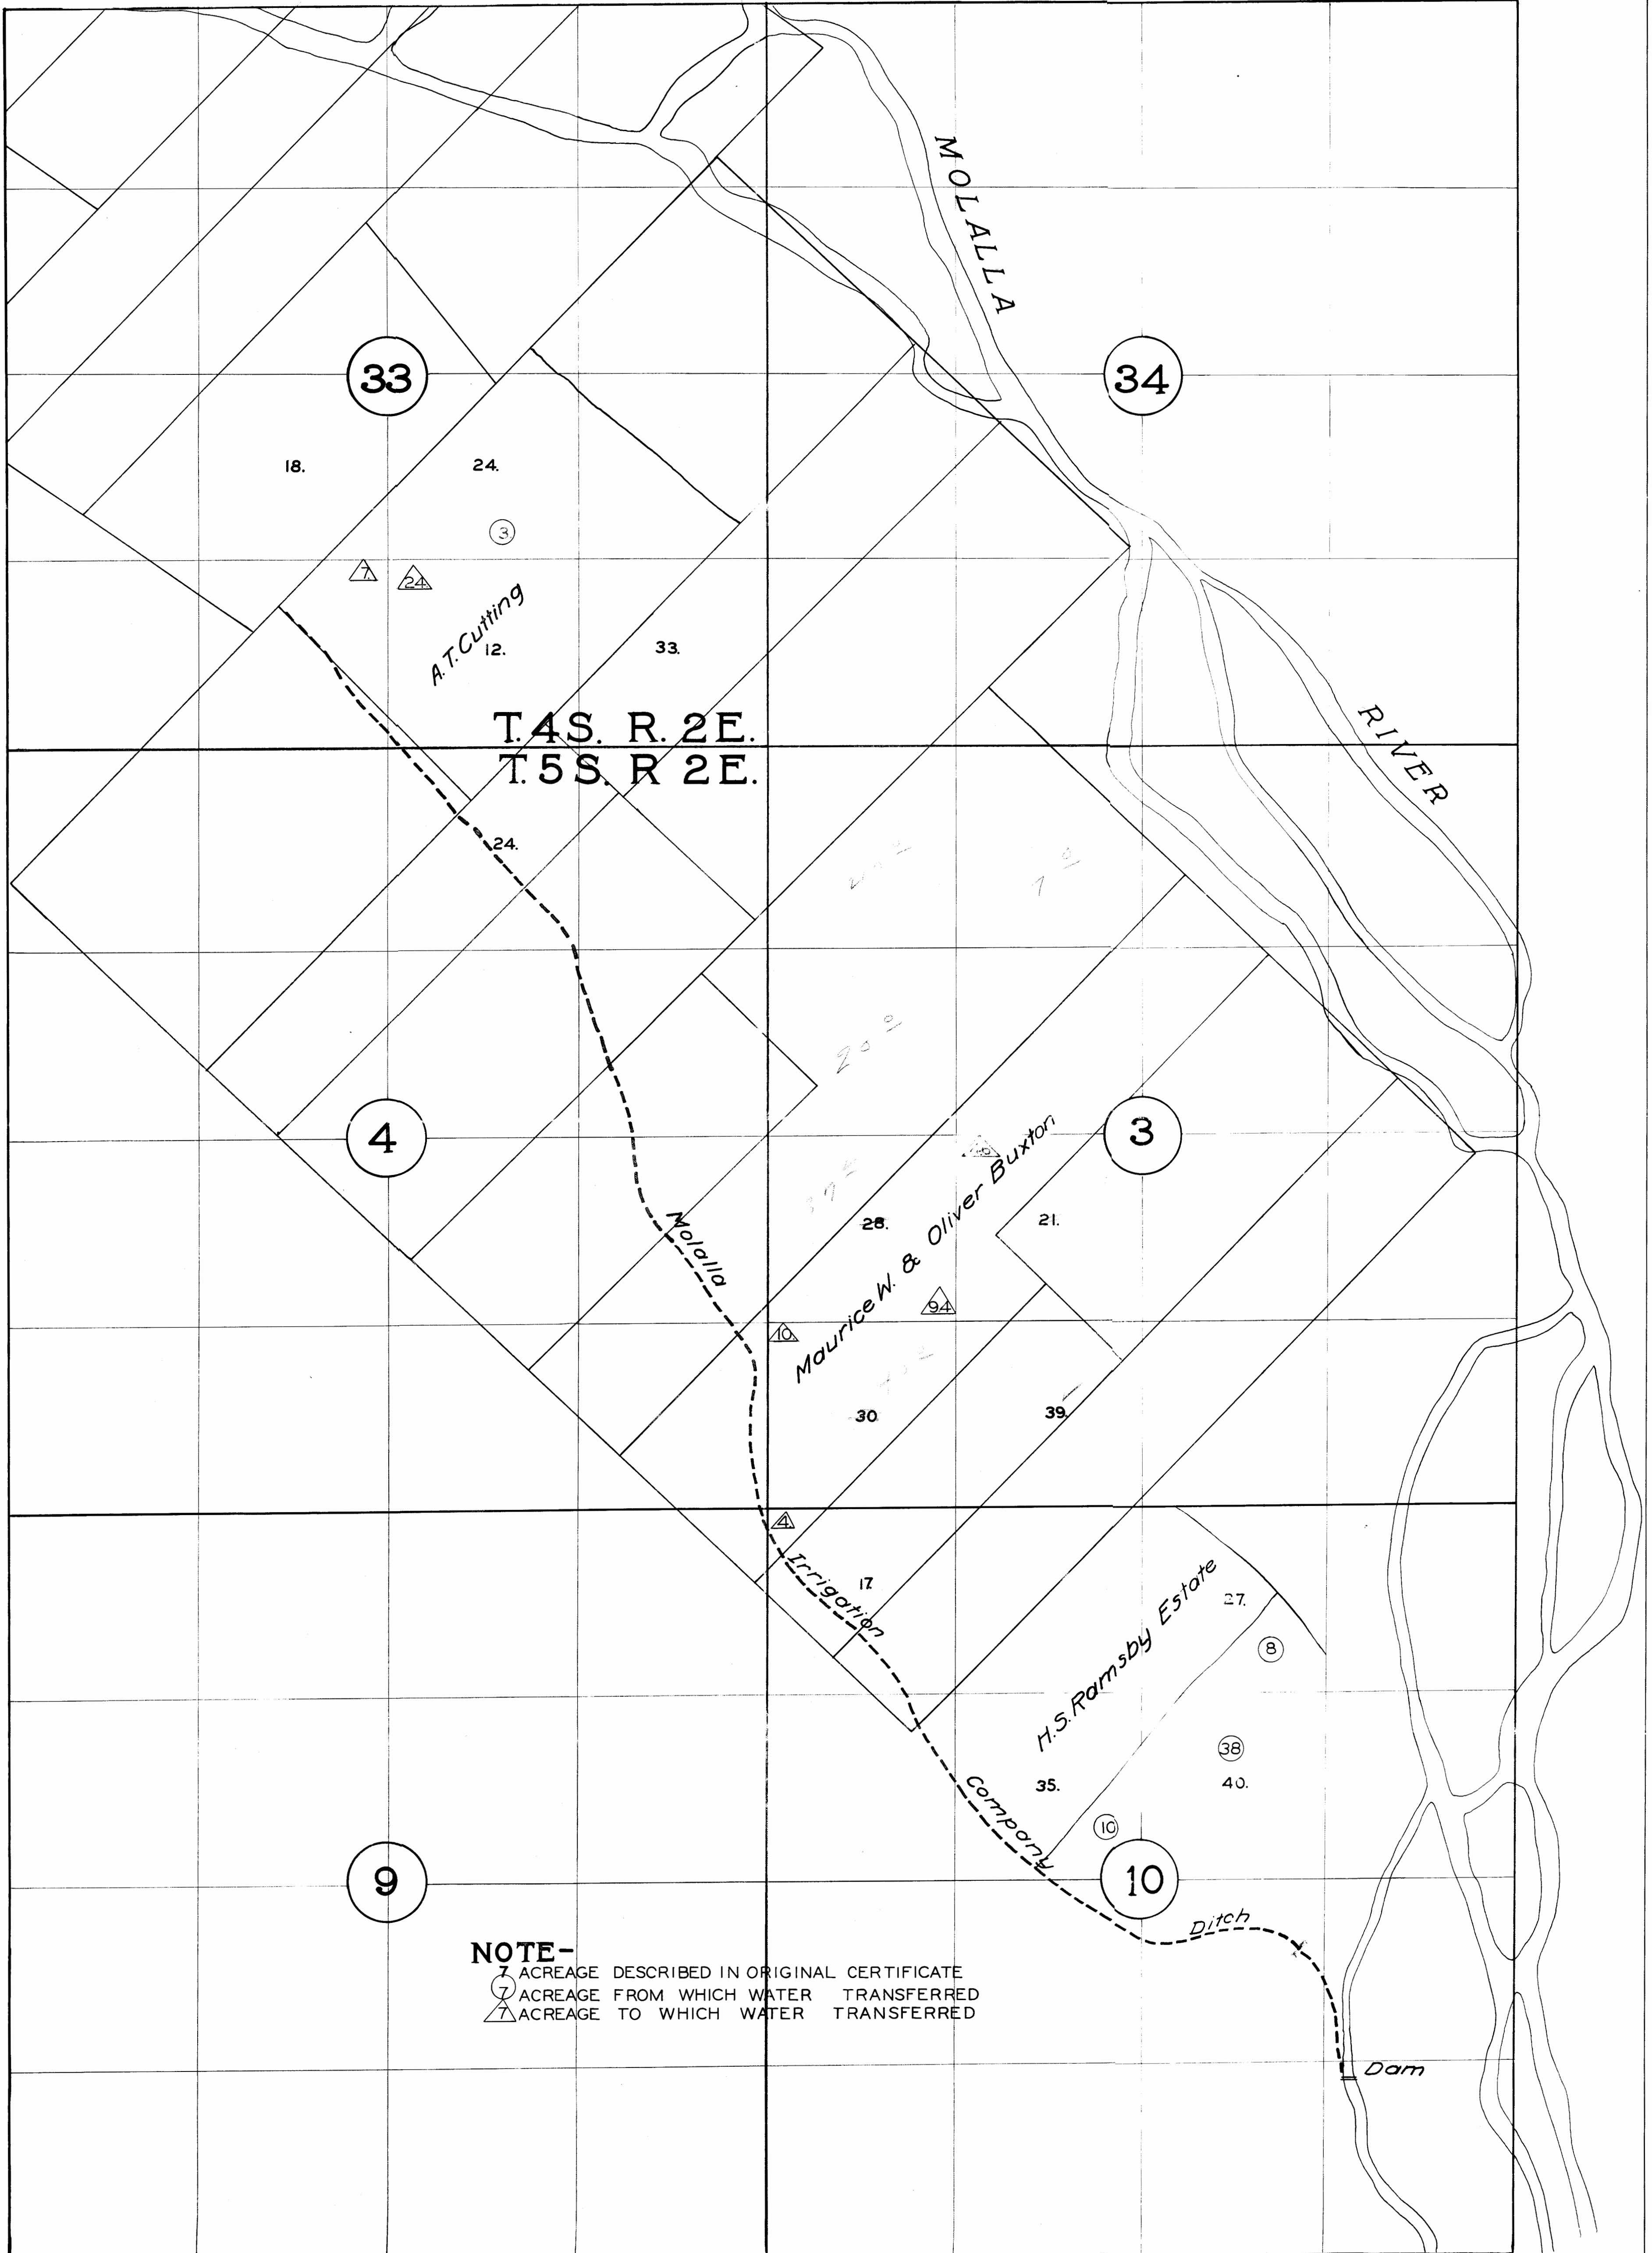

NOTE-
 ⑦ ACREAGE DESCRIBED IN ORIGINAL CERTIFICATE
 ① ACREAGE FROM WHICH WATER TRANSFERRED
 △ ACREAGE TO WHICH WATER TRANSFERRED