


CONTING II 97% LAYOUT EC 22126 TRACED 10/1/77 CHECKED 10/1/77


RECEIVED

SEP 18 1996

RECEIVED
SEP 07 1999
PL. & ENGINEERING OF OREGON
LANDSCAPE & ARCHITECTURE, INC.

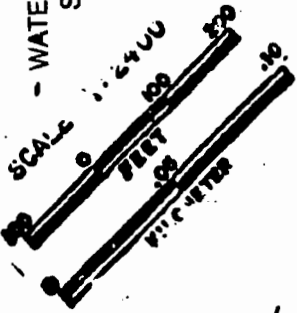

WATER RESOURCES DEPT.
SALEM, OREGON

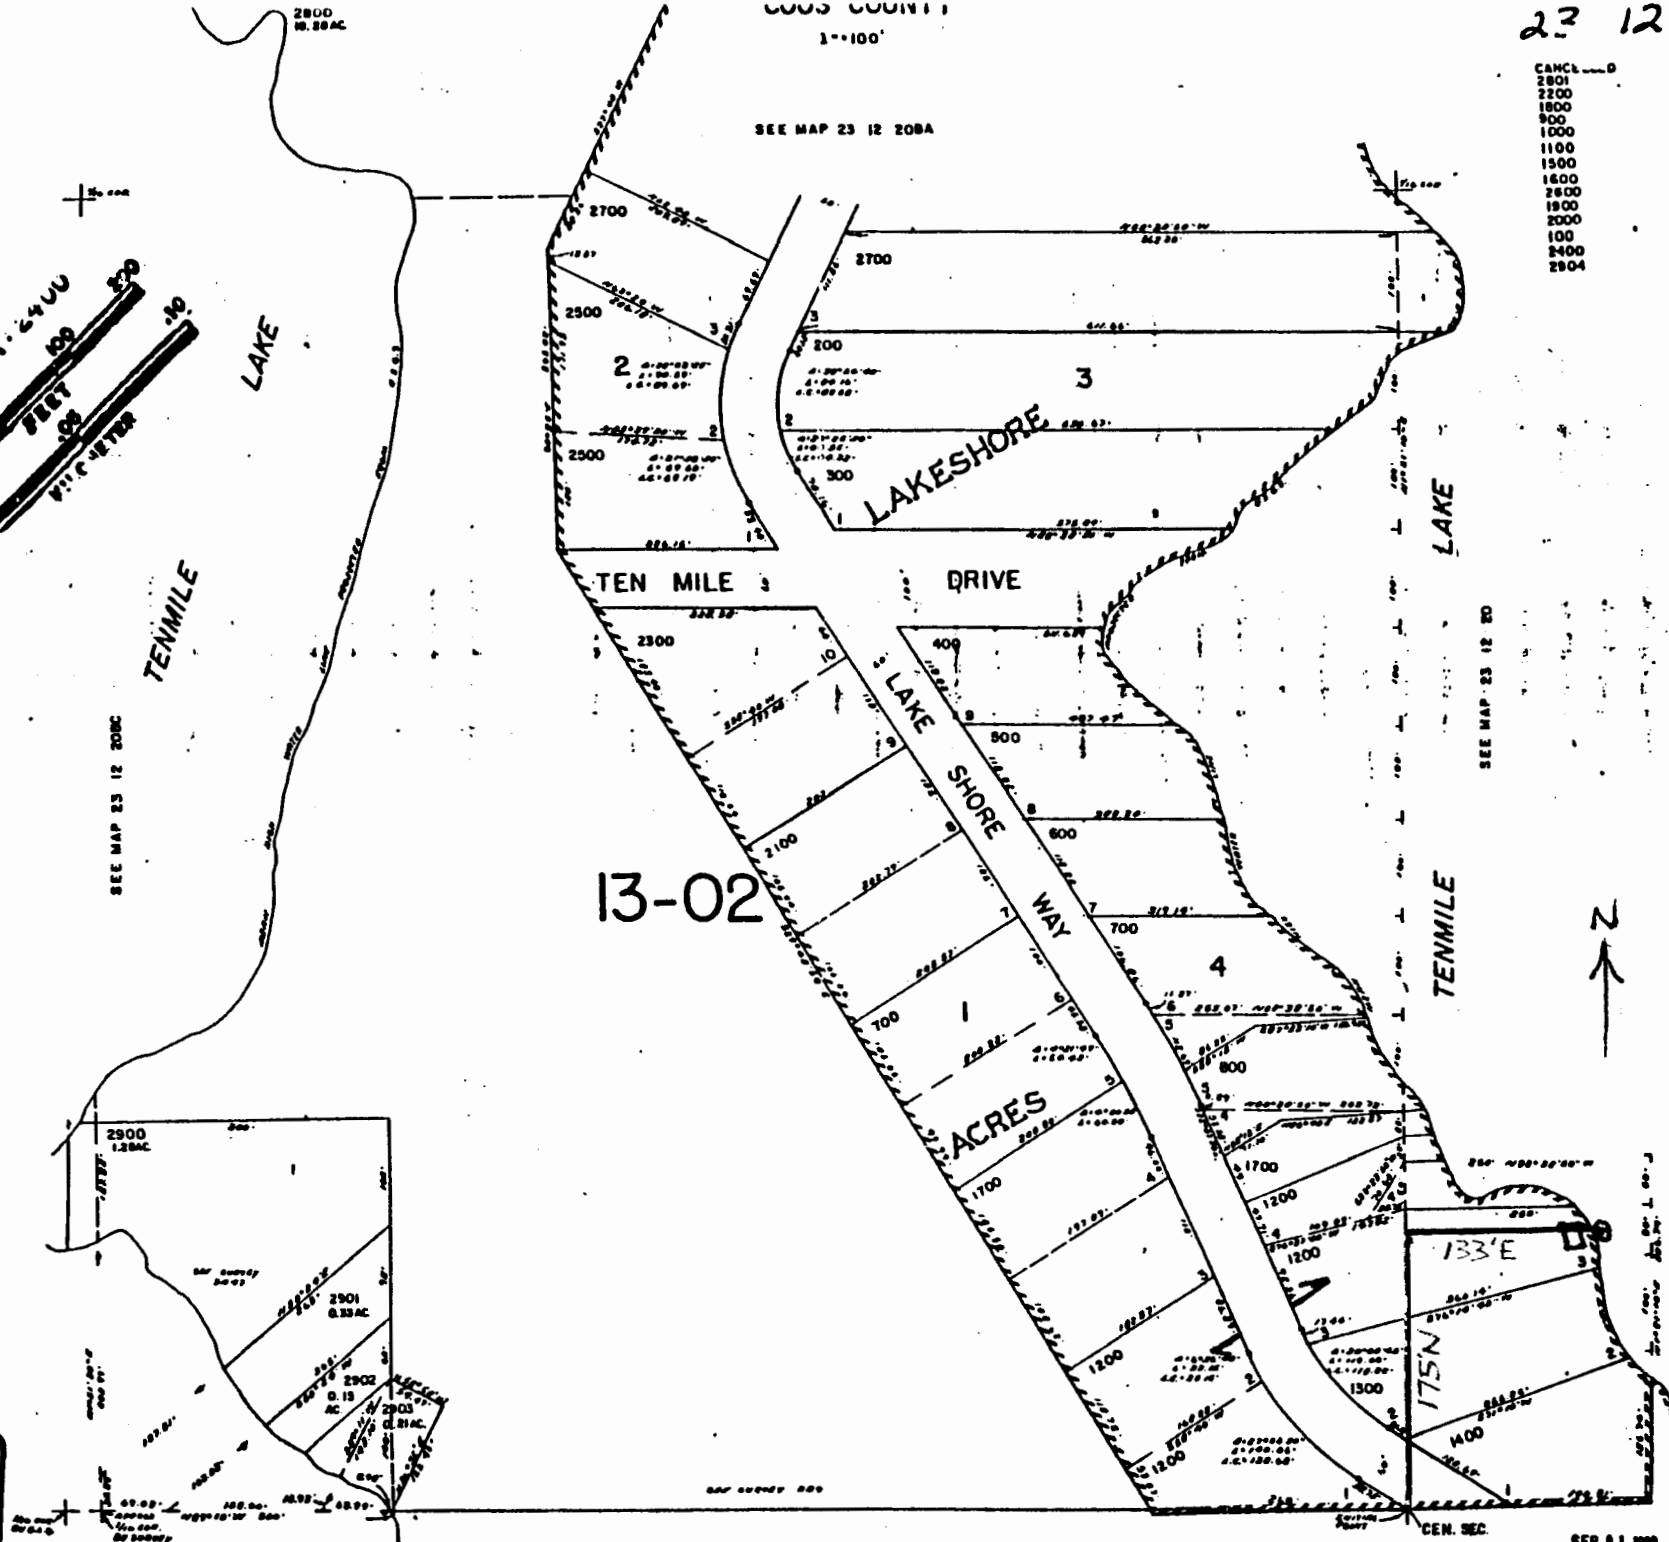

SEE MAP 23 12 208A

SEE MAP 23 12 20

23 12 208D

CANCEL
2801
2800
1800
900
1000
1100
1500
1600
2000
1900
2000
100
2400
2804

SEE MAP 23 12 20



Application No. 81552
Permit No. 53320

SEE MAP 23 12 208B

SEP 01 1999
23 12 208D