


T7N R8W SEC 19 WM
CLATSOP COUNTY

Scale 1:4800


ROAD 185391 HARRIS State/Plane Oregon North FIPS 3001 1/4 mile

Canceled
Accession
1301
1302
1303
1304
1305
1306
1307
1308
1309
1310

1"=1000'
RK AC WRD
5/28/14

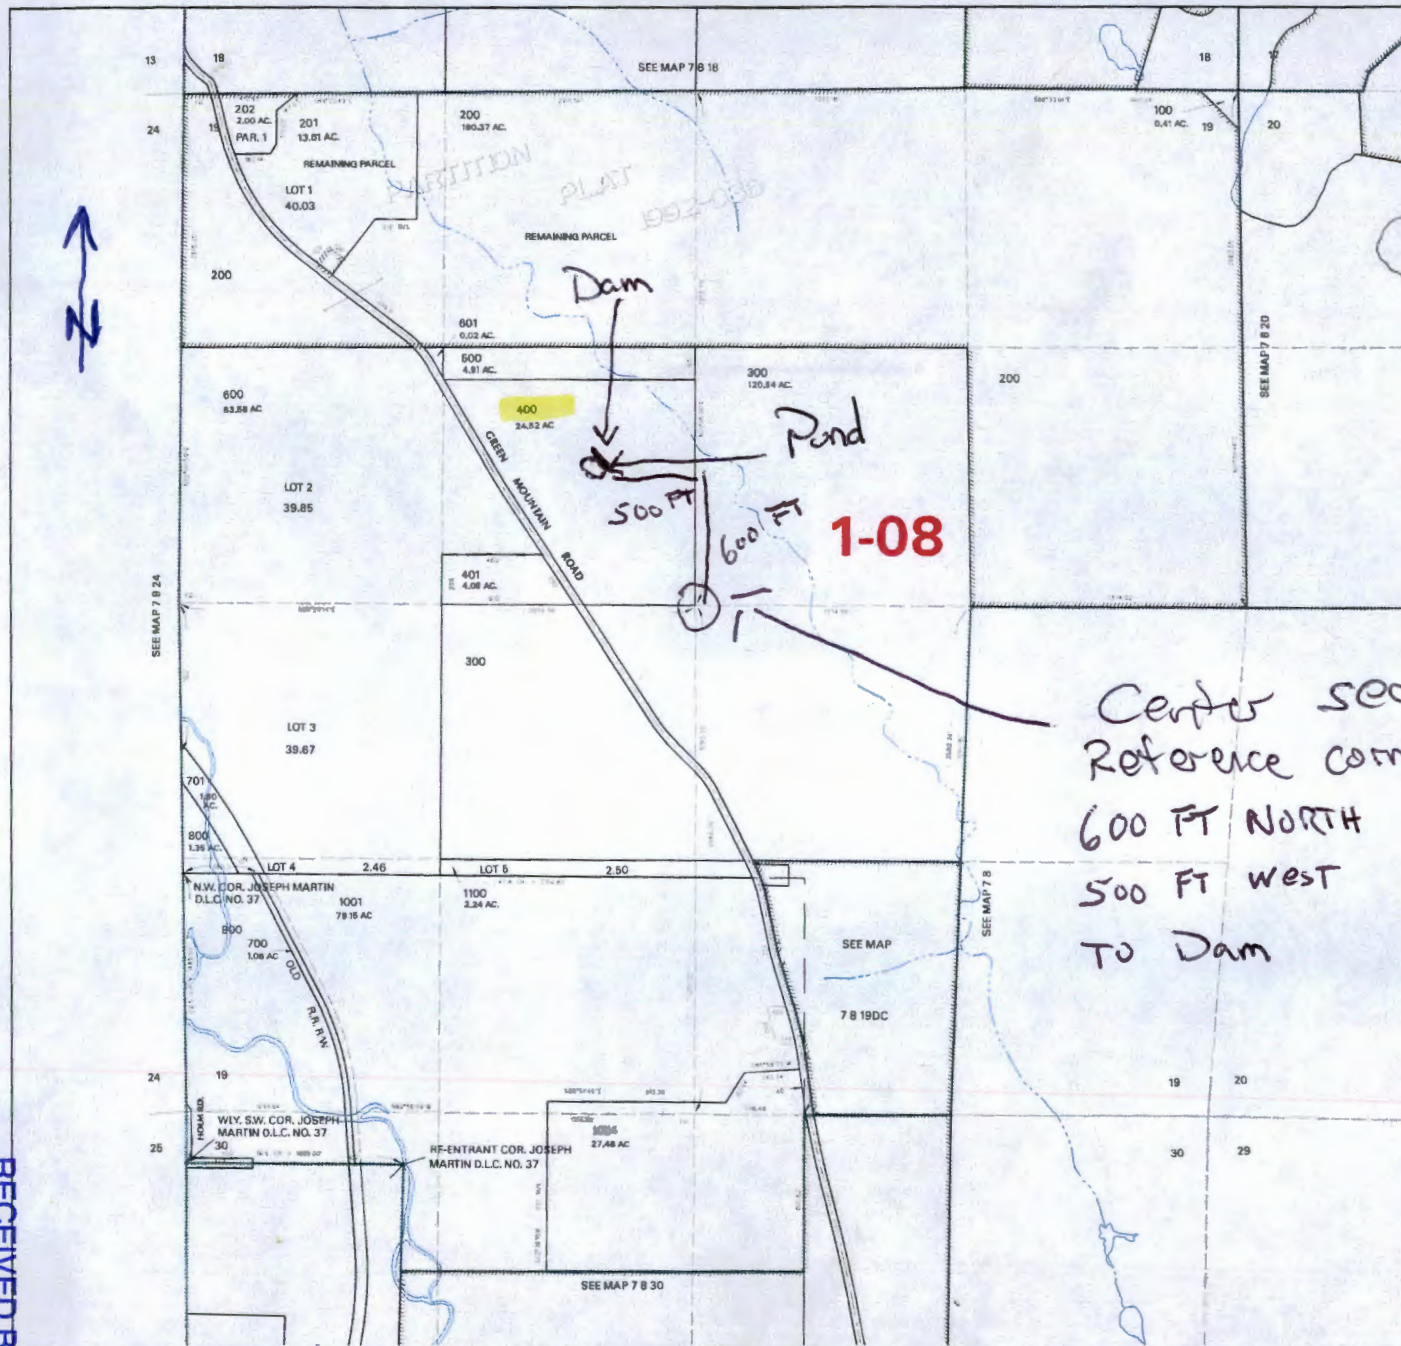

RECEIVED BY OWRD
MAY 27 2014
SALEM, OR

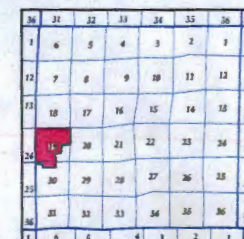

March 04, 2014



This map was produced for information purposes only using Clatsop County data. The data is maintained by Clatsop County. Clatsop County is not responsible for any errors or omissions.

7.8.19

R-87982

RECEIVED BY OWRD

JUN 05 2014

SALEM, OR