



Oregon Water Resources Department
 725 Summer Street NE, Suite A
 Salem Oregon 97301-1266
 (503) 986-0900
 www.wrd.state.or.us

Certificate of Water Right Ownership Update

NOTICE TO SELLERS & BUYERS:

By law, all water belongs to the public (ORS 537.110). In almost every instance, a permit or water right certificate from the Water Resources Department is needed before using, diverting or storing water (ORS 537.130). However, most domestic wells do not require water rights. A certificate of water right stays with the land. In order to keep track of water right ownership, the Department requests that this form be submitted to the Department. *If for multiple rights, a separate form for each right will be required.*

Water that has been used for a long time in one place or that involves a water structure (like a dam) that already exists is no guarantee that there is a water right which would allow the water use to continue.

If you have any questions about this form or water right requirements, please contact your local watermaster or call the Water Resources Department at 503-986-0900.

Note: Please type or print legibly when filling in the following information. Use additional paper if necessary.

PROPERTY SELLER INFORMATION

RECEIVED BY OWRD

Applicant(s): _____
First Last

Mailing Address: _____
City State Zip

Phone: _____
Home Work Other

APR 02 2014
 SALEM, OR

PROPERTY BUYER INFORMATION

Applicant(s): DARROLD HANNA
First Last

Mailing Address: 320 WIESEN DR.
GLIDE OR 97943
City State Zip

Phone: 541 496 0424 520-840 8726
Home Work Other cell

PROPERTY DESCRIPTION (attach additional pages if necessary):

County: Douglas Township: 26 Range: 03W Section: 34

Tax Lot Number(s): _____ R66586

Street address of water right property: 320 Wiesen Dr. Glide, OR 97943

Water Right Information (attach copy of water right permit or certificate & final proof map):

Application #: S-65031 Permit #: S-47783 Certificate or Page #: 58928

Will all the lands associated with this water right be owned by the buyer? Yes No

Name of individual completing this form: DARROLD HANNA Phone: 541 496 0424

Signature: Darroll Hanna Date: 31 March 2014


Please be sure to attach a copy of your property deed or legal description of the property.

T. 26S., R. 3 W., W.M.

RECEIVED BY OWRD

APR 02 2014

SALEM, OR

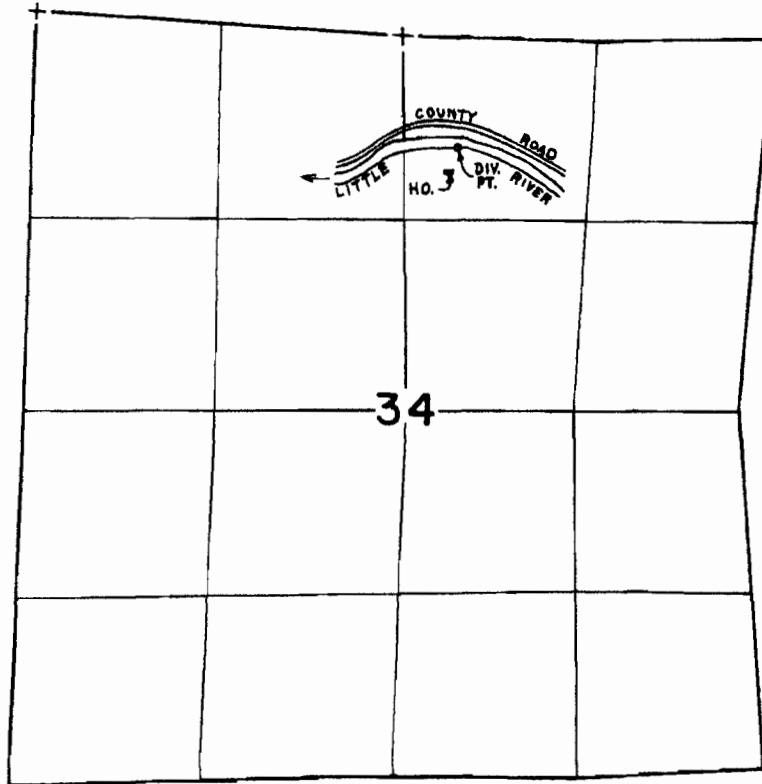

DIV. PT. LOCATED 790'S. & 380'E. FROM N. 1/4 COR. SEC. 34

SCALE: 4" = 1 mile

FINAL PROOF SURVEY
UNDER

Application No. 65031... Permit No. 47783.....
IN NAME OF

JAMES E. ALLEN

Surveyed JUL. 25, 1984, by L. CASHION...

THIS MAP WAS PREPARED FOR ASSESSMENT PURPOSE ONLY.

NE1/4 SEC.34 T.26S. R.3W. W.M.
DOUGLAS COUNTY
1" = 200'

REVISED ON
3-13-97


26 3 34A

RECEIVED BY OWRD

APR 02 2014

SALEM, OR

SEE MAP 26 3 27

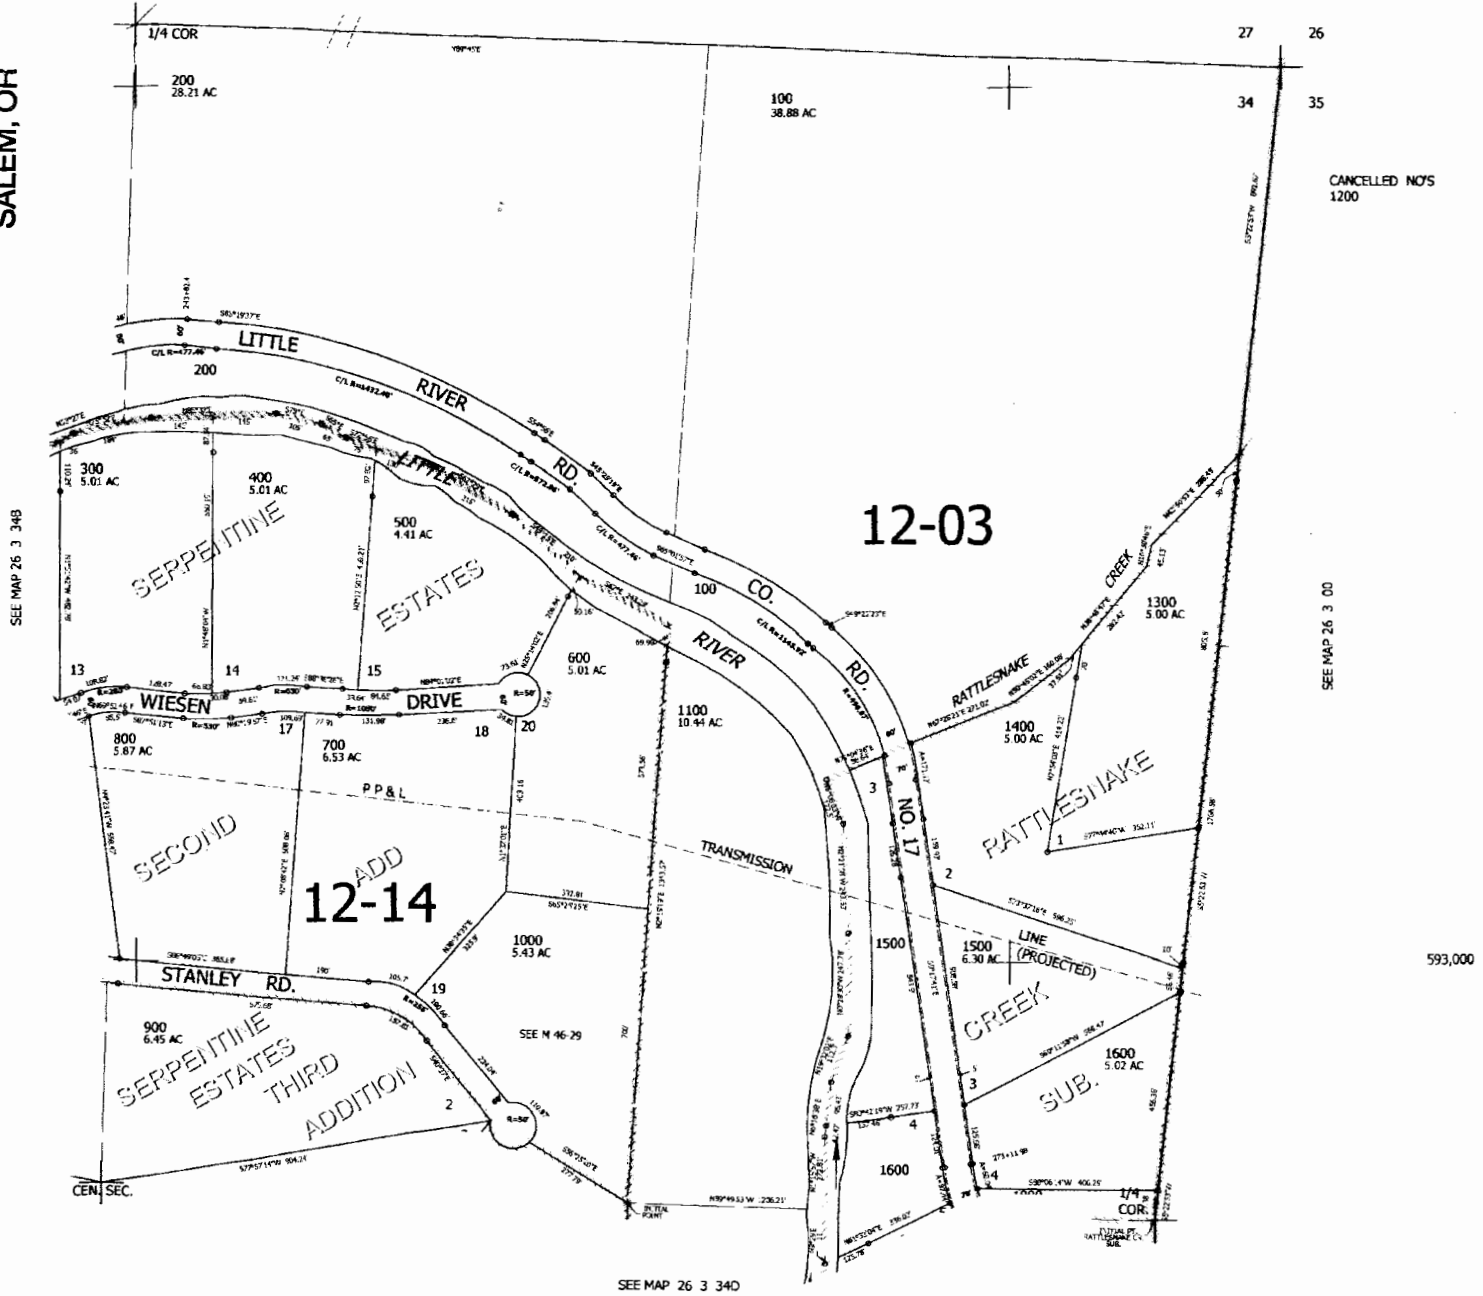

SEE MAP 26 3 34B

SEE MAP 26 3 00

CANCELLED NO'S
1200

593,000

SEE MAP 26 3 34D

4,247,000

26 3 34A

Property Details for Property ID: R66586**Owner Information :**

Owner Name: HANNA, DARROLD D & FRANKIE L
 Owner Address #1: 320 WIESEN DRIVE
 Owner Address #2:
 Owner Address # 3: Alternate Account #: 41381.00
 Owner City/State/Zip: GLIDE, OR 97443 Account Status: A

Property Information :

Township: 26 Situs Address: 320 WIESEN DR GLIDE, OR
 97443
 Range: 03W Map ID: 260334A00400
 Section: 34 County Property Class: 111
 Quarter: A Legal Acreage: 5.01
 Sixteenth: Code Area: 01214
 Maintenance Area: 7 Neighborhood Code: GCR
 Year Built: 2012 Living Area:
 Bedrooms: Baths:
 Exemption Code: Exemption Desc.:
 MFD Home ID:

Value Information : 2013-2014 Certified Values and Tax Information

Improvement Appr. Value: \$200.00	Total Appr. Value: \$136,777.00
Land Appr. Value: \$136,577.00	Exemption Value: \$0.00
Land Market Value: \$136,577.00	Total Assessed Value: \$111,188.00
Total Real Market Value: \$136,777.00	Taxes Imposed: \$1,244.99

Sales Information :

Deed No: 2013-17379
 Sale Price: \$120,000.00 Sale Date: 10/3/2013

DISCLAIMER

The information provided here is for convenience ONLY. For All Commercial, Industrial, and Multi-Family Properties visit the Douglas County Assessor's Office. The records located at the Douglas County Assessor's office are the one and only legal instruments for Assessment purposes. Although reasonable attempts are made to maintain this information as accurate as possible, these documents are being provided as an informational convenience ONLY. Douglas County in no way will be liable for any inaccuracies, inconsistencies, errors, omissions, or other deviations in these documents from the original copies maintained and filed at the Douglas County Assessor's Office.

RECEIVED BY OWRD

APR 02 2014

SALEM, OR