r A1-187
rch 1961

UNITED STATES
DEPARTMENT OF THE INTERIOR
BUREAU OF LAND MANAGEMENT

Oregon State Water Filings

TOWNSHIP 22S, RANGE 38E, W. M.

ECTION
24

Trenton Reservoir

North

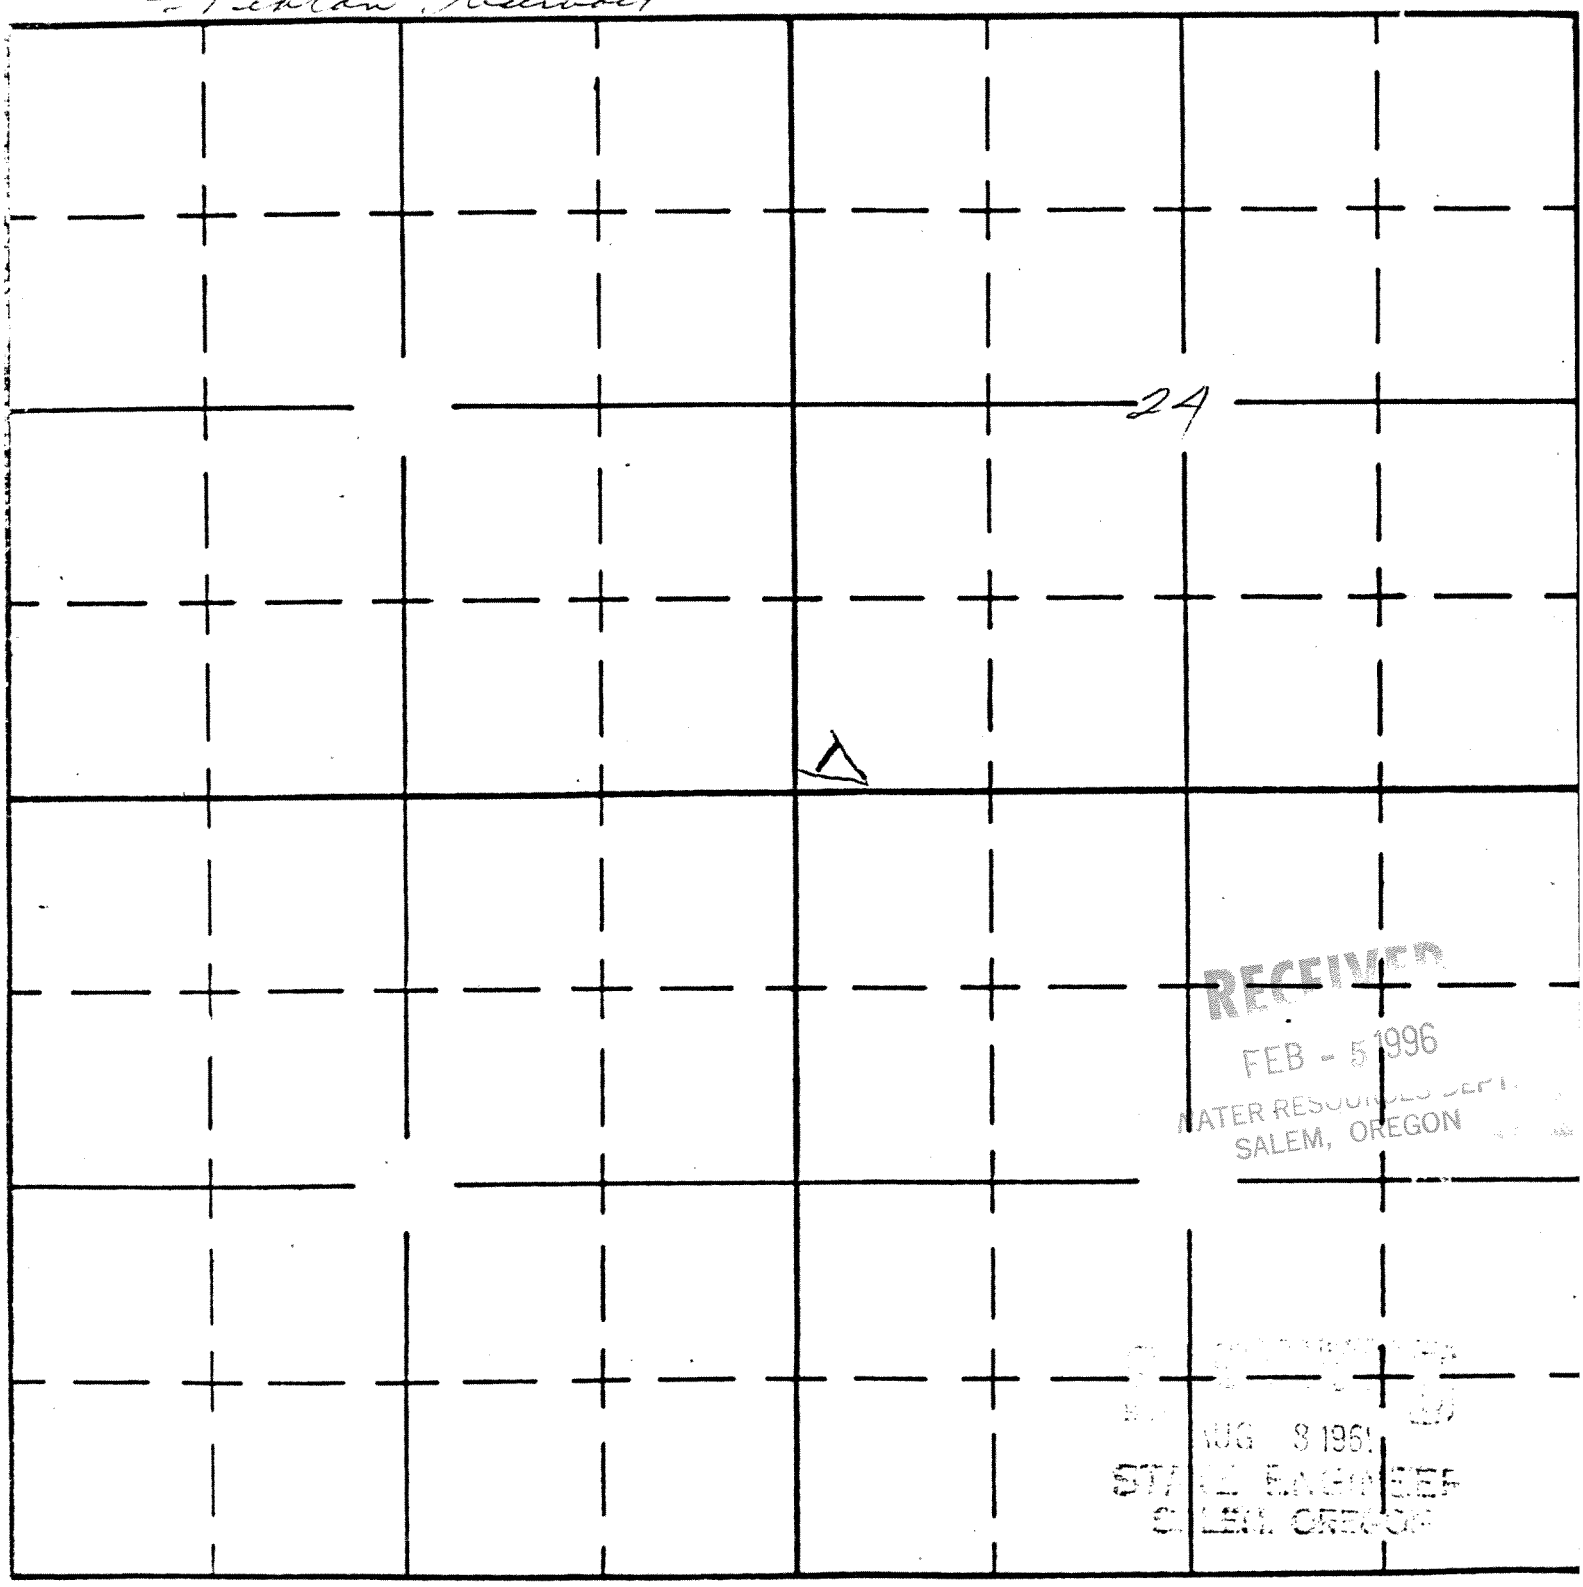

RECEIVED
FEB - 5 1996
WATER RESOURCES DEPT.
SALEM, OREGON

AUG 8 1961
STATE ENGINEER
SALEM, OREGON

South

APPLICATION No. R-3682
Q 338