


SEC. 22, TOWNSHIP 31 SOUTH, RANGE 11 EAST, W. M.

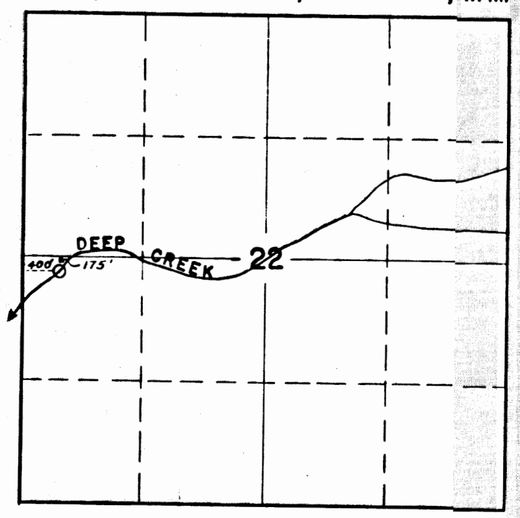


SEC. 17, TOWNSHIP 31 SOUTH, RANGE 13 EAST, W. M.

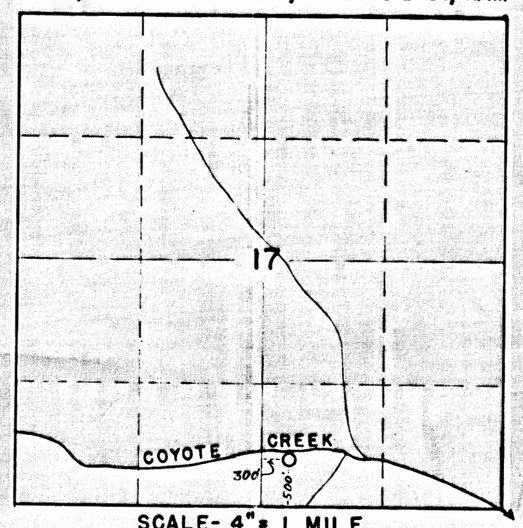

SEC. 6, TOWNSHIP 32 SOUTH, RANGE 13 EAST, W. M.

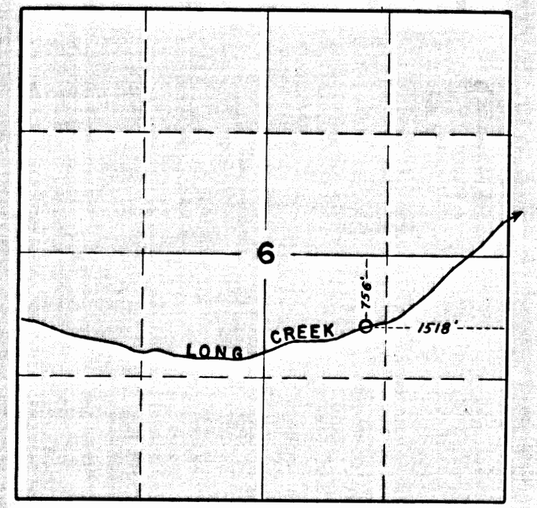

SCALE- 4" = 1 MILE

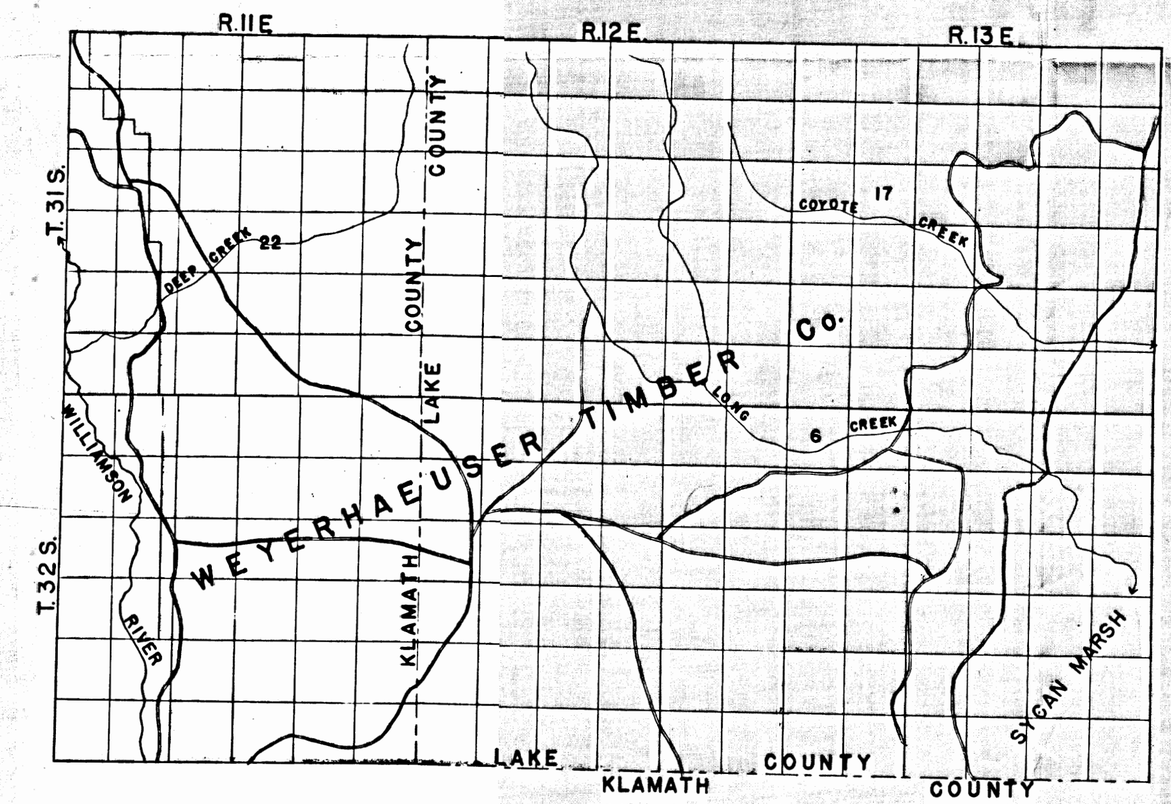

VICINITY MAP SCALE- 1/2" = 1 MILE

I, G.M. Upington of Weyerhaeuser Timber Company do hereby certify that this map was made from notes taken during an actual survey made under my immediate supervision on June 24-29, 1954; that the monuments shown on this map consisting of 1" iron pipes 36" long are 400' East and 175' South from West quarter corner, Section 22, T. 31 S., R. 11 E., W.M.; 300' East and 500' North from South quarter corner, Section 17, T. 31 S., R. 13 E., W.M.; and 1518' West and 756' South from East quarter corner, Section 6, T. 32 S., R. 13 E., W.M.

RECEIVED
SEP 8 1954
STATE ENGINEER
SALEM, OREGON

REGISTERED PROFESSIONAL ENGINEER 1489 REGON SEPT. 24, 1952 G. M. UPINGTON


Application No. 29461
Permit No. 23241

APPLICATION FOR WATER RIGHT


WEYERHAEUSER TIMBER COMPANY
KLAMATH FALLS BRANCH

SCALE- AS SHOWN
DEL. - CHR
TRACED - CHR
DATE- APRIL 12, 1954
CHECKED BY- G.M.U.
DRAWING NO- K141


SEC. 22, TOWNSHIP 31 SOUTH, RANGE 11 EAST, W. M.

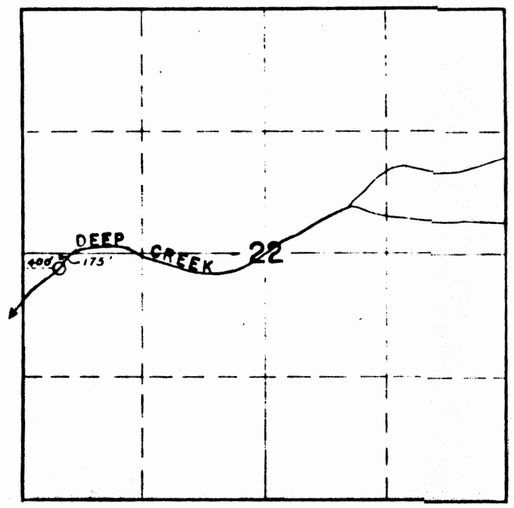


SEC. 17, TOWNSHIP 31 SOUTH, RANGE 13 EAST, W. M.

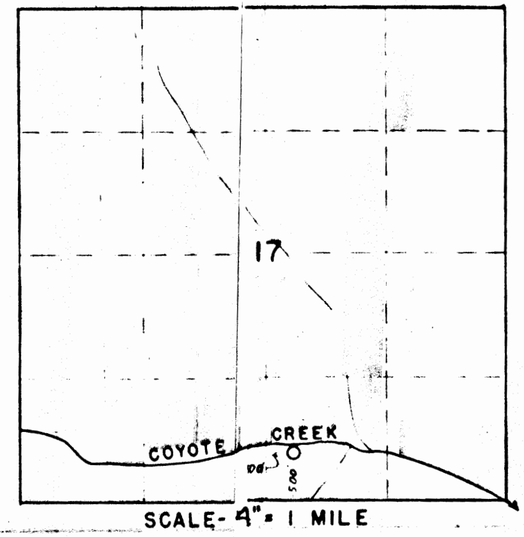

SEC. 6, TOWNSHIP 32 SOUTH, RANGE 13 EAST, W.M.

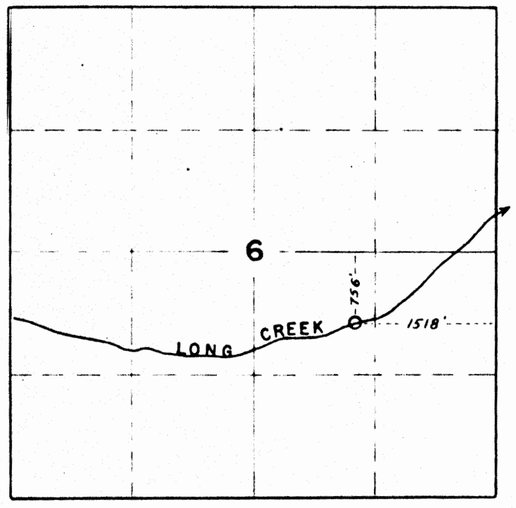

SCALE- 4" = 1 MILE

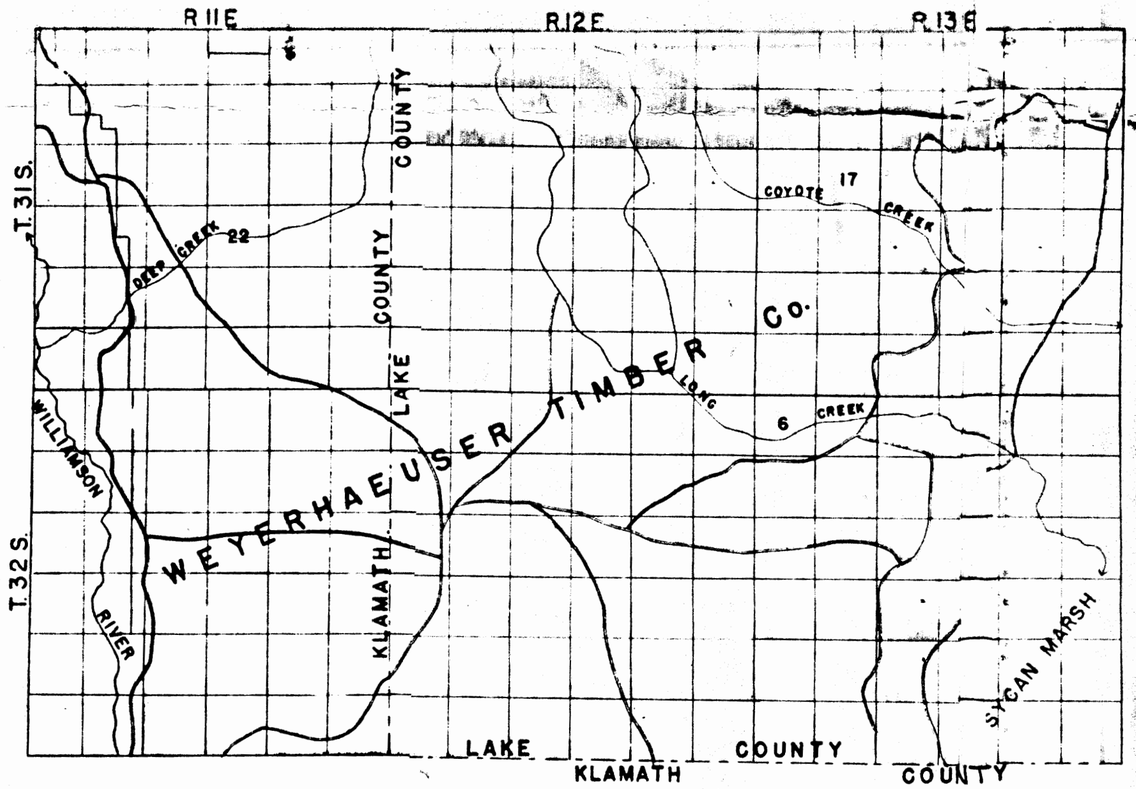

VICINITY MAP SCALE- 1/2" = 1 MILE

I, G.M. Upington of Weyerhaeuser Timber Company do hereby certify that this map was made from notes taken during an actual survey made under my immediate supervision on June 24-29, 1954; that the monuments shown on this map consisting of 1" iron pipes 36" long are 400' East and 175' South from West quarter corner, Section 22, T. 31 S., R. 11 E., W.M.; 300' East and 500' North from South quarter corner, Section 17, T. 31 S., R. 13 E., W.M.; and 1518' West and 756' South from East quarter corner, Section 6, T. 32 S., R. 13 E., W.M.

G M Upington

Application No. 29461
Permit No. 28241


APPLICATION FOR WATER RIGHT

WEYERHAEUSER TIMBER COMPANY
KLAMATH FALLS BRANCH


SCALE- AS SHOWN
DEL. - CMH
TRACED - CMH
DATE- APRIL 12, 1954
CHECKED BY- G.M.U.
DRAWING NO- K141

RECEIVED
NOV 10 2014
WATER RESOURCES DEPT.
SALEM, OREGON

SEC. 22, TOWNSHIP 31 SOUTH, RANGE 11 EAST, W. M.

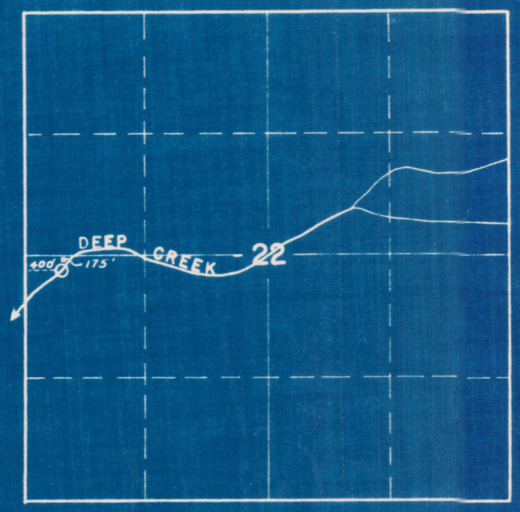



SEC. 17, TOWNSHIP 31 SOUTH, RANGE 13 EAST, W. M.

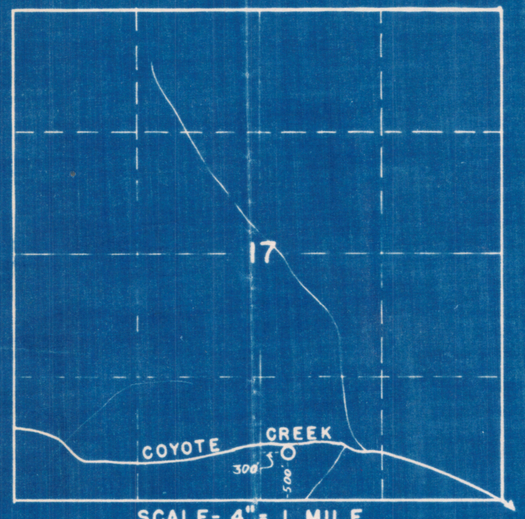

SCALE- 4" = 1 MILE

SEC. 6, TOWNSHIP 32 SOUTH, RANGE 13 EAST, W.M.

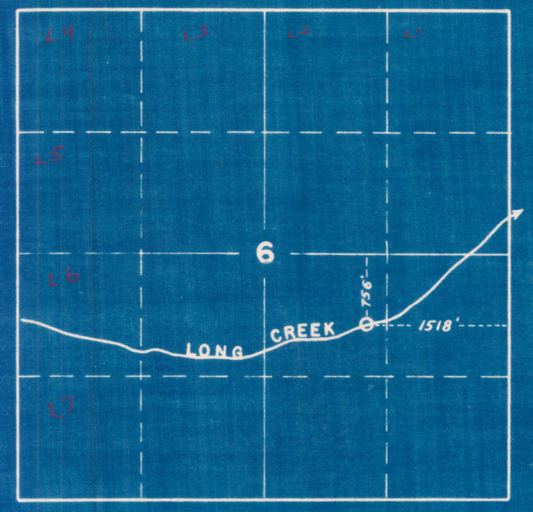

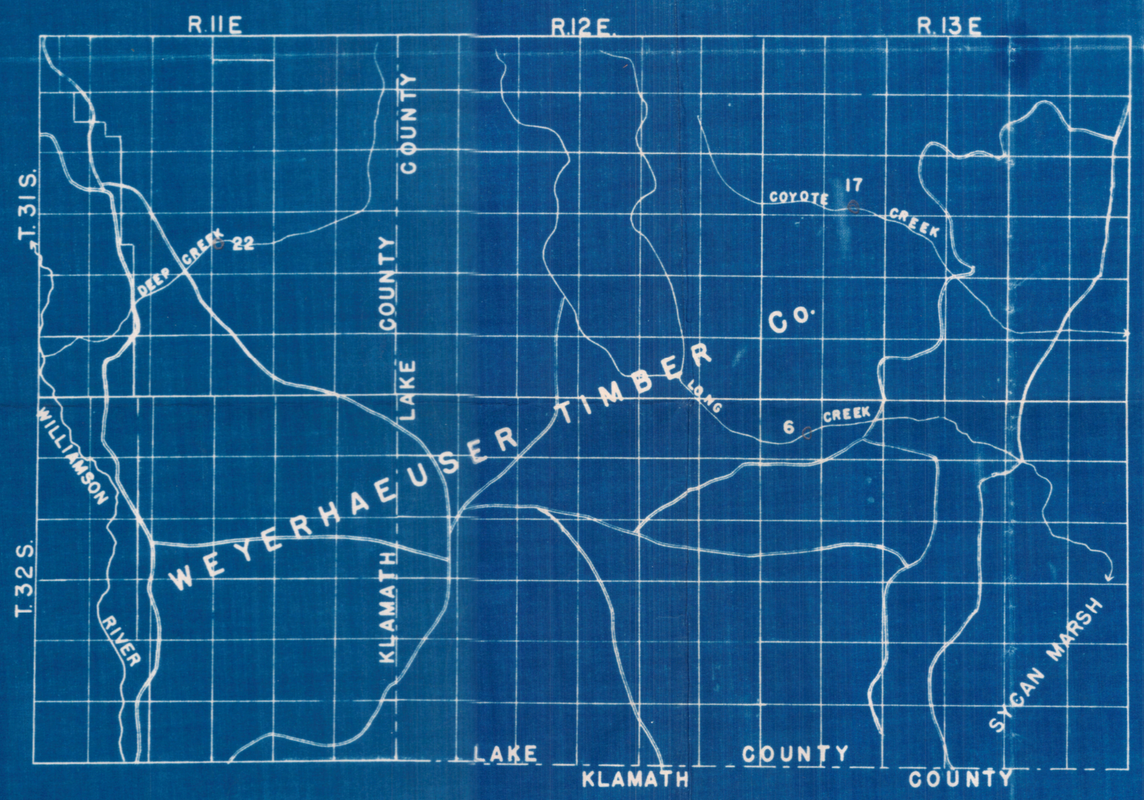

VICINITY MAP SCALE- 1/2" = 1 MILE

I, G.M. Upington of Weyerhaeuser Timber Company do hereby certify that this map was made from notes taken during an actual survey made under my immediate supervision on June 24-29, 1954; that the monuments shown on this map consisting of 1" iron pipes 36" long are 400' East and 175' South from West quarter corner, Section 22, T. 31 S., R. 11 E., W.M.; 300' East and 500' North from South quarter corner, Section 17, T. 31 S., R. 13 E., W.M.; and 1518' West and 756' South from East quarter corner, Section 6, T. 32 S., R. 13 E., W.M.

G. M. Upington

REGISTERED PROFESSIONAL ENGINEER 293 OREGON

Application No. 29461
Permit No. 23241

APPLICATION FOR WATER RIGHT

WEYERHAEUSER TIMBER COMPANY
KLAMATH FALLS BRANCH

SCALE- AS SHOWN
DEL. - C.M.H.
TRACED - C.M.H.

DATE- APRIL 12, 1954
CHECKED BY- G.M.U.
DRAWING NO- K141

DRW. K 109-3

R. 11 E

R. 12 E

R. 13 E.

T. 31 S.

T. 32 S.

DRW. K 101-3

KLAMATH COUNTY

LAKE COUNTY

WILLIAMSON RIVER

DEEP CREEK

COYOTE CREEK

LONG CREEK

KLAMATH MARSH

KING CABIN

LOOKOUT

MAIN LINE

LEGEND

Survey only	-----	Logged previous to 19	
Completed grade	———	No timber-Abandoned 19	
Steel down	———	Logged during 19	
Abandoned grade	———	Old logging	

RAILROAD LOCATION AND CUTTING RECORD
BLOCK 7

WEYERHAEUSER TIMBER COMPANY
KLAMATH FALLS BRANCH

SCALE- 2" = 1 MILE | CORRECTED TO 1954 | DATE- JAN. 22, 1944
DEL.- | CHECKED BY- [illegible]
TRACED- CHK | DRAWING NO.- K109-1