


DEPARTMENT OF AGRICULTURE
 FOREST SERVICE
 DISTRICT FORESTER
 NATIONAL FOREST
 REGION
 T. 24 S.
 1968
 1" = 1 MILE
 2 3
 LEGEND

Main Haul Roads
 T. 24 S.

R. 8 E. BEND 48 MILES 40' R. 9 E. R. 10 E.

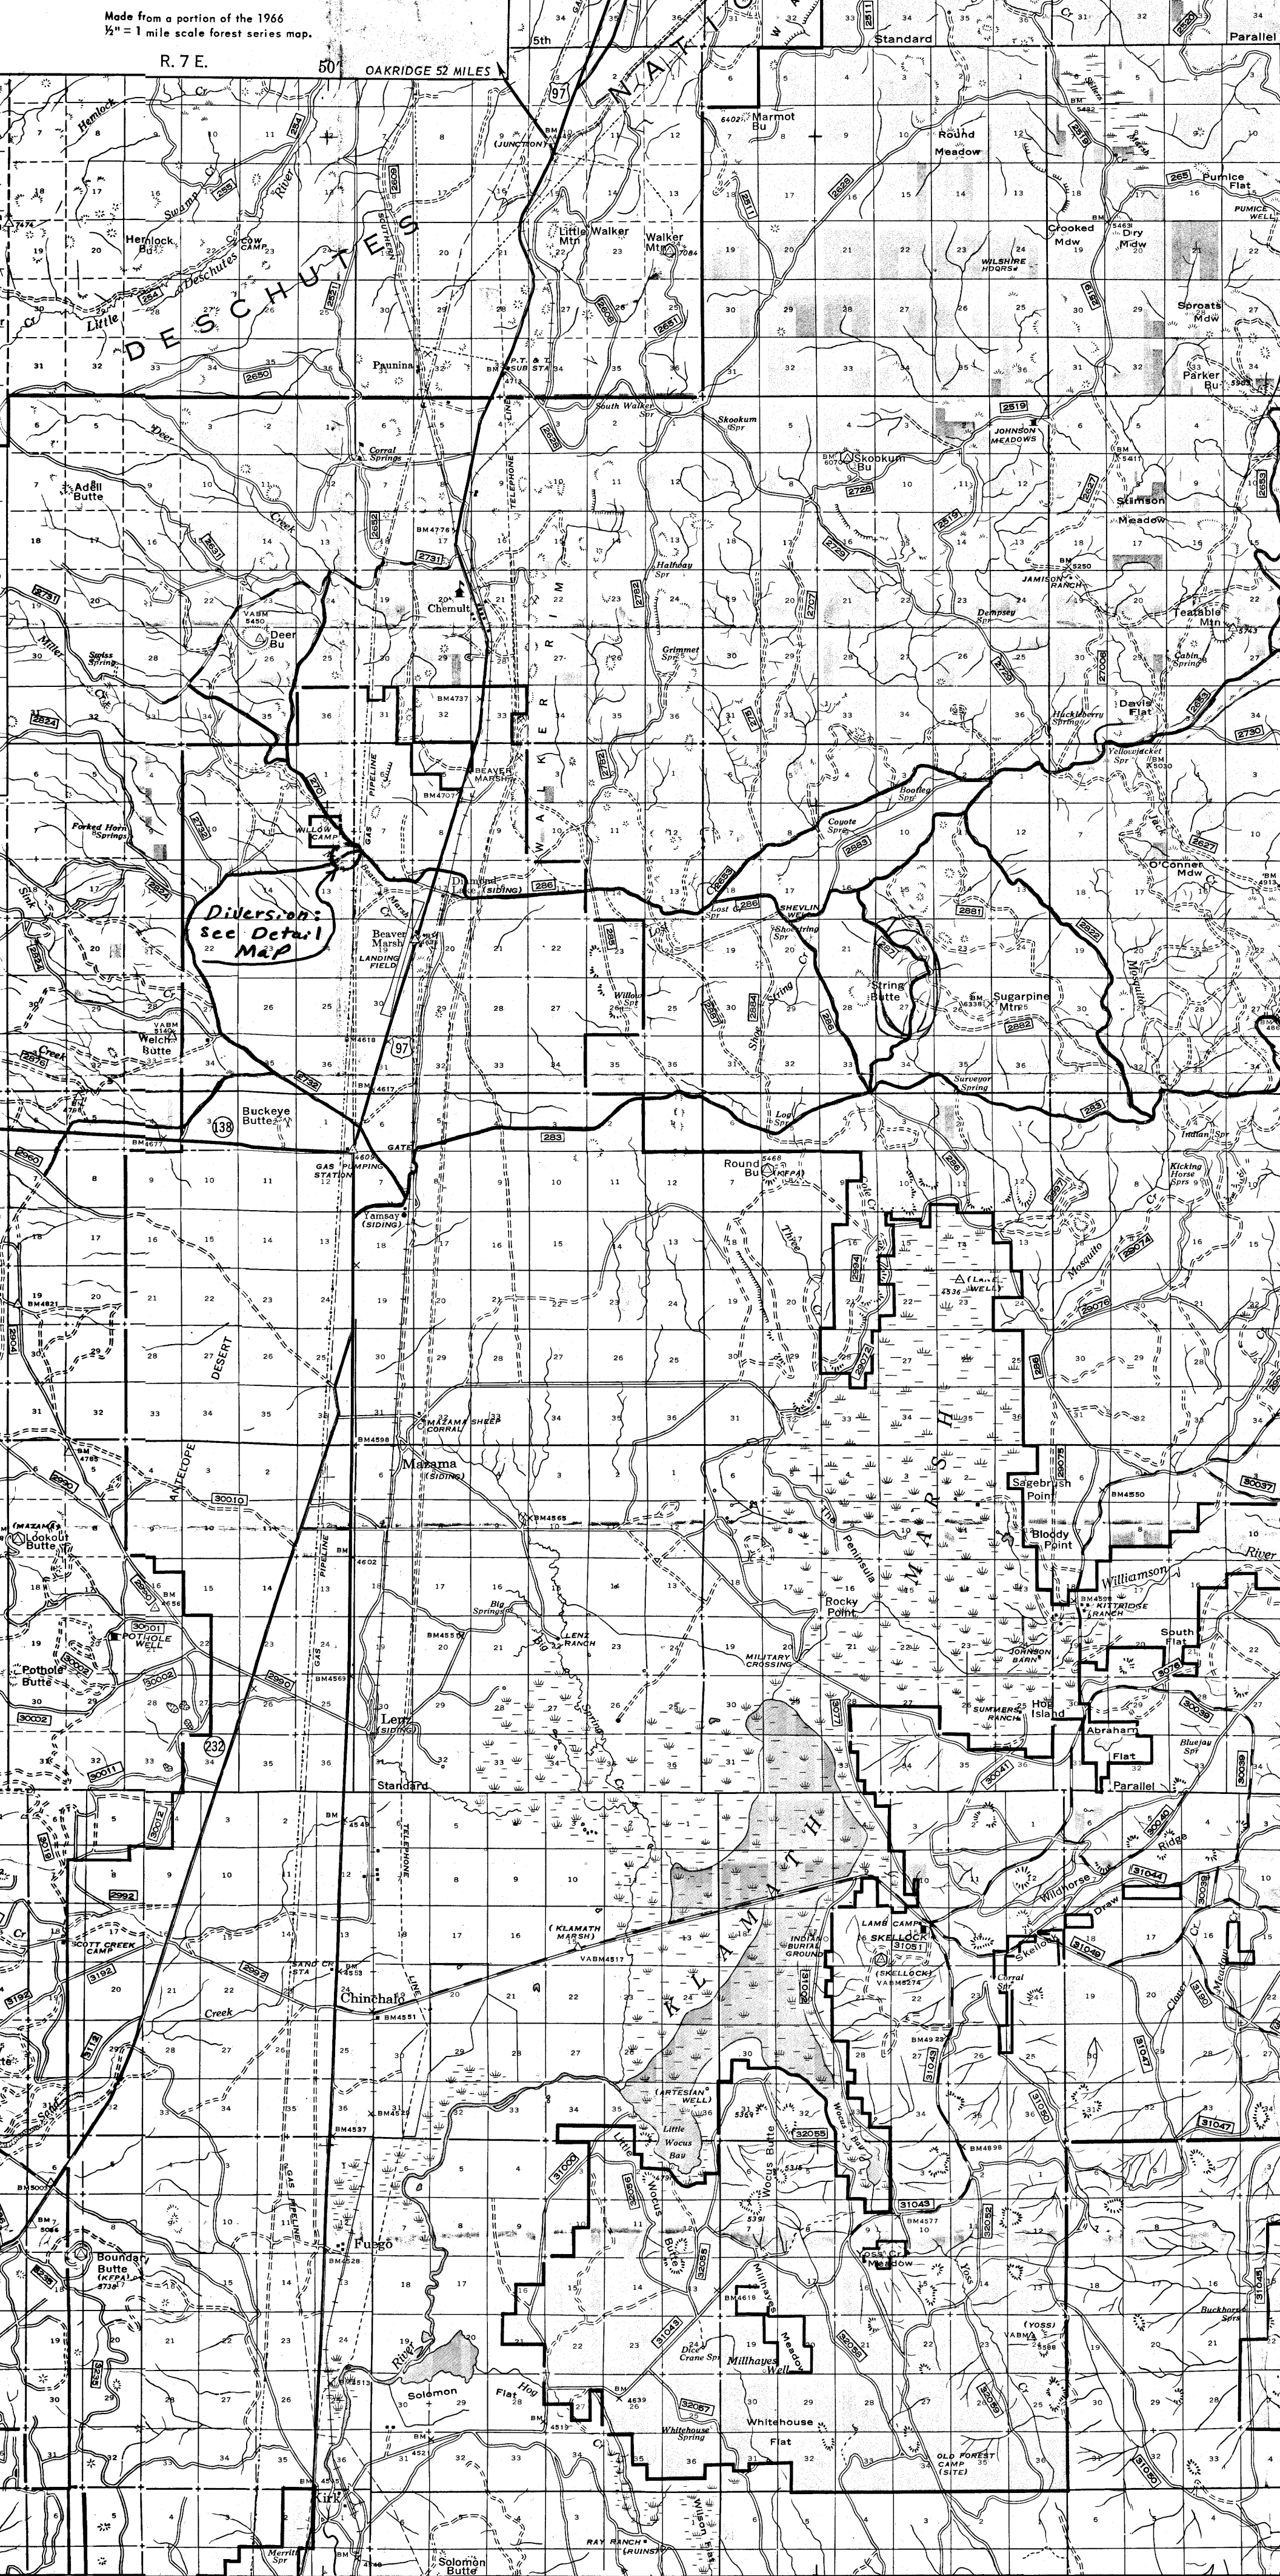

36 MILES R. 7 E. KLAMATH FALLS 50' 40 MILES R. 8 E. 40' R. 9 E. R. 10 E.

DEPARTMENT OF AGRICULTURE
 FOREST SERVICE



Made from a portion of the 1966
 1/2" = 1 mile scale forest series map.

