


Martin Landa

40 S. 23 E.

40 S. 24 E.

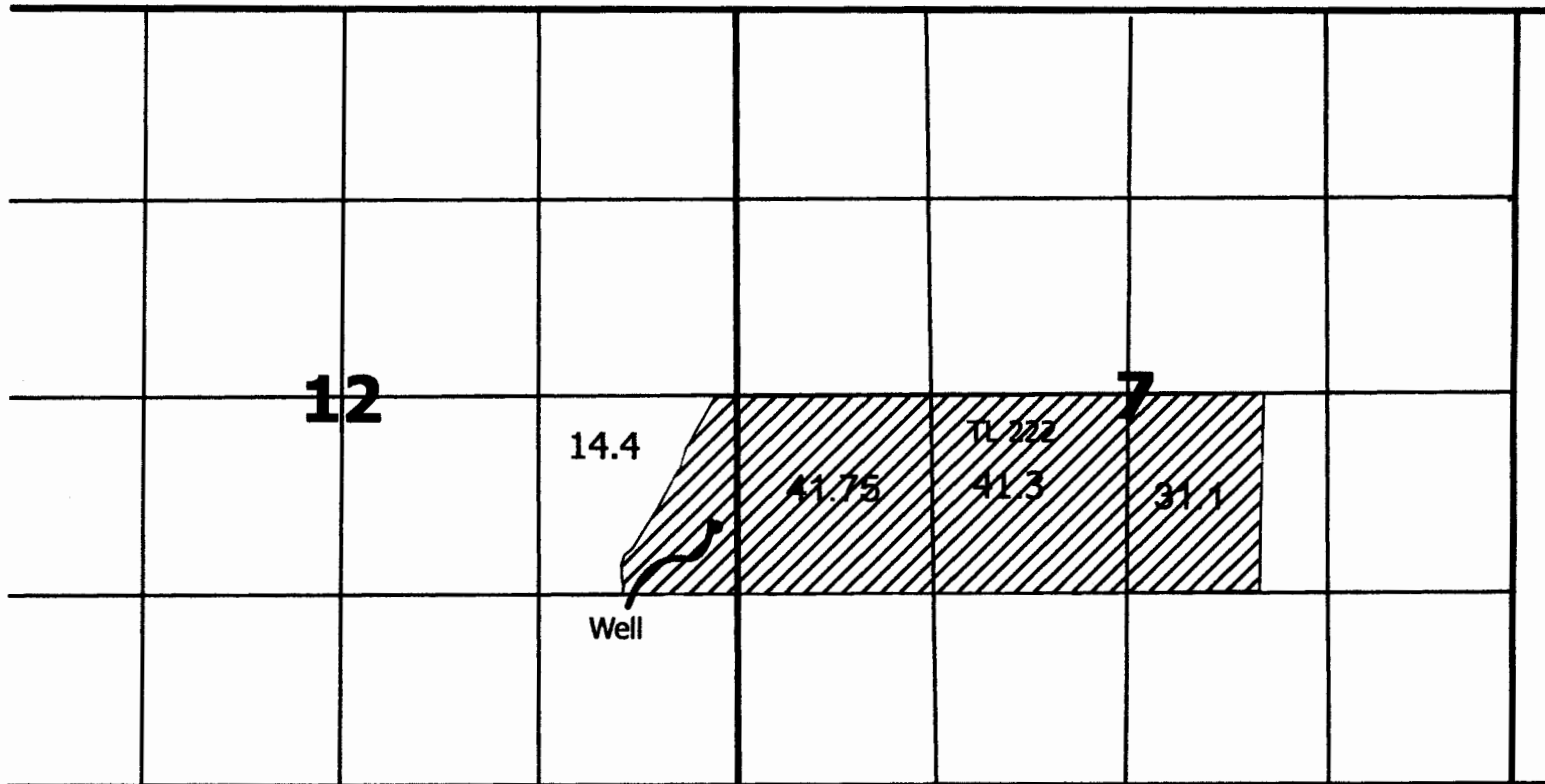

Well 1 is located 1760 ft. north and 156 ft. west of the SW corner of section 7 T. 40 S. 24 E. WM, TL 222 Lake County Oregon.

RECEIVED BY OWRD

JUL 16 2014

SALEM, OR

G-17692



1 inch = 1.320 feet