



T 18 S, R 5 W, Sec 9 TL 1500

Dam 470' N & 2575' W
from SE corner Sec 9

0.93 Ac., 6 Ac. Fr.

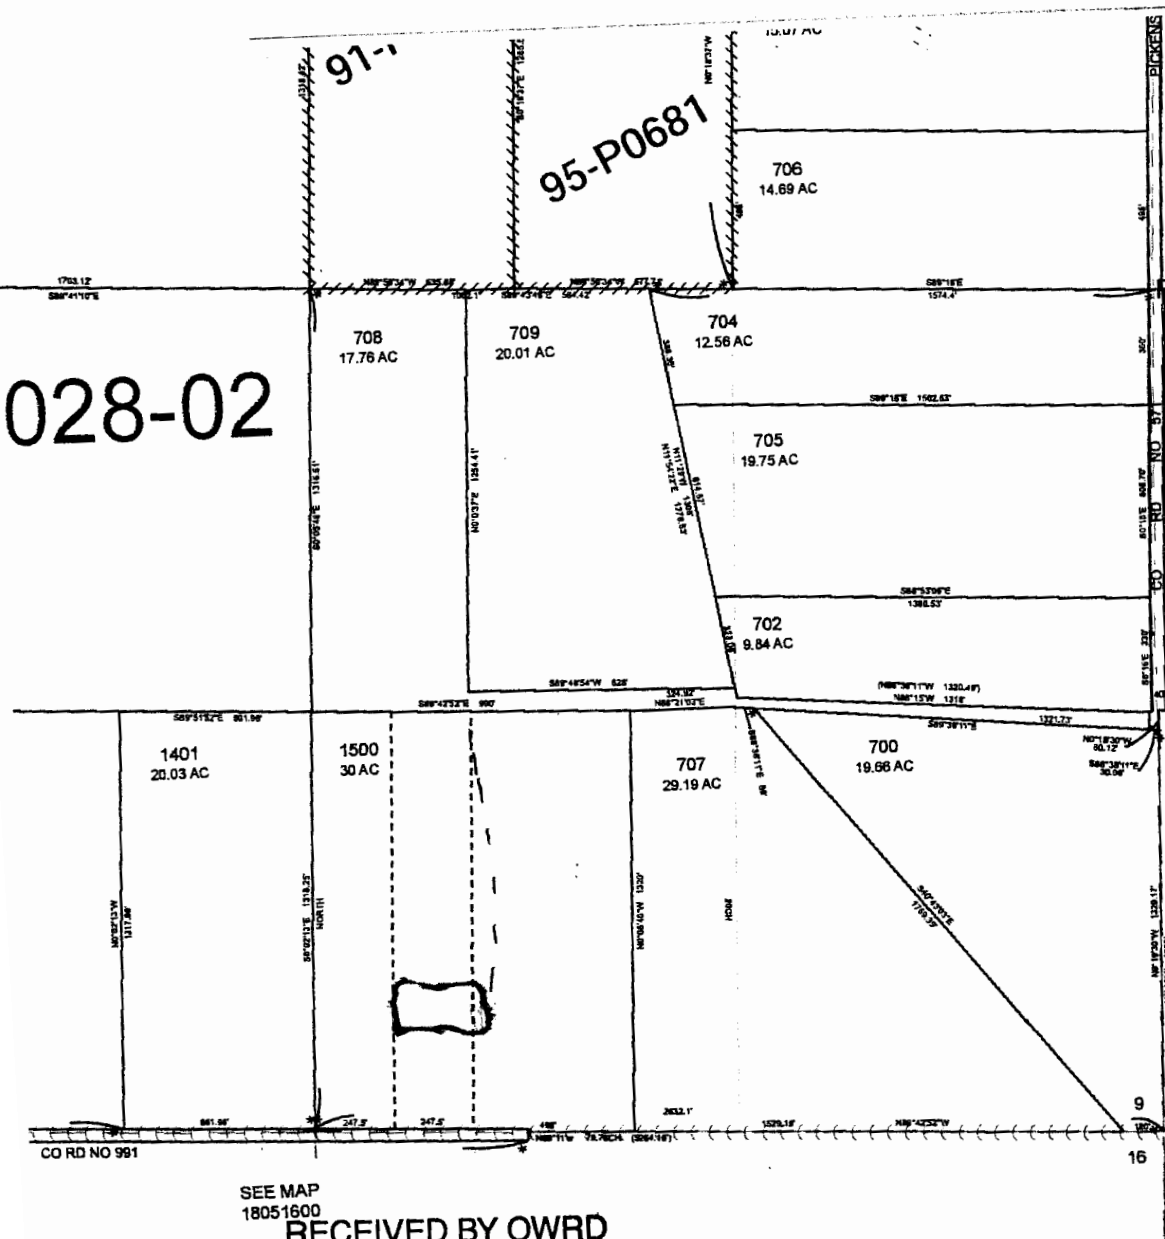

SEE MAP
18051000

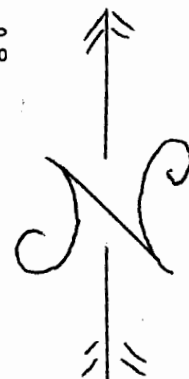

1" = 600'

REVISIONS:
8/21/2007 - LCAT140 - CONVERT MAP TO
11/18/2008 - LCAT187 - CANCEL TL 508 IN

18050