


USING NEIGHBOR'S MAP.

T1N, R10W, W.M.

THE PURPOSE OF THIS MAP IS TO IDENTIFY THE LOCATION OF THE WATER RIGHT. IT IS NOT INTENDED TO PROVIDE INFORMATION RELATIVE TO THE LOCATION OF PROPERTY OWNERSHIP BOUNDARY LINES.

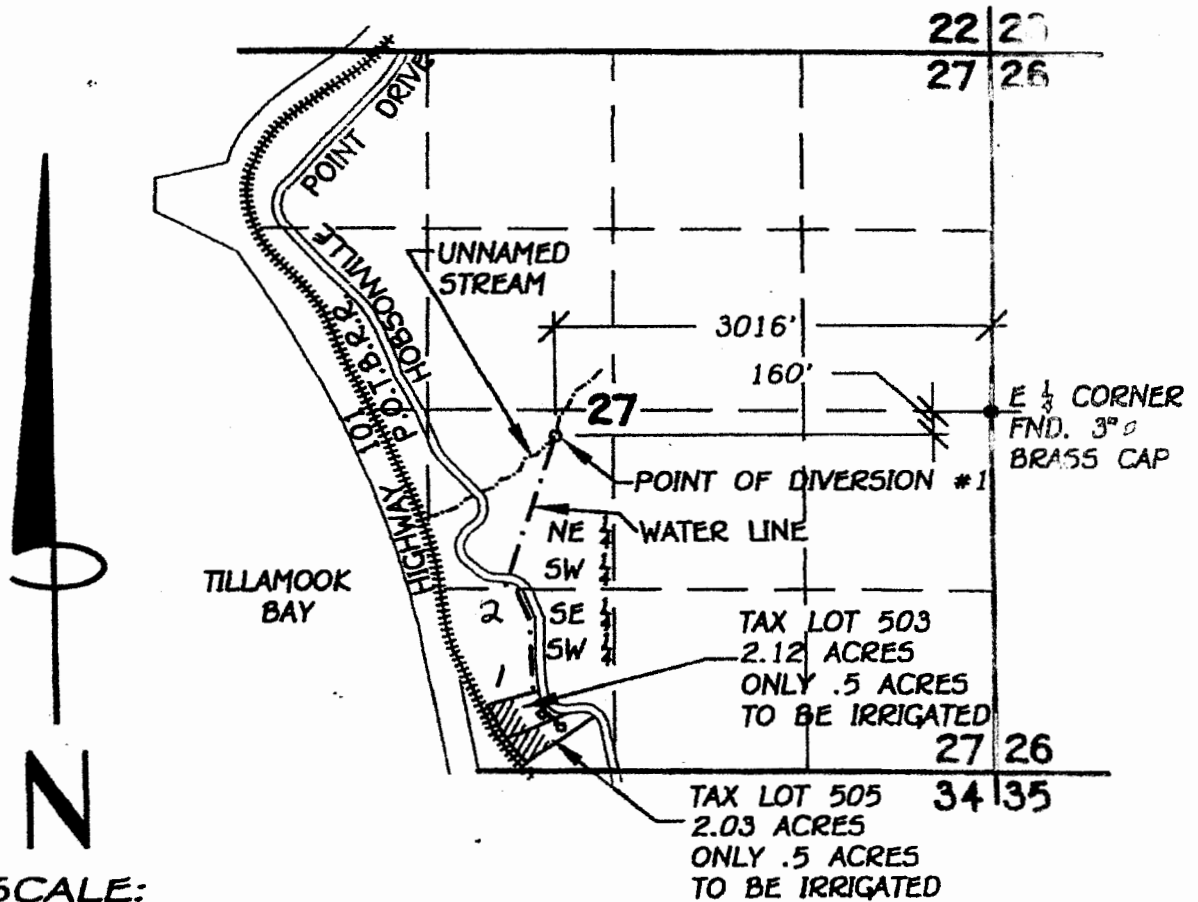

SCALE:
1" = 1320'

1. USE WATER AT NEW
2.2 ACRE PARCEL

2. FUTURE USE OF WATER AT PARCEL TO BE
BROKEN OFF.

TAX LOT 502

FINAL PROOF SURVEY
UNDER

APPLICATION 5-84629/PERMIT NO. 53736

IN THE NAME OF
SUSAN W. TOLLE

SEPTEMBER 9, 2005


RECEIVED BY OWRD.

JUL 22 2014

SALEM, OR

M050202-01-01.DWG

S-87997

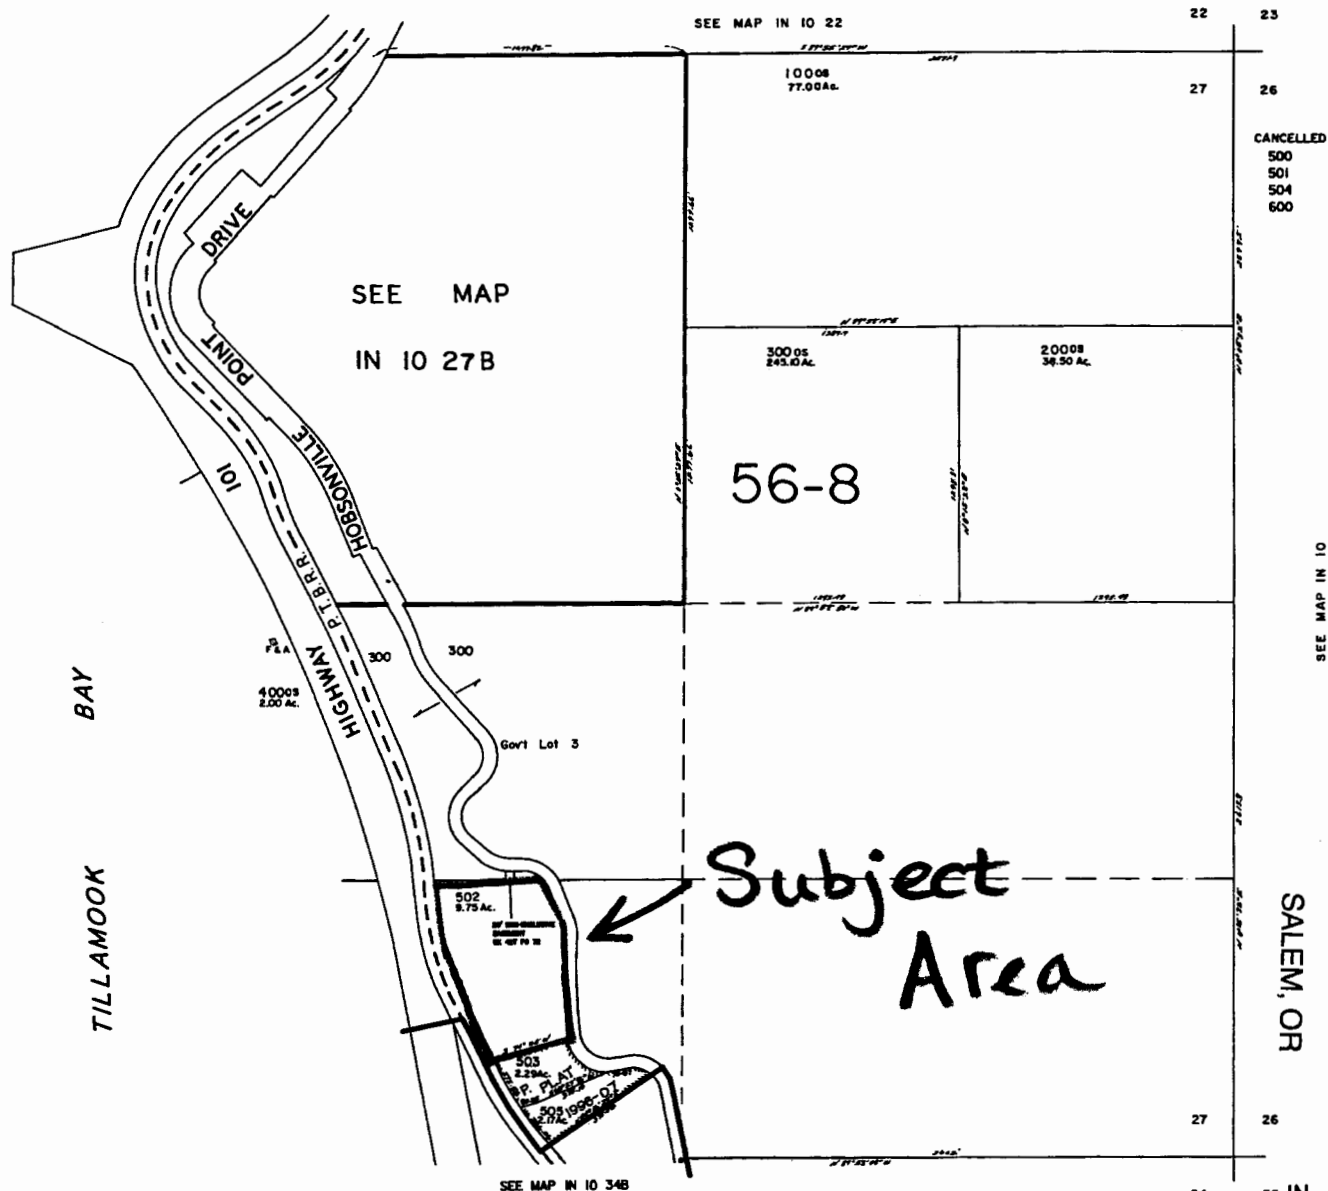IN 10 27
& INDEX

JUL 22 2014

RECEIVED BY OWRD

SALEM, OR

35 IN 10 27
& INDEX
REVISED 07/24/01, KA


44-38861-5

JUL 22 2014

SALEM, OR

EXHIBIT "B" 1 of 2

PROPOSED ACCESS AND WATERLINE EASEMENTS
 MARK TALSO — STATE OF OREGON FORESTRY
 In
 GOV'T LOT 3, Section 27, T. 1 N., R. 10 W., W.M.
 TILLAMOOK COUNTY, OREGON
 OCTOBER 25, 1990

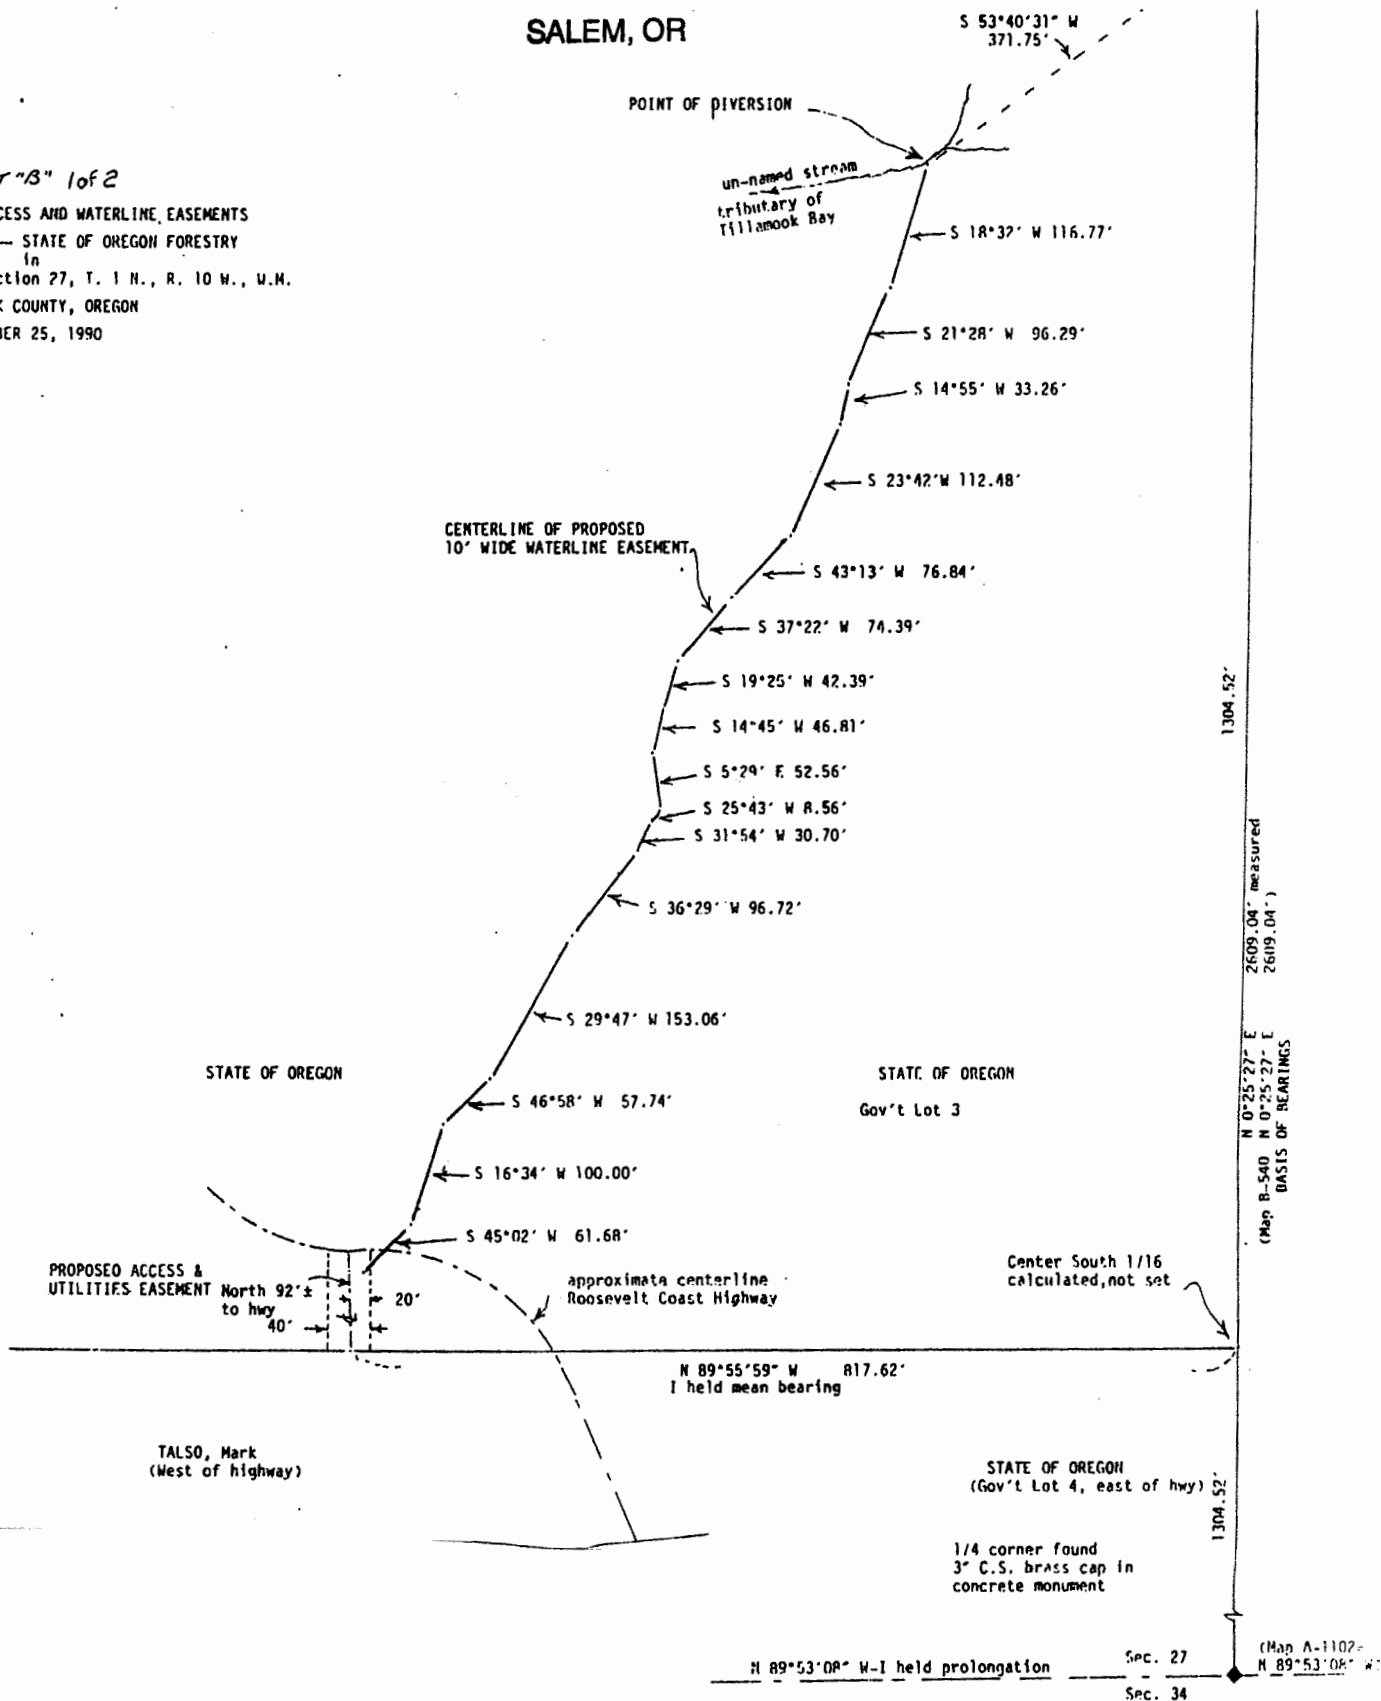


S-87987

RECEIVED BY OWRD

JUL 22 2014

SALEM, OR

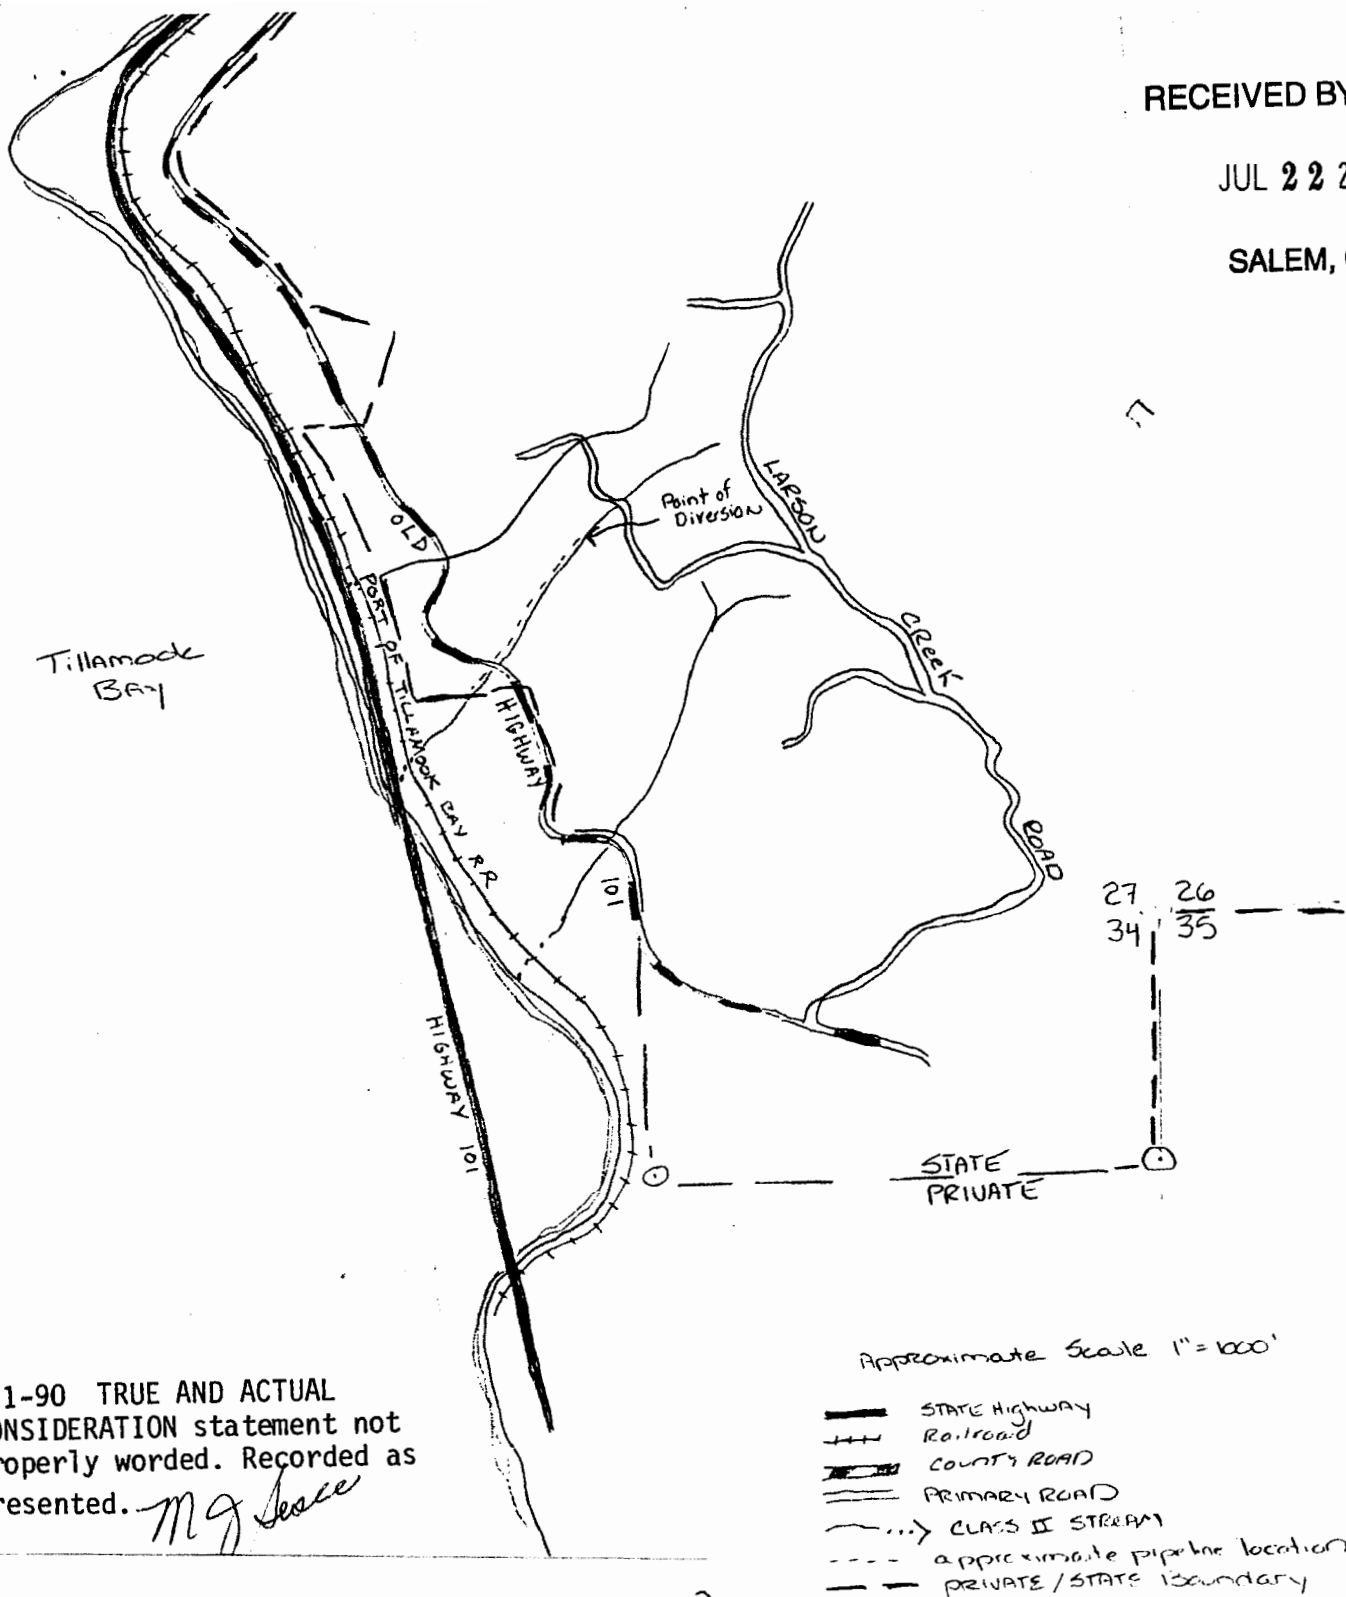

12-11-90 TRUE AND ACTUAL
CONSIDERATION statement not
properly worded. Recorded as
presented. *Mg Seace*

304545

I hereby certify that the within instrument
was received for record and recorded in
the County of Tillamook, State of Oregon.

Dec 11 9 57 AM '90

BOOK 332 PAGE 283

Witness my hand and seal affixed.
JOSEPHINE VELTRI, County Clerk

*Josephine Veltri, Deputy
Clerk 5:00 PM 11/30/90
Road 5.00 PM 11/30/90*

1-87797