


RECEIVED
JUL 30 1955
STATE ENGINEER
SALEM, OREGON

LLOYD AND ANNABELLE FORSTER
TANGENT, OREGON
SECTIONS 1 AND 12, T. 12S., R. 4W.

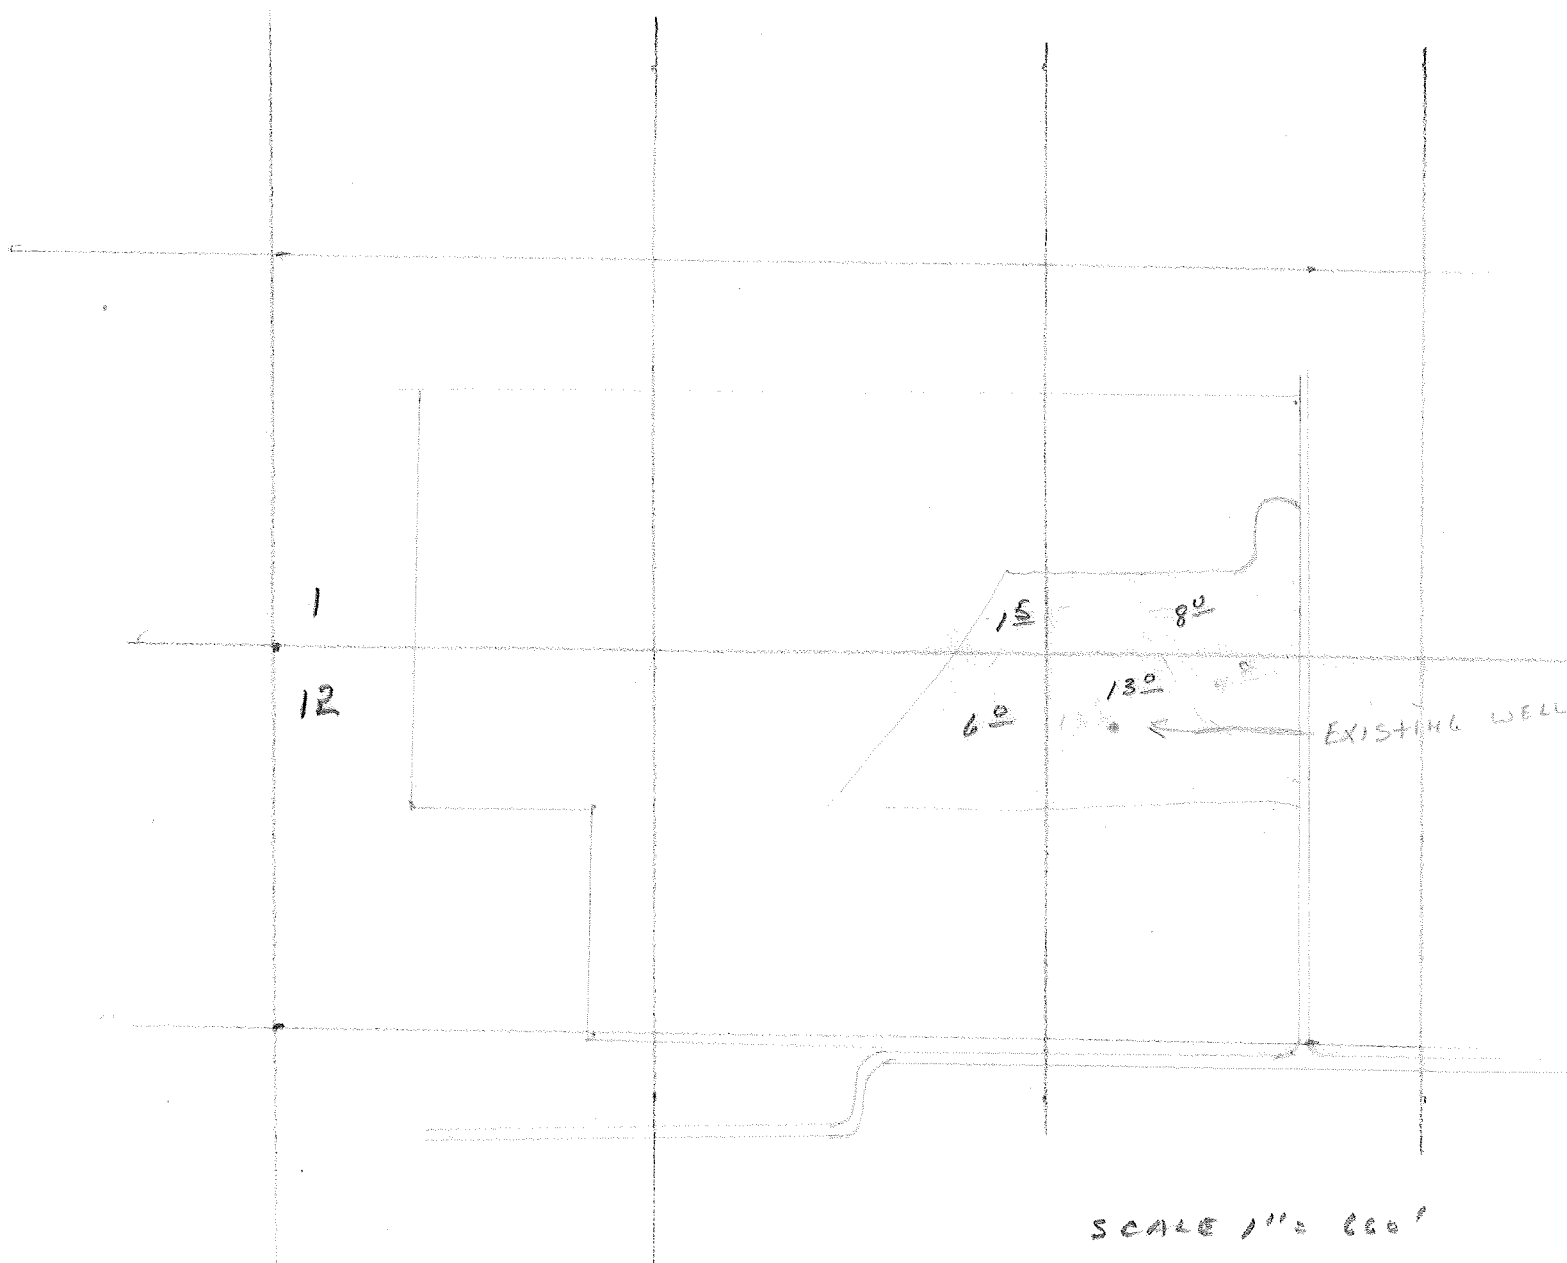

SCALE 1" = 660'

#D-122