

JUL 16 2014

SECTION PLAT

JUL 30 2014

SALEM, OR

Section 18

Township 21S


Range 35E

SALEM, OR

County of Harney

State of Oregon

Ref. Point

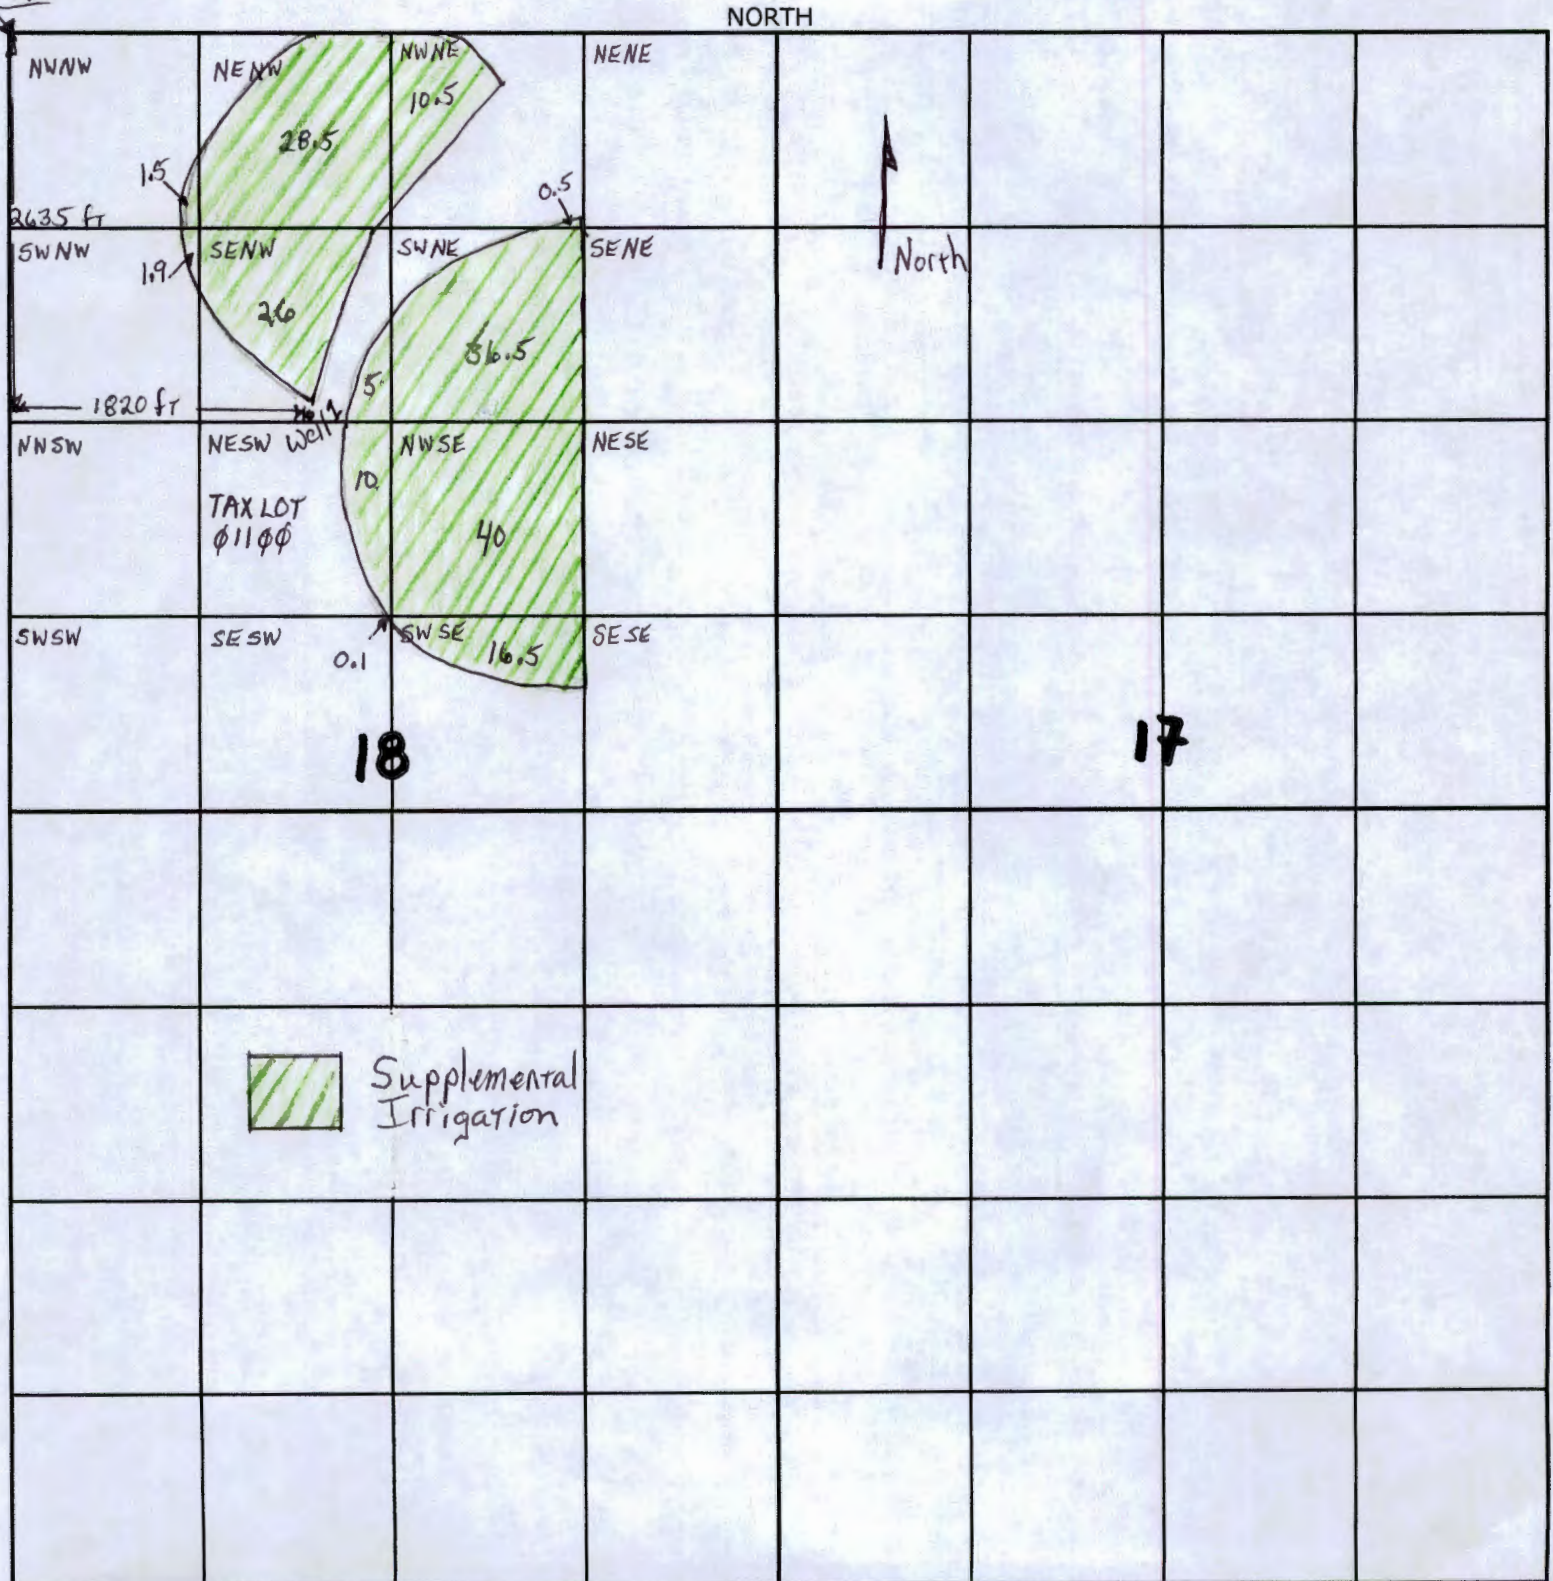

G-17889

4"=1 mile