




MAP ACCOMPANYING APPLICATION FOR PERMIT TO APPROPRIATE THE PUBLIC WATERS OF THE STATE OF OREGON IN UNION COUNTY
DATE: MARCH 15, 1966.
SCALE: 1" = 330 FEET
LANDOWNER: MR. FLOYD A. FEIK.

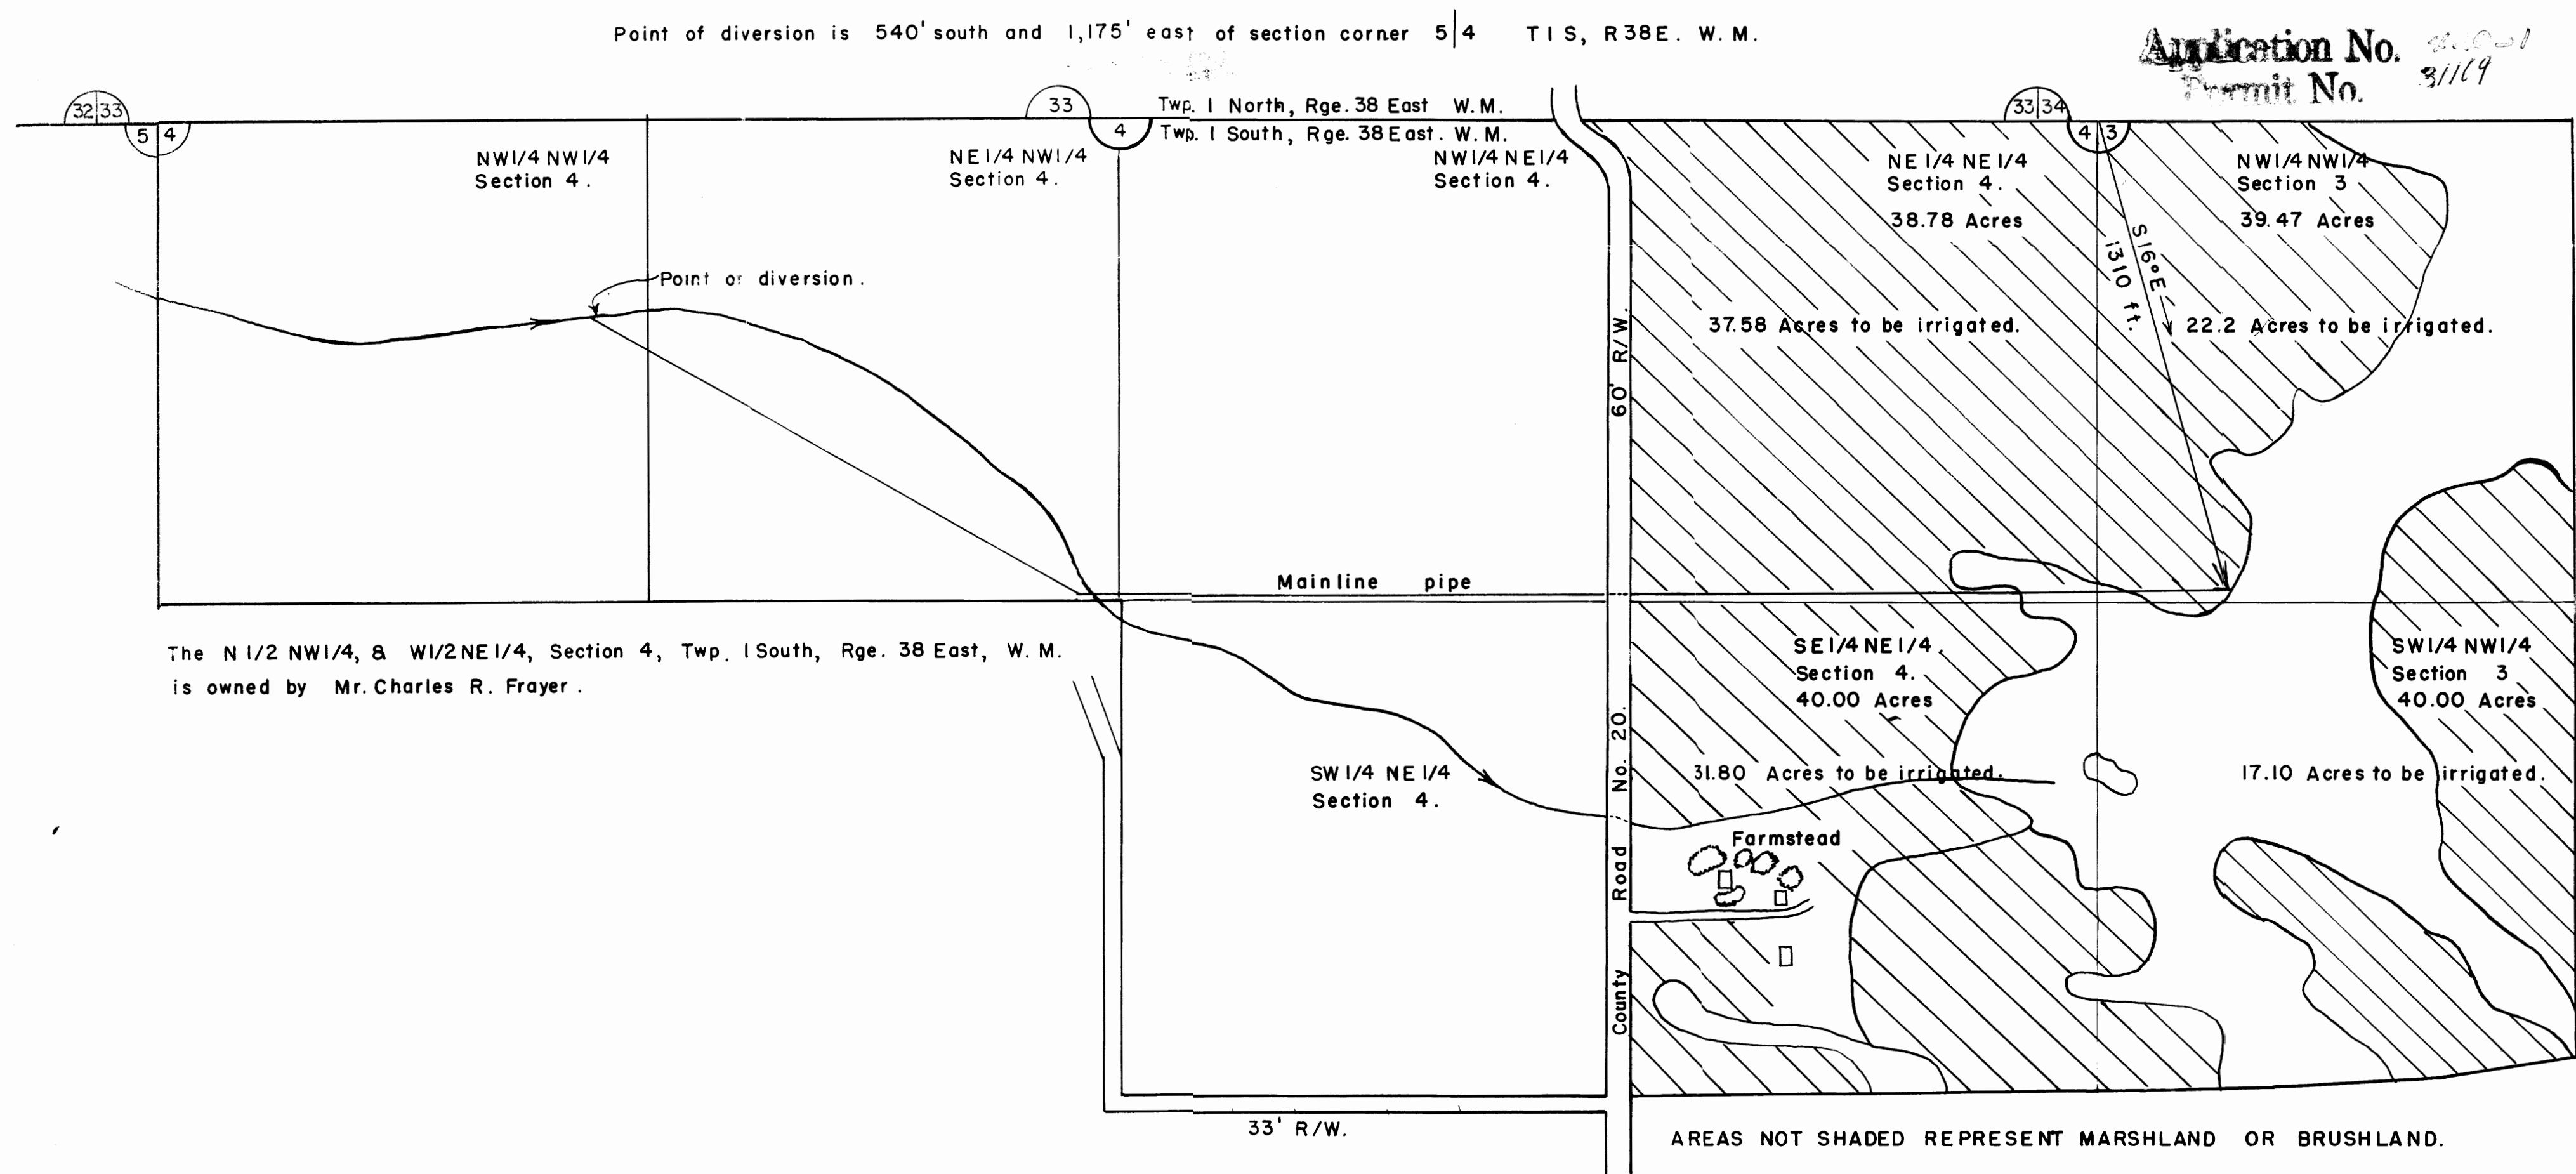

MAP ACCOMPANYING APPLICATION FOR PERMIT TO APPROPRIATE THE PUBLIC WATERS OF THE STATE OF OREGON IN UNION COUNTY
 DATE: MARCH 15, 1966.
 SCALE: 1" = 330 FEET
 LANDOWNER: MR. FLOYD A. FEIK.

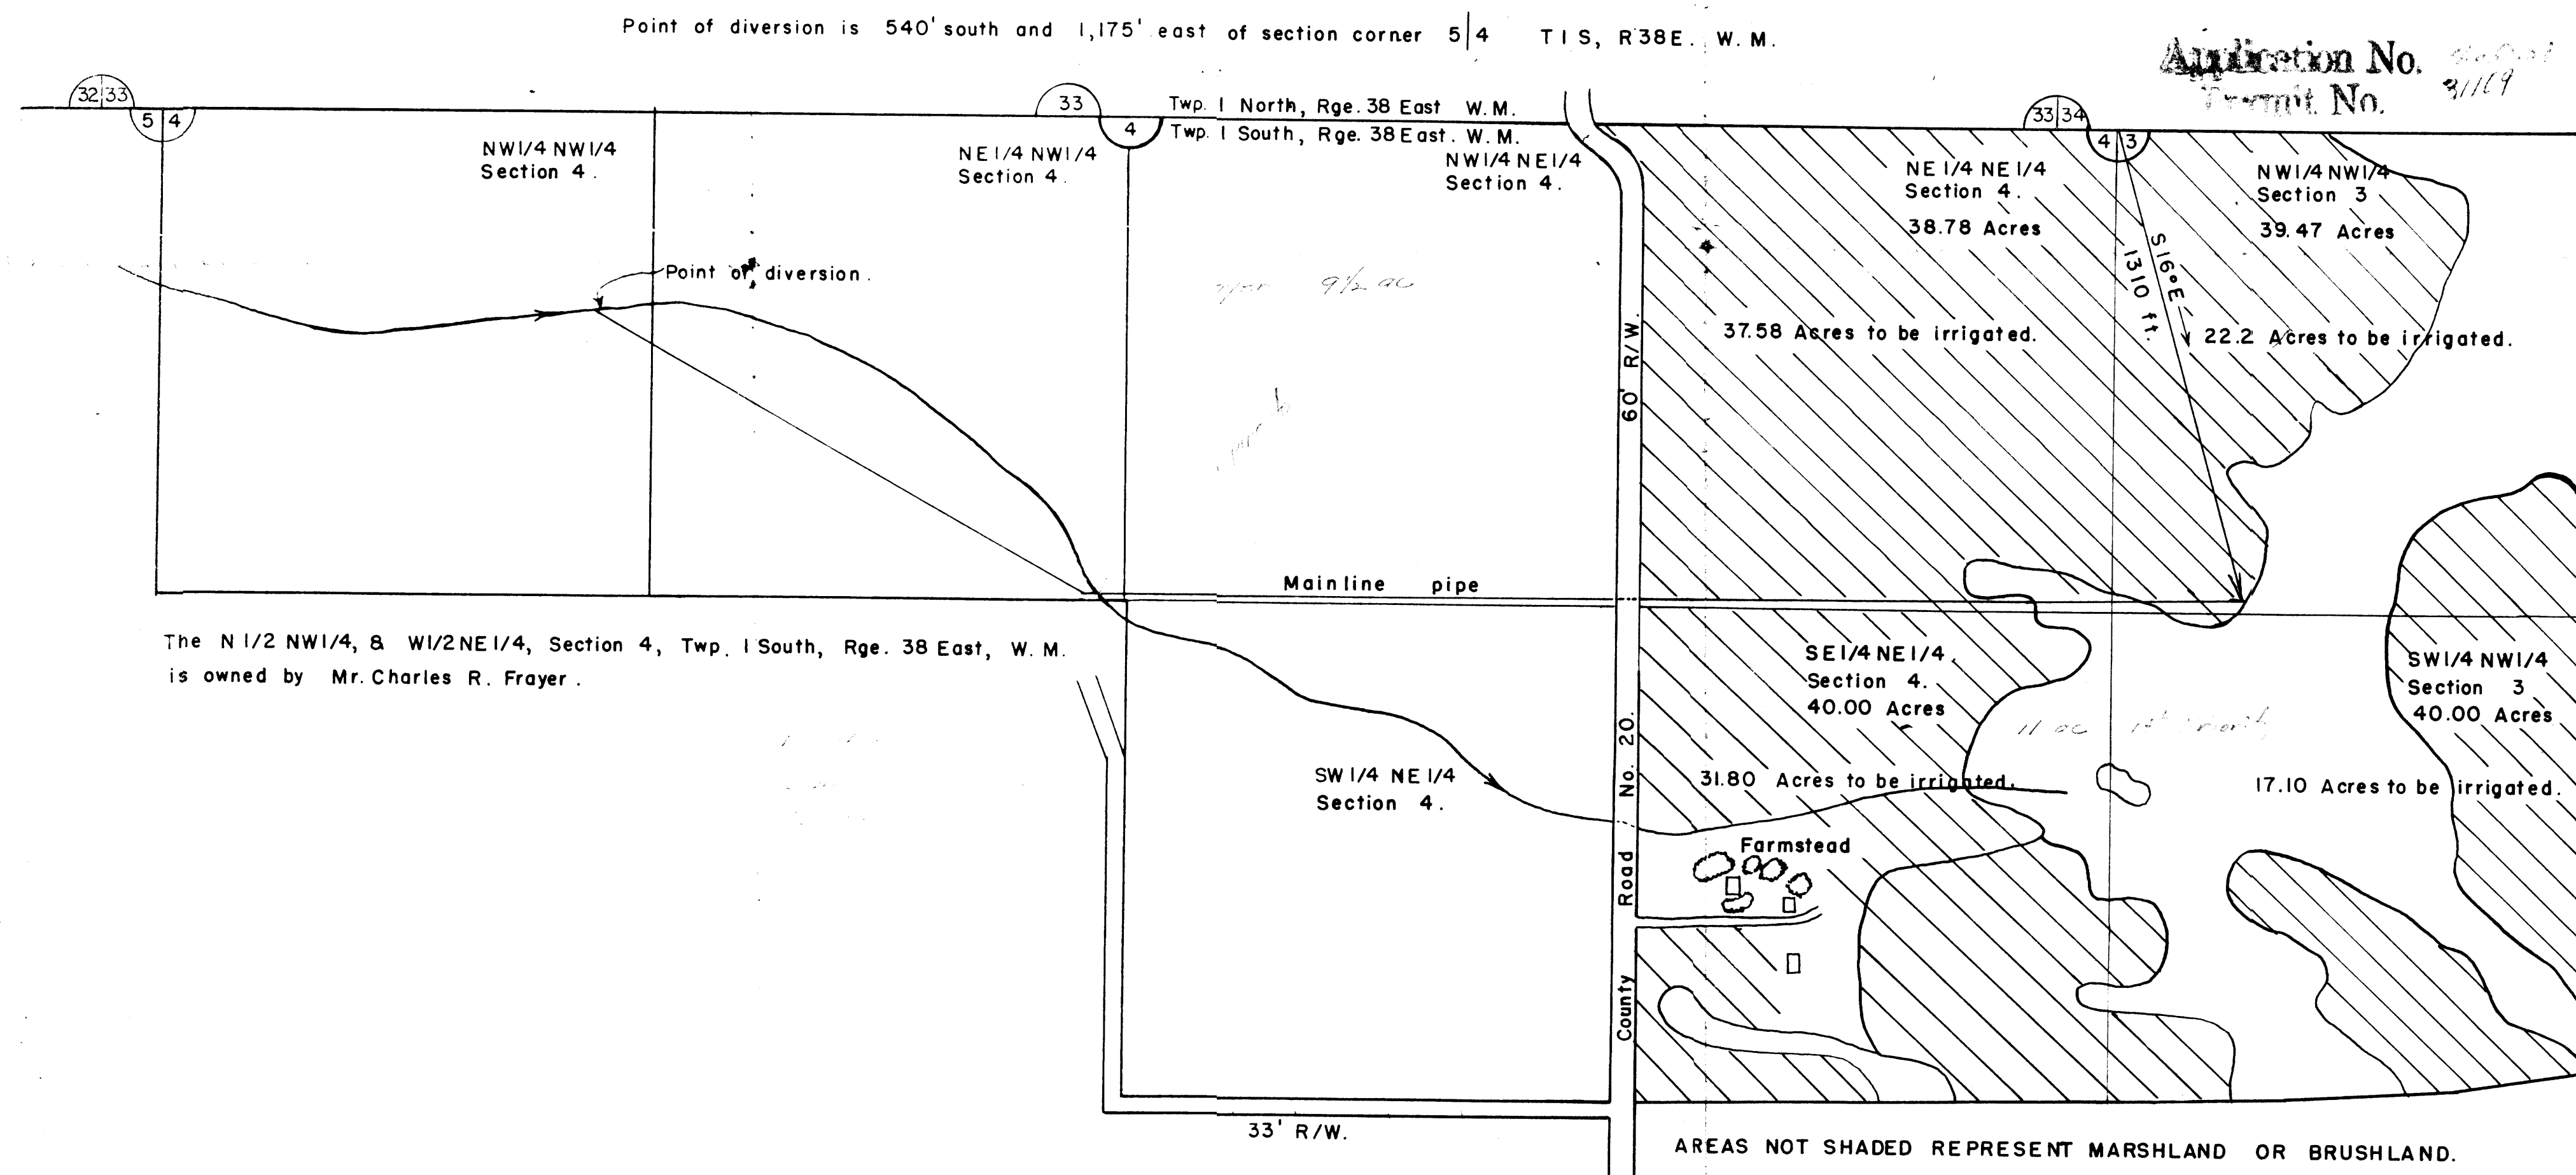


MAP ACCOMPANYING APPLICATION FOR PERMIT TO APPROPRIATE THE PUBLIC WATERS OF THE STATE OF OREGON IN UNION COUNTY
 DATE: MARCH 15, 1966.
 SCALE: 1" = 330 FEET
 LANDOWNER: MR. FLOYD A. FEIK.

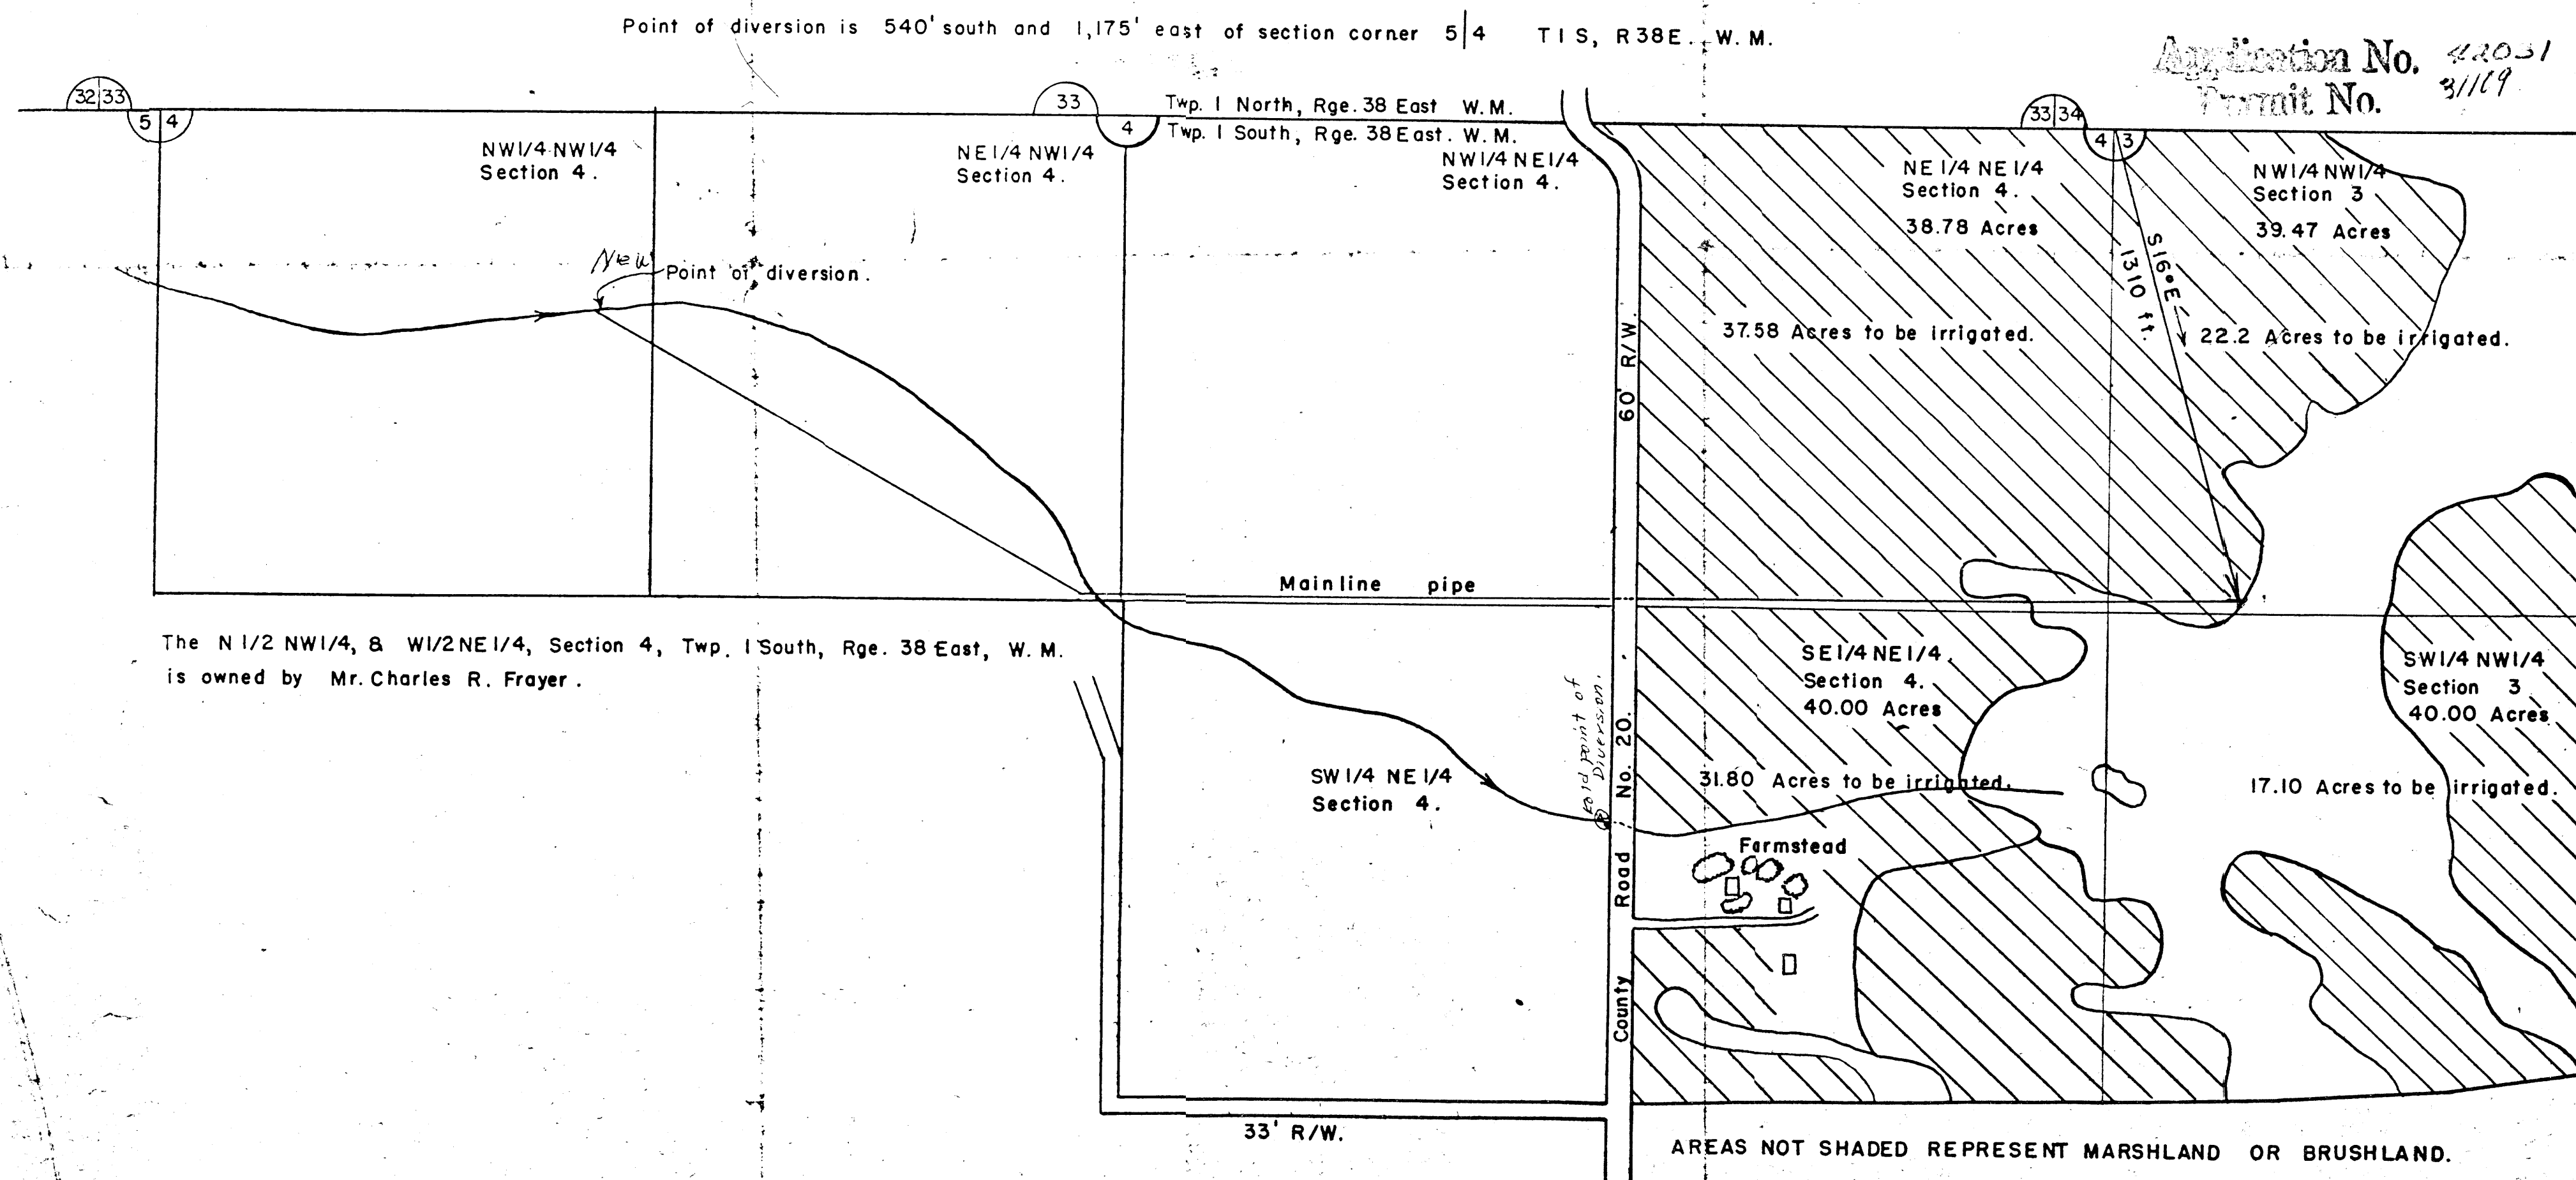

1875 ft. south
 3935 ft. west
 of sec. cor. 5/4 T1S, R38E.


MAP ACCOMPANYING APPLICATION FOR PERMIT TO APPROPRIATE THE PUBLIC WATERS OF THE STATE OF OREGON IN UNION COUNTY
 DATE: MARCH 15, 1966.
 SCALE: 1" = 330 FEET
 LANDOWNER: MR. FLOYD A. FEIK.

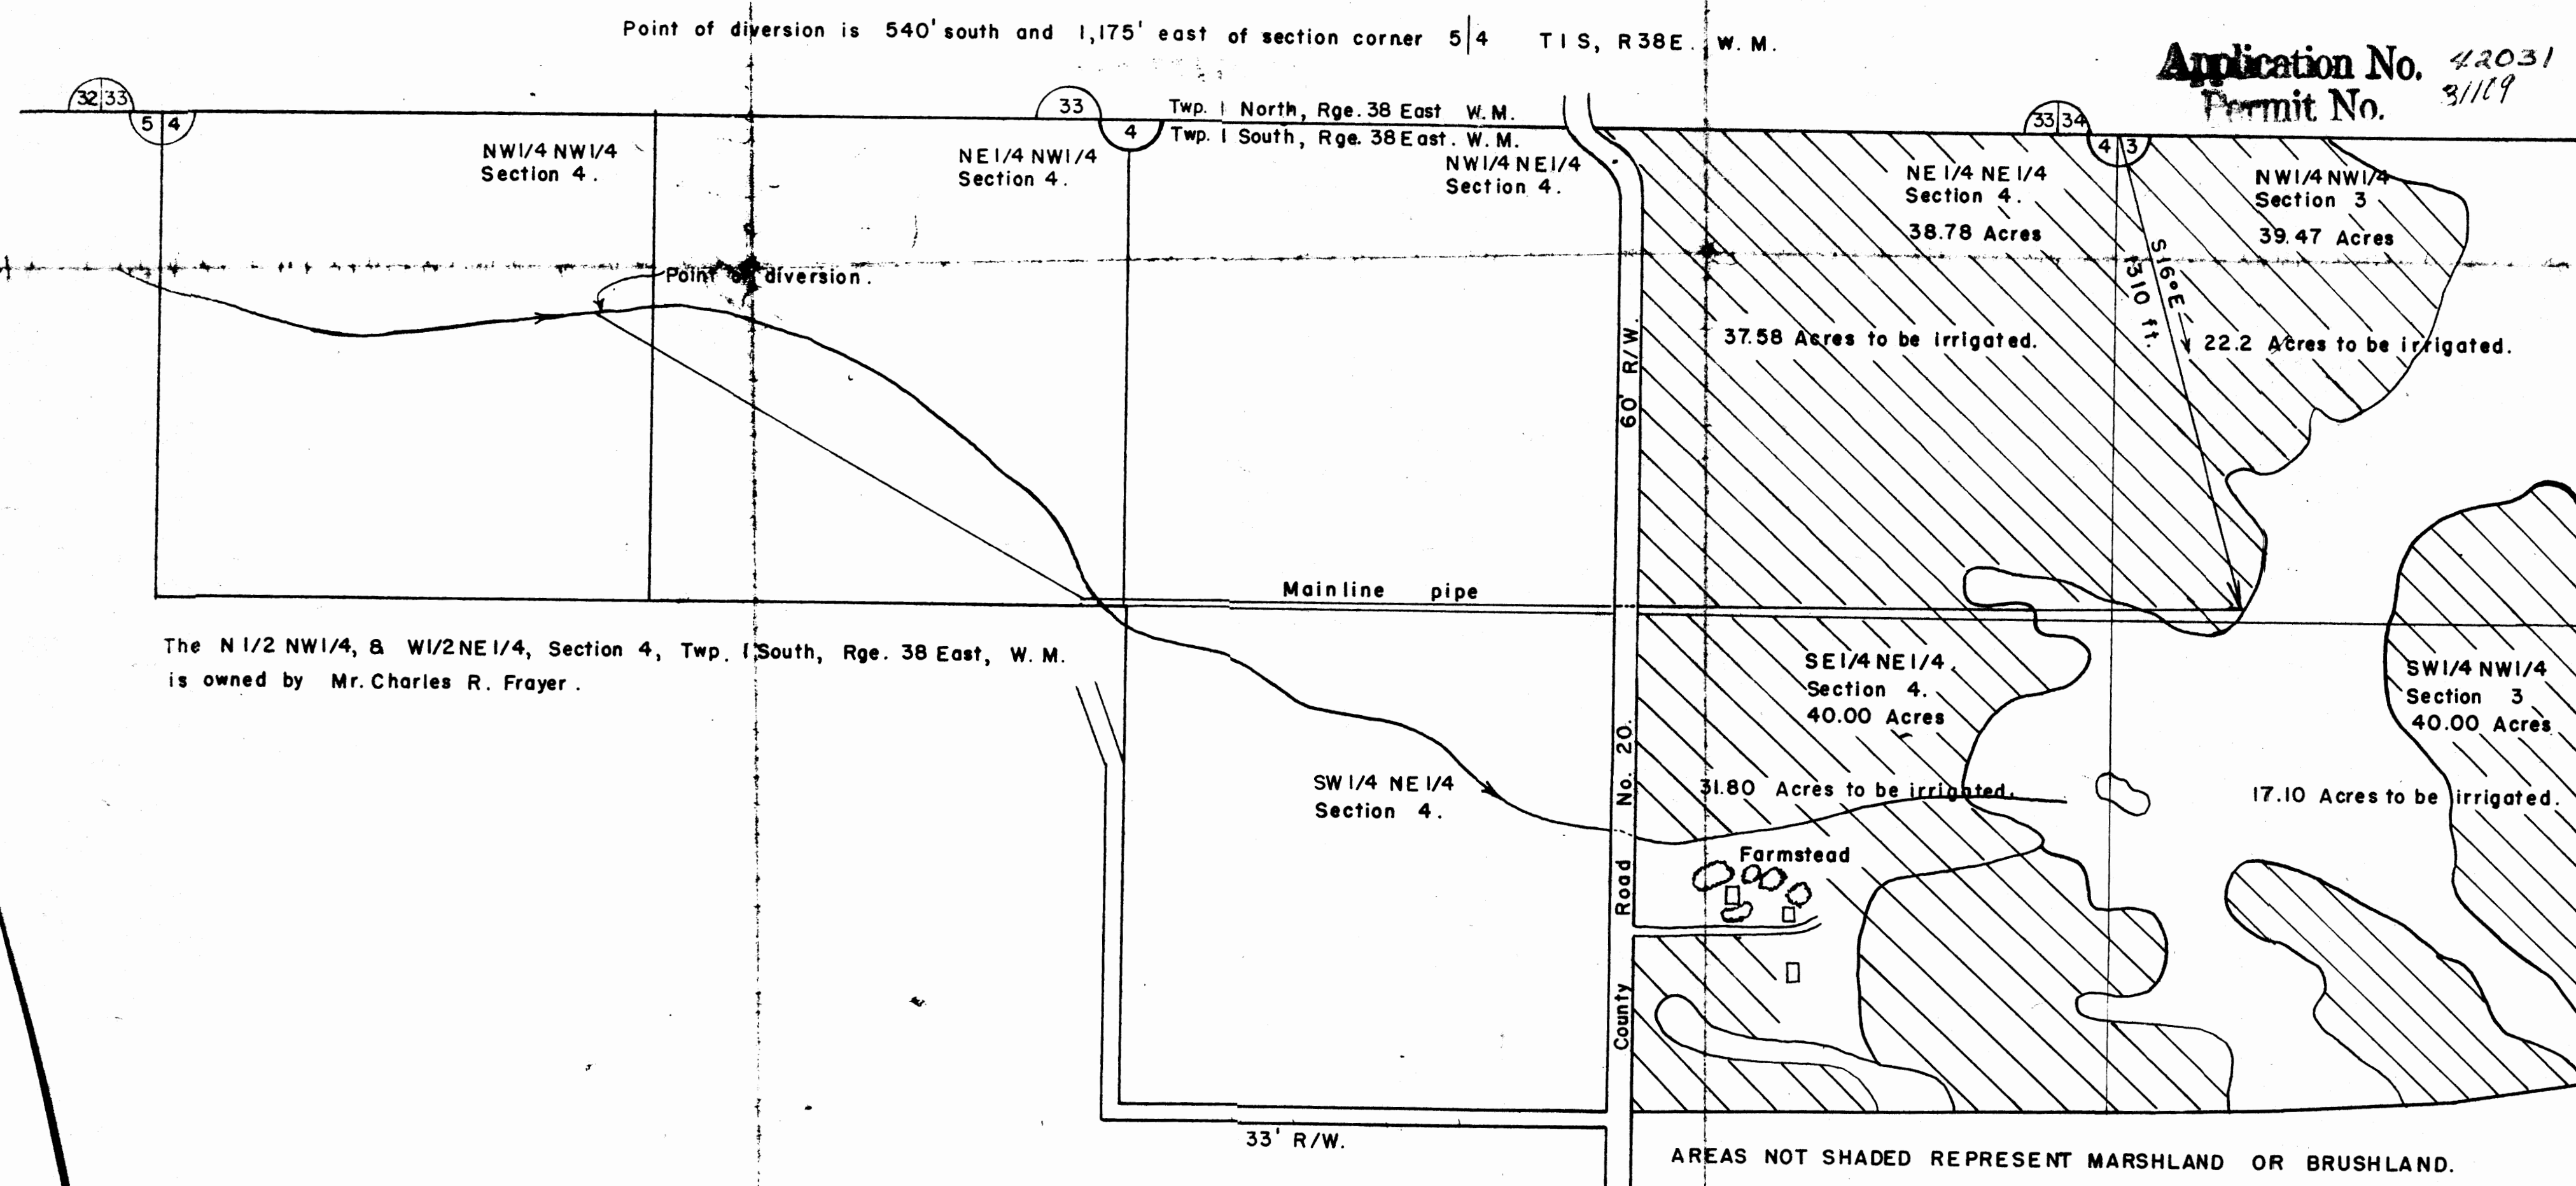

MAP ACCOMPANYING APPLICATION FOR PERMIT TO APPROPRIATE THE PUBLIC WATERS OF THE STATE OF OREGON IN UNION COUNTY
 DATE: MARCH 15, 1966.
 SCALE: 1" = 330 FEET
 LANDOWNER: MR. FLOYD A. FEIK.

