


RECEIVED BY OWRD

AUG 29 2014

SALEM, OR

Jack Flynn Cattle Company

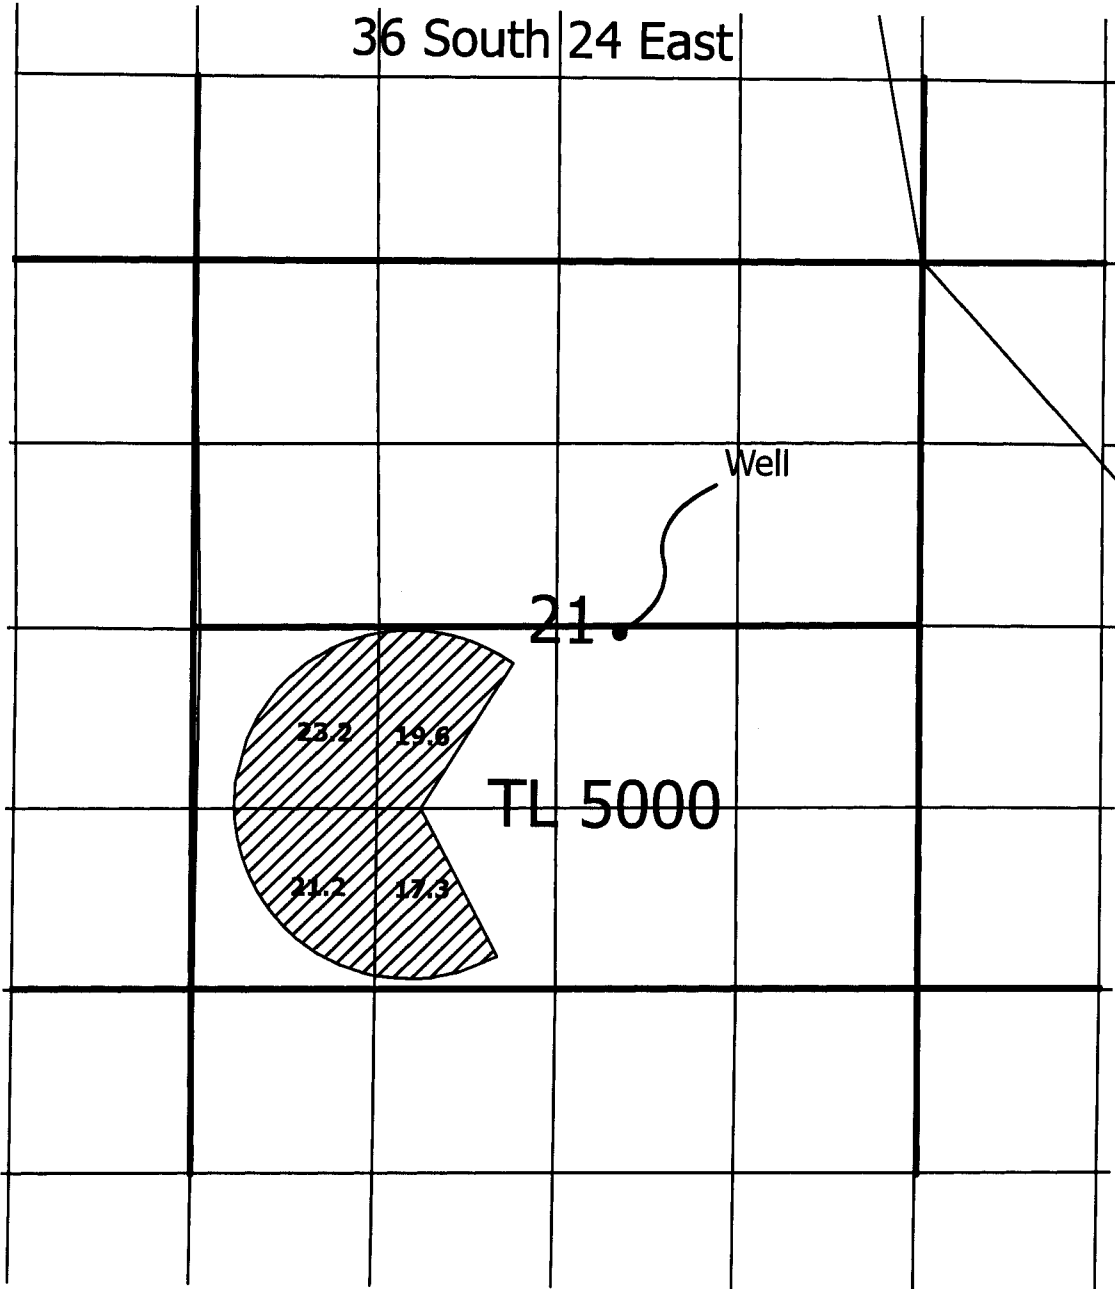

Well is located 2639 feet north and 3032 feet east of the SW quarter corner of Section 21. 36S 24E



G-17914

1 inch = 1,320 feet


Jack Flynn

RECEIVED BY OWRD

AUG 29 2014

36 South 24 East

SALEM, OR

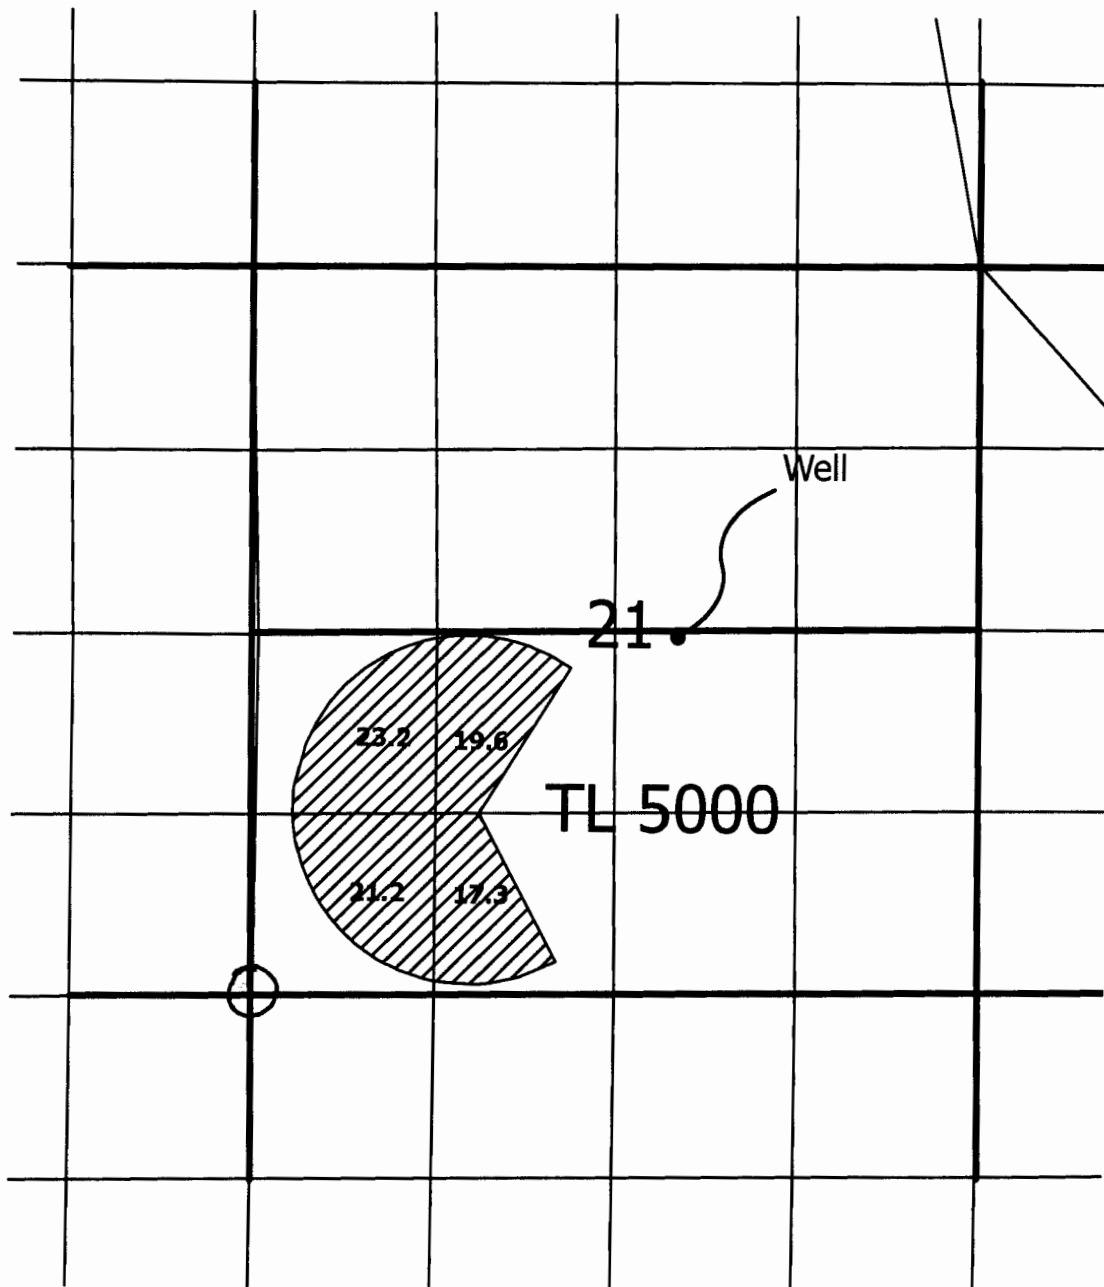

Well is located 2639 feet north and 3032 feet east of the SW quarter corner of Section 21. 36S 24E

G-17914



1 inch = 1,320 feet