




RECEIVED BY OWRD

SEP 04 2014

SALEM, OR

wells to be used

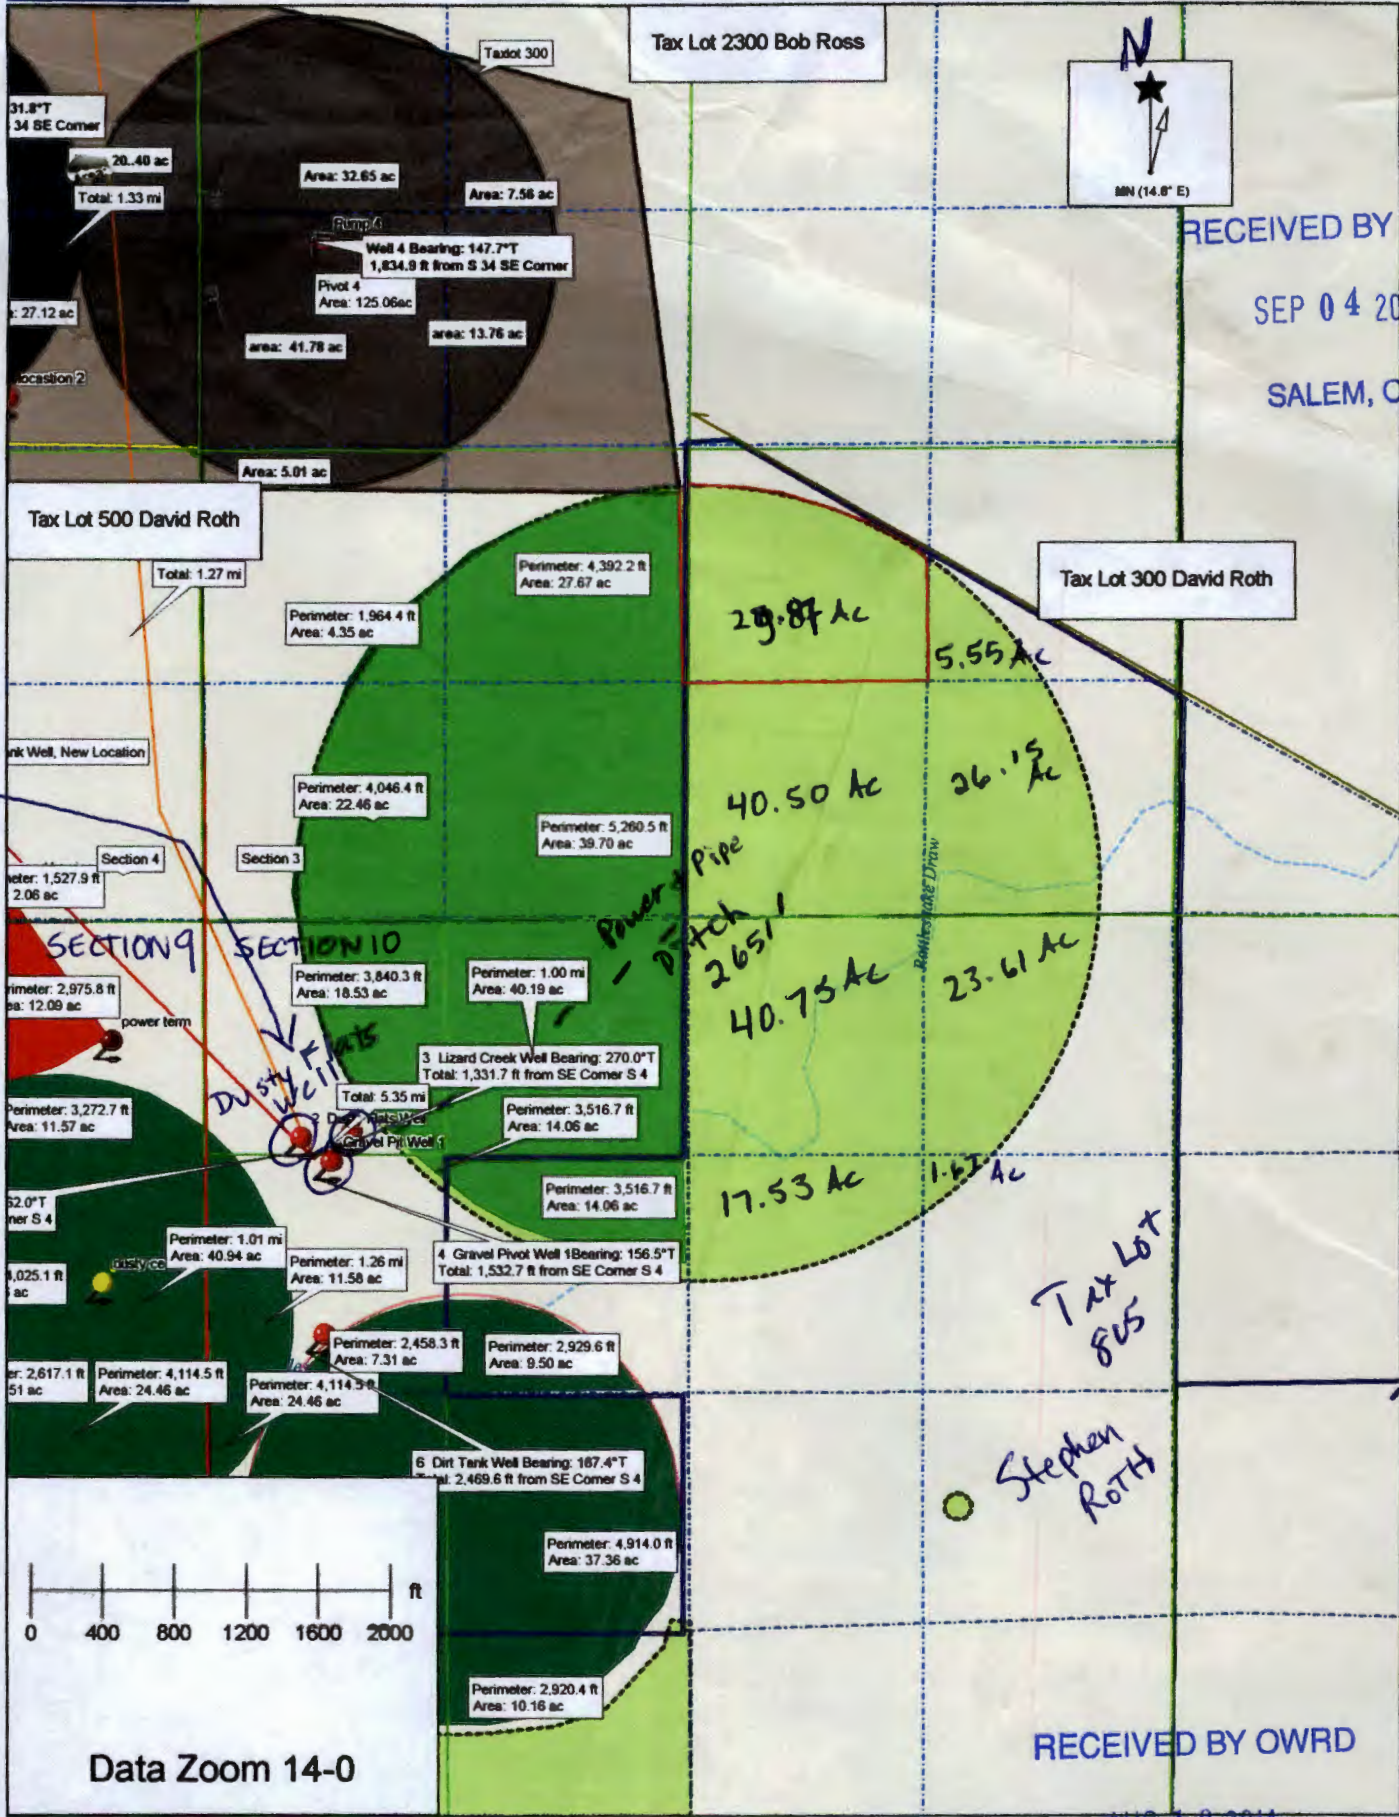

Tax Lot 805

Stephen ROTH

RECEIVED BY OWRD

AUG 18 2014

SALEM, OR

Data use subject to license.

© DeLorme, Topo North America™ 9.

www.delorme.com

G-17919