


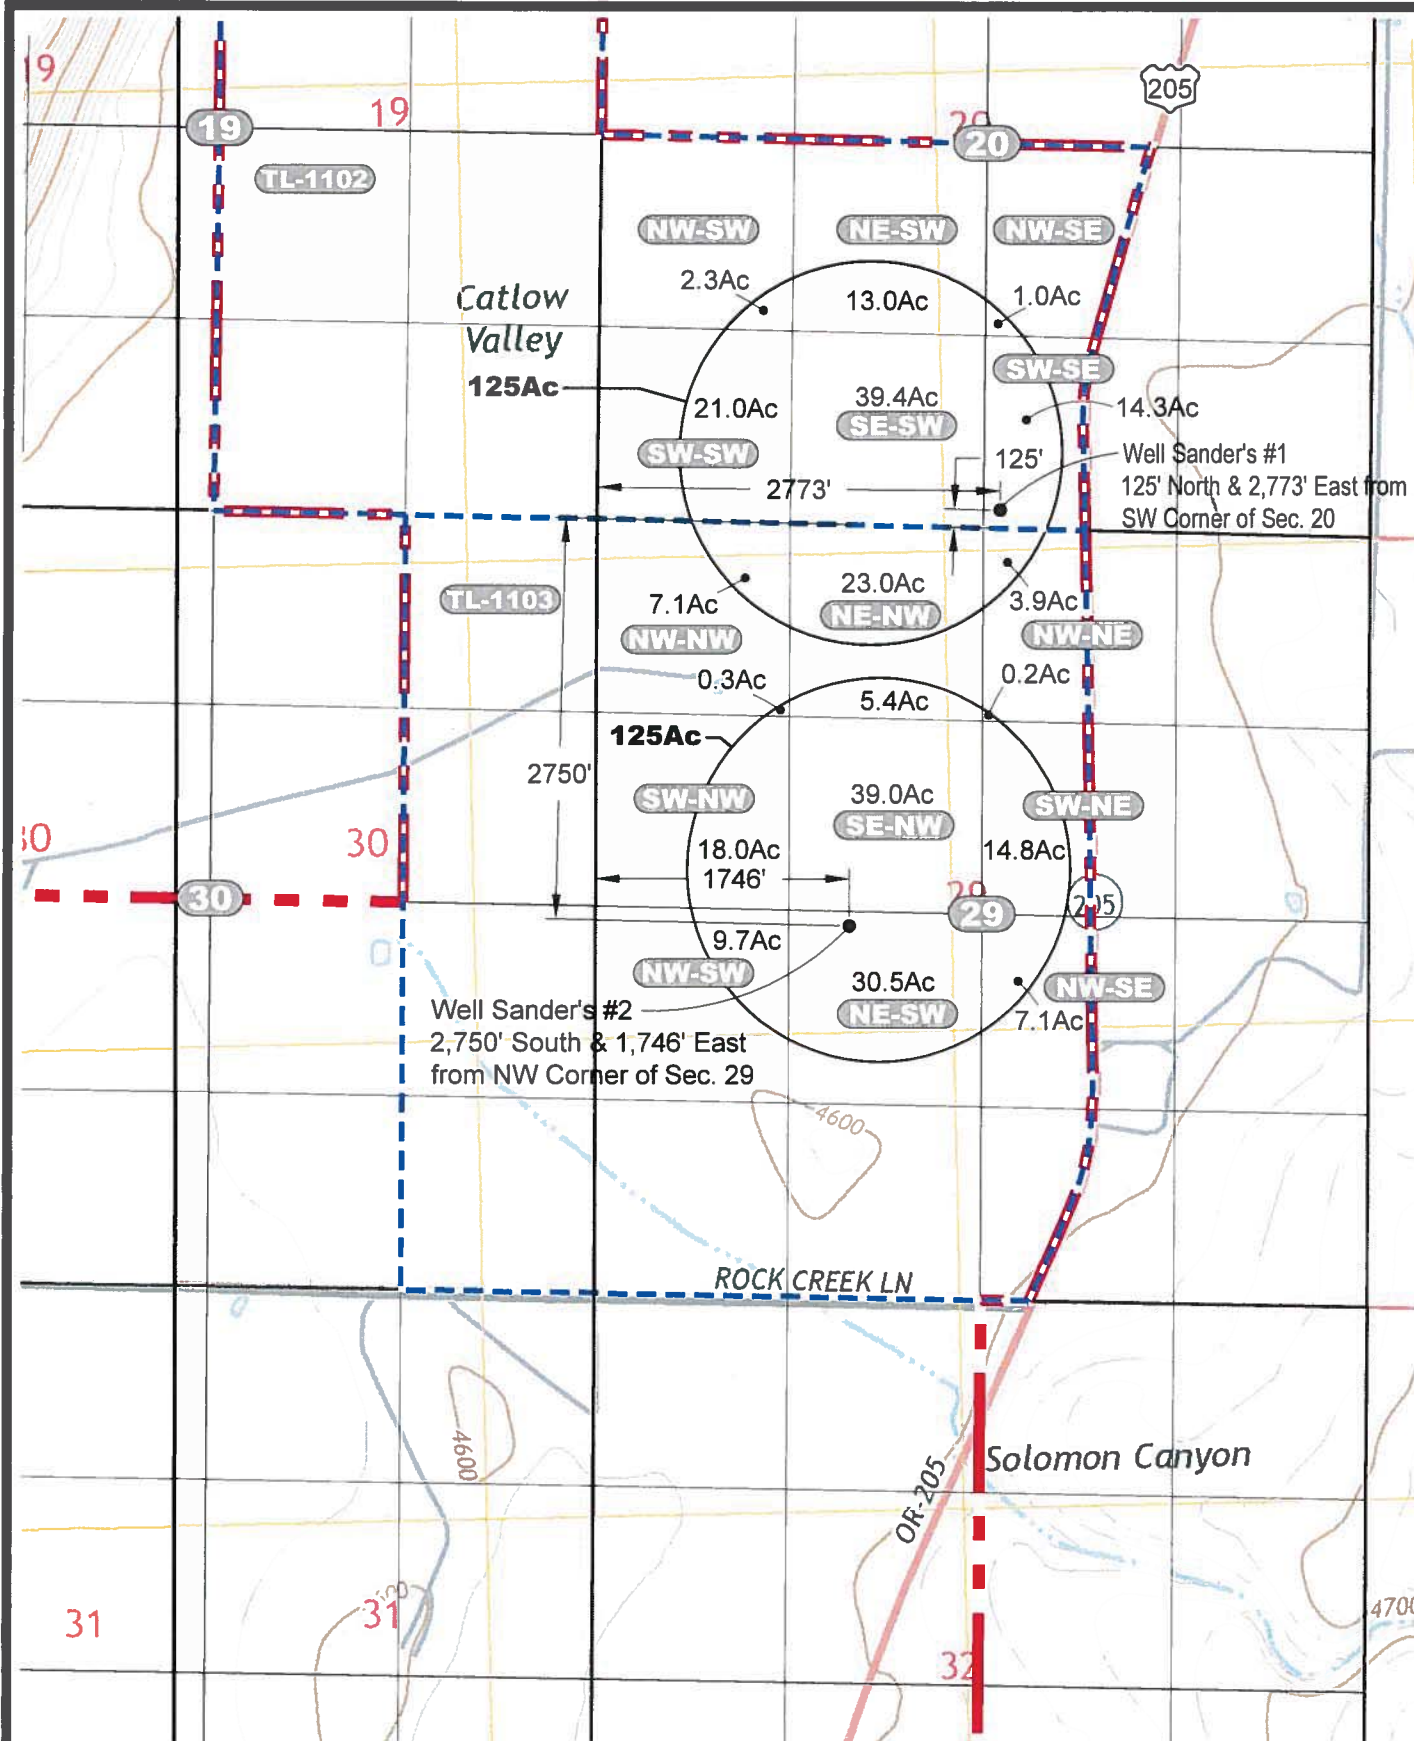

NOTES

1. This map was prepared for the purpose of identifying the location of water rights only and is not intended to provide legal dimensions or locations of property ownership lines.


**WATER RIGHT
APPLICATION G-17921**
TAX LOTS 1102 & 1103
Section 20 & 29, T.32S., R.32E., W.M.
Harney County, Oregon

LEGEND


Roaring Springs Boundary
 Tax Lot Boundary

Area by Qtr-Qtr

SEC	Tax Lot	Qtr-Qtr	Area (Ac)
20	1102	NW-SW	2.3
		NE-SW	13.0
		NW-SE	1.0
		SW-SE	14.3
		SE-SW	39.4
		SW-SW	21.0
Sub-Total			91.0
29	1103	NW-NW	7.1
			0.3
		NE-NW	23.0
			5.4
		NW-NE	3.9
			0.2
		SW-NW	18.0
		SE-NW	39.0
		SW-NE	14.8
		NW-SW	9.7
		NE-SW	30.5
		NW-SE	7.1
Sub-Total			159.0
Total			250.0

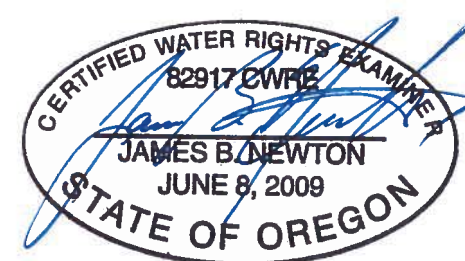


EXPIRES:
RENEWS: 12-31-2016

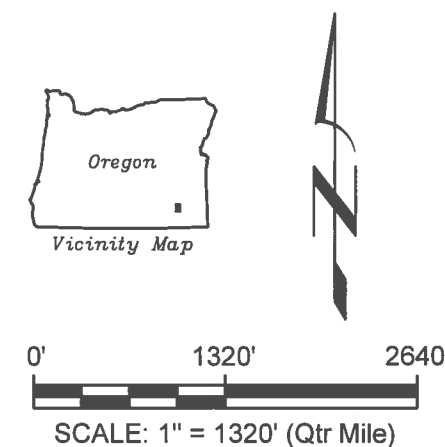


Water Right Application G-17921 Map Roaring Springs Ranch Harney County, Oregon



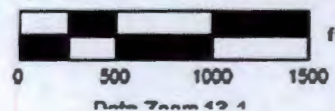

SANDERS WATER RIGHT APPLICATION MAP

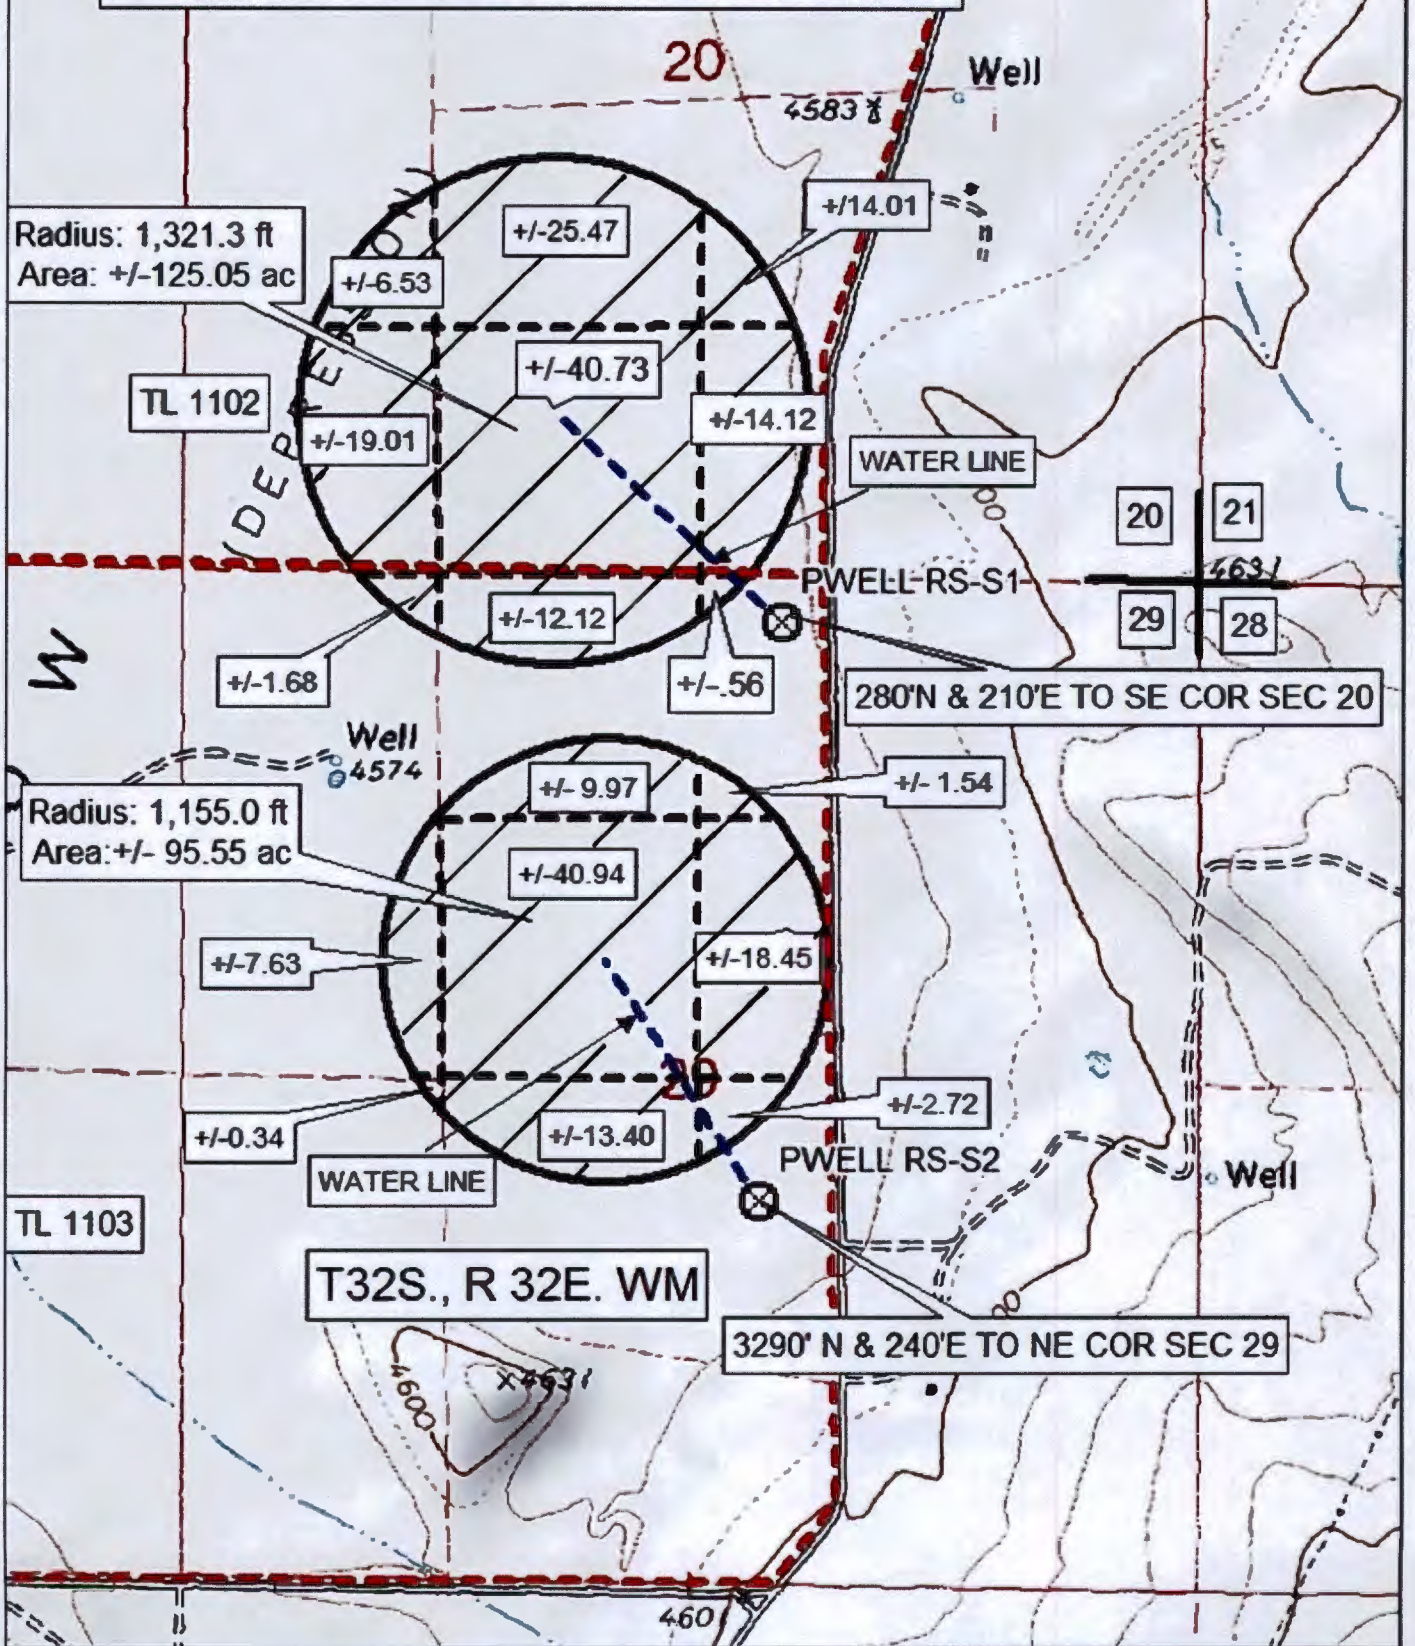


Data use subject to license. RECEIVED BY OWRD

© DeLorme, XMap® 7.

www.delorme.com

SEP 09 2014

0001 24.8 33.51

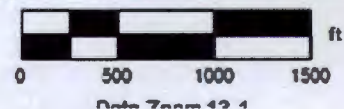

G17921

SALEM, OR