


T.3S. R.4E. Section 15, W.M.

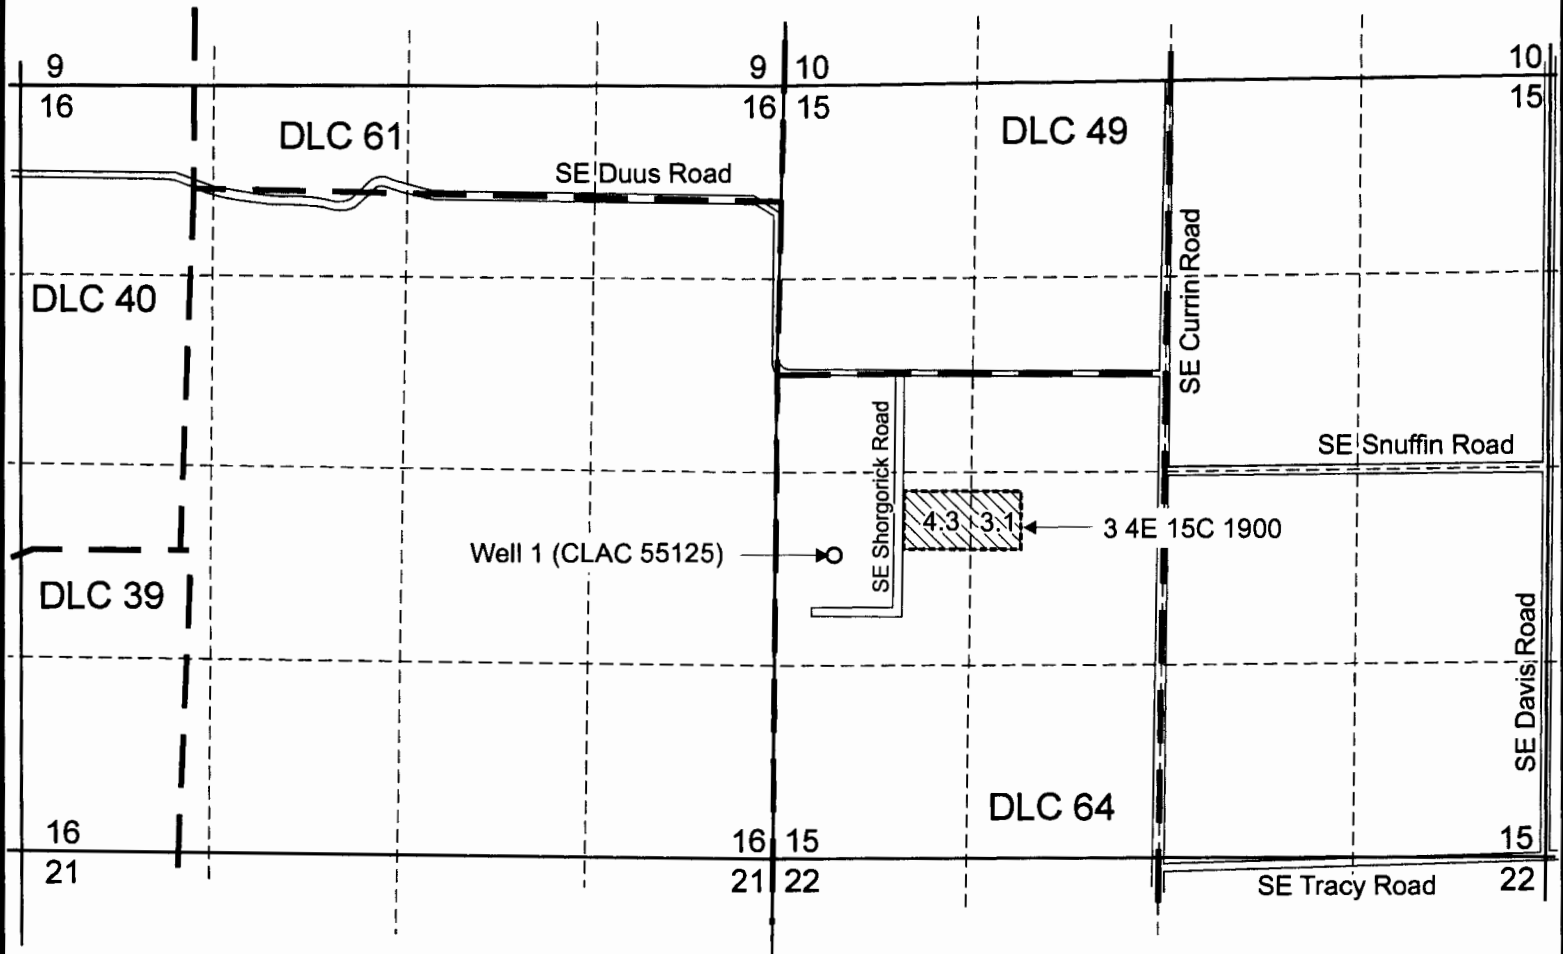


Well 1 (CLAC 55125) is located 600 feet south and 400 feet east from the W1/4 corner, Section

RECEIVED

 Area (7.4 Acres) proposed for irrigation use.

 Tax Lot Boundary

 Donation Land Claim (DLC) Boundary

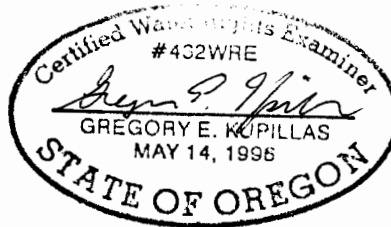


SEP 18 2014

WATER RESOURCES DEPT
SALEM, OREGON

EXPIRATION DATE: 6/30/2014

Scale: 1" = 1,320'

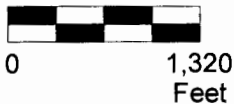

This map was prepared for the purpose of identifying the location of a water right only and is not intended to provide legal dimensions or location of property ownership lines.



Water Right Application Map

Pacific Hydro-Geology Inc.

Rickel's Tree Farm LLC/Bobby Daniel Rickel
T.3S. R.4E. Sec. 15, W.M.

2014 - bgp

G-17928