


PERMIT AMENDMENT MAP
LOCATED IN THE SOUTHWEST ONE-QUARTER OF SECTION 1
AND THE NORTHEAST ONE-QUARTER OF SECTION 12,
TOWNSHIP 27 SOUTH, RANGE 33 EAST, AND IN
THE NORTHWEST ONE-QUARTER OF SECTION 7, AND
TOWNSHIP 27 SOUTH, RANGE 34 EAST, WILLAMETTE MERIDIAN,
HARNEY COUNTY, OREGON

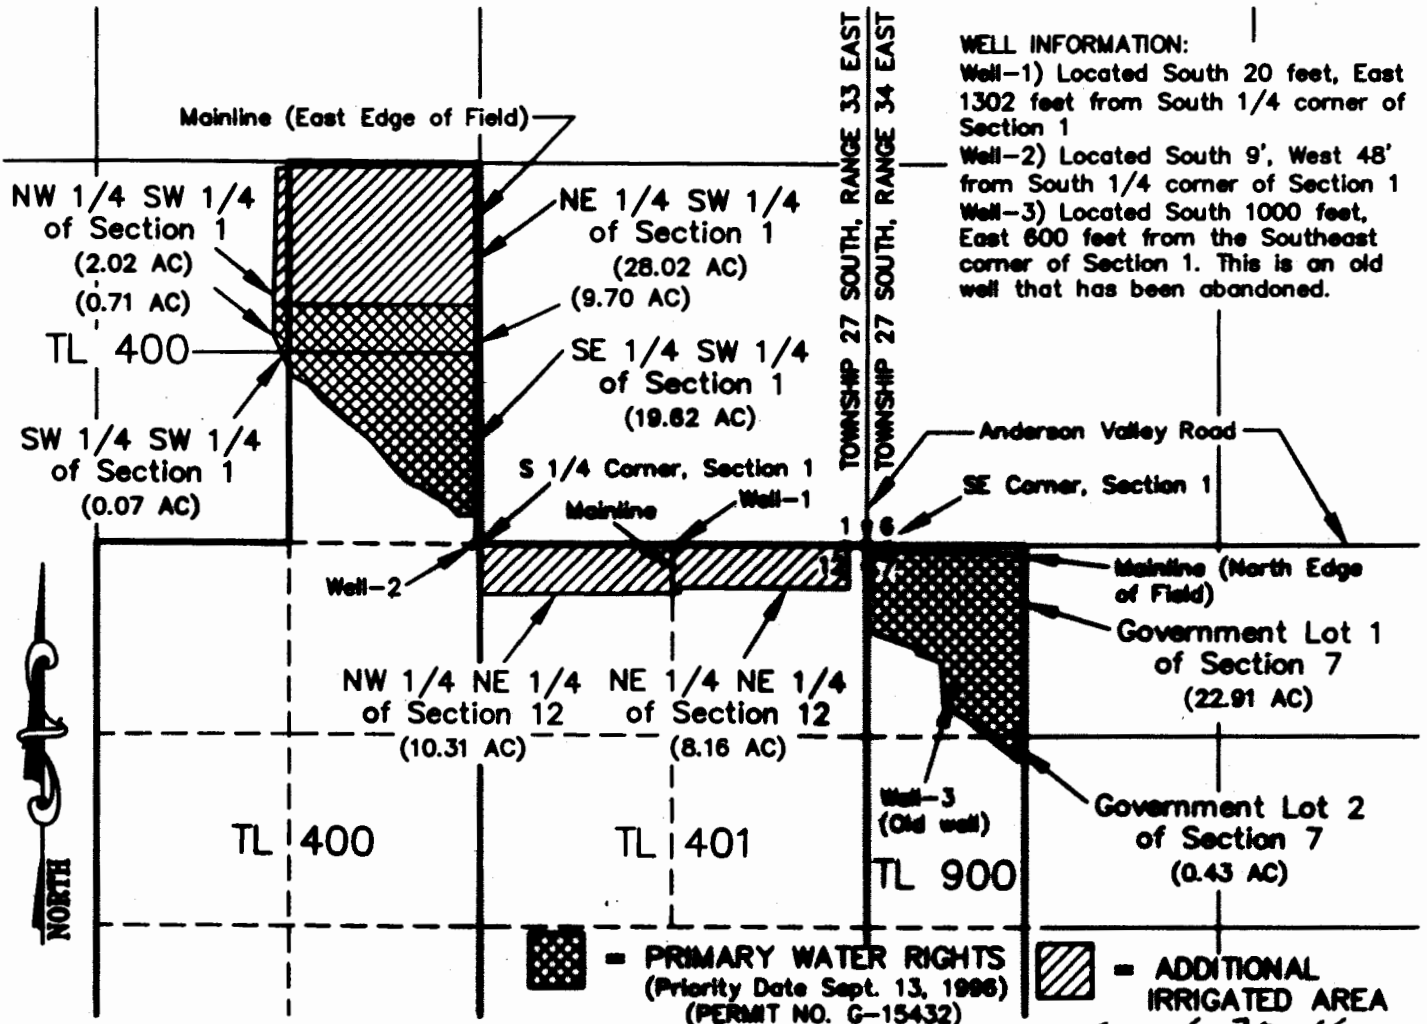

I, Michael W. Tye, Certified Water Right Examiner in the State of Oregon, hereby certify that this water rights survey map was prepared under my direct supervision.

The preparation of this map is for the purpose of identifying the location of the water right only and has no intent to provide dimensions or locations of property ownership lines.



PERMIT NO. G-15432

SCALE 1"=1320' DATE 08-19-14 SURVEY BY SURVEY DRAWN BY K.B. ORDER NO. 7083-22b

SUN COUNTRY ENGINEERING & SURVEYING, INC.
920 SE ARMOUR ROAD BEND, OREGON 97702 PHONE 382-8882

C-17940