RECEIVED BY OWRD

SEP 29 2014

SALEM, OR

T 18 S, R 3 W Sec 25

TL 113, pond in SE 1/4, NE 1/4

Dam 1125' N & 1290' W from E 1/4 Cor Sec 25

Scale 1" = 300'

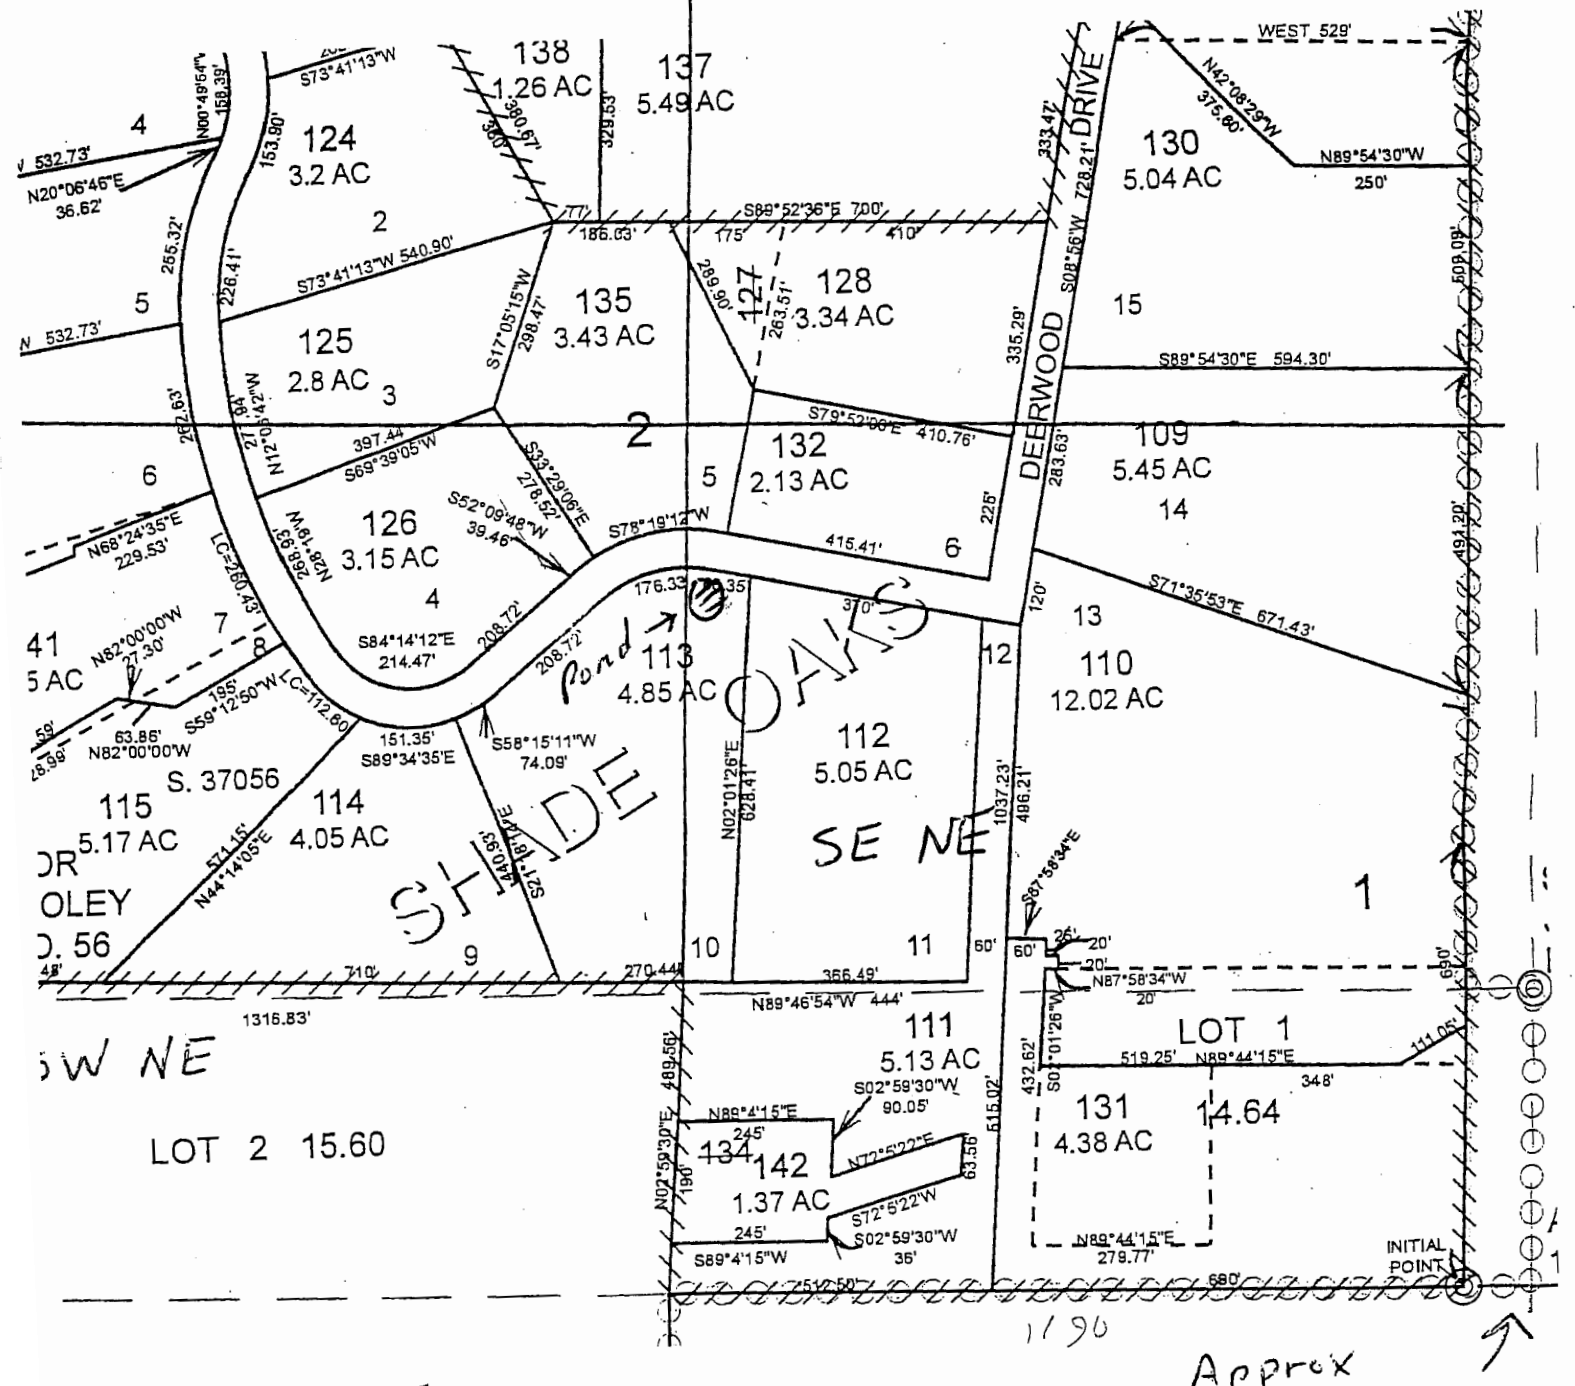


R-88015

Approx 1/4 Cor