

Jesse Wolfe

1" = 1320'

Tax Lot: 102

RECEIVED BY OWRD RECEIVED BY OWRD

OCT 03 2014


AUG 25 2014



Township 14 South, Range 7 West, Section 4

SALEM, OR

SALEM, OR

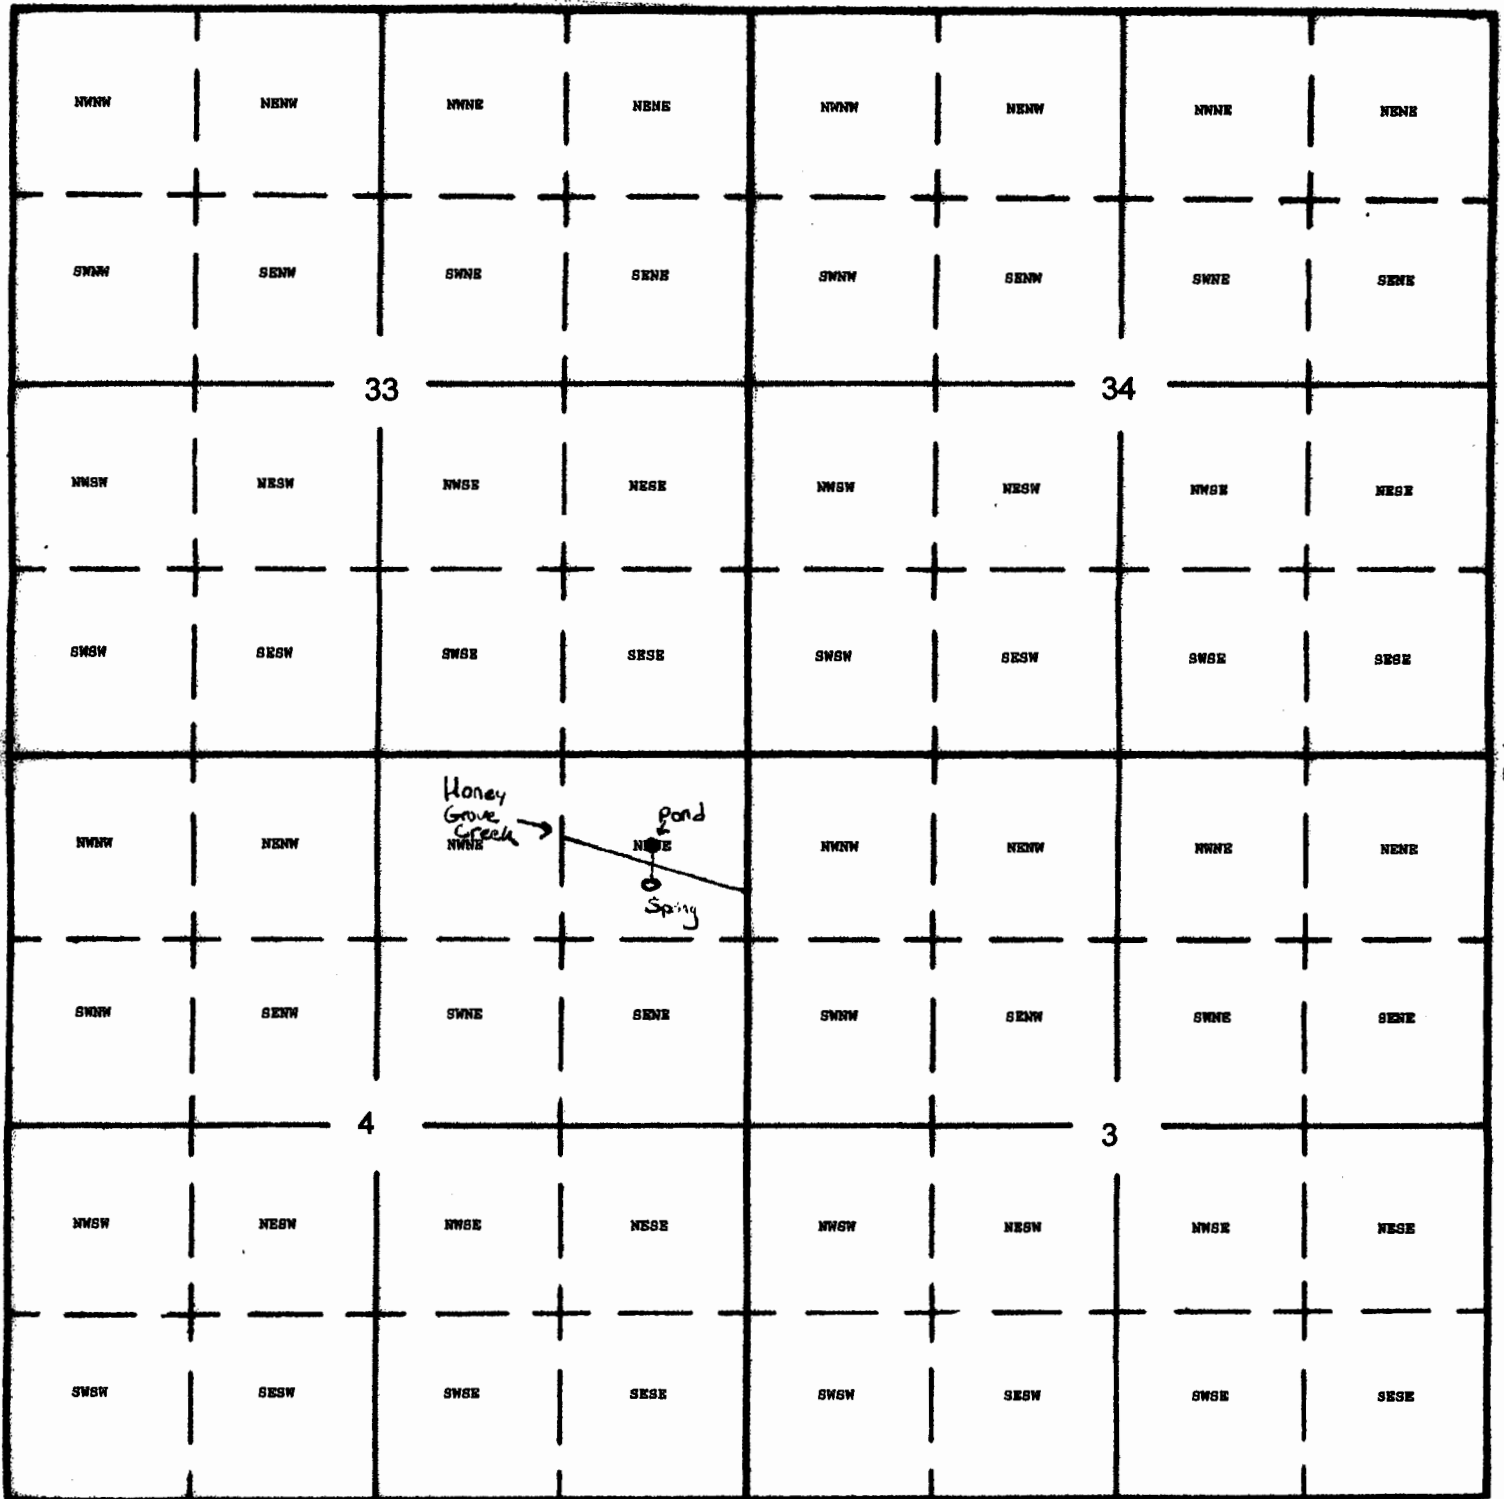

Pond Location: 2 AF excavated pond located 660 feet south and 650 feet west of the NE corner of Section 4

Spring Location: 920 feet south and 650 feet west of NE corner of section 4
R-8806

Jesse Wolfe

1" = 1320'


Tax Lot: 102

OCT 03 2014

SALEM, OR



Township 14 South, Range 7 West, Section 4

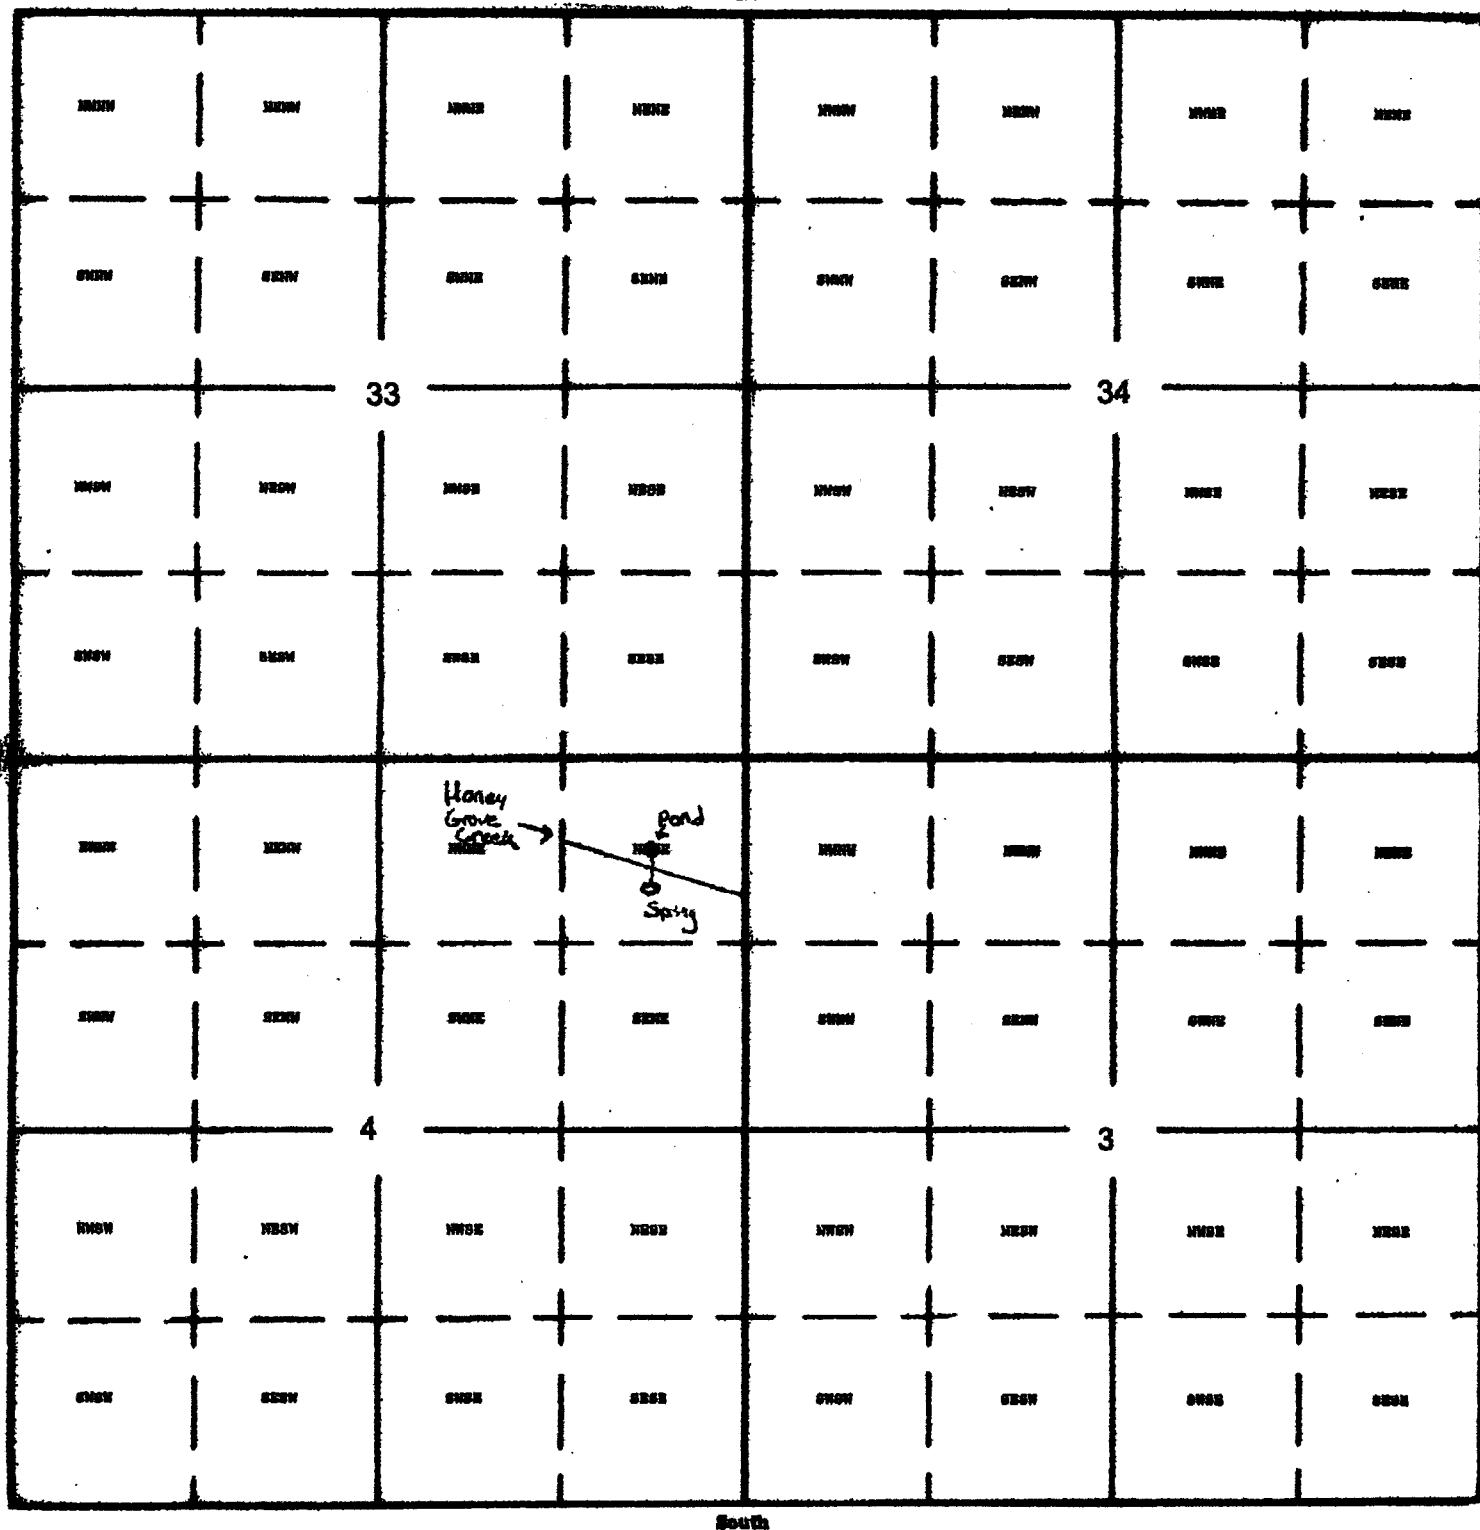

Pond Location: 2 AF excavated pond located 660 feet south and 650 feet west of the NE corner of Section 4

Spring Location: 920 feet south and 650 feet west of NE corner of section 4
R-8804