


T36S R6W SE Section 14

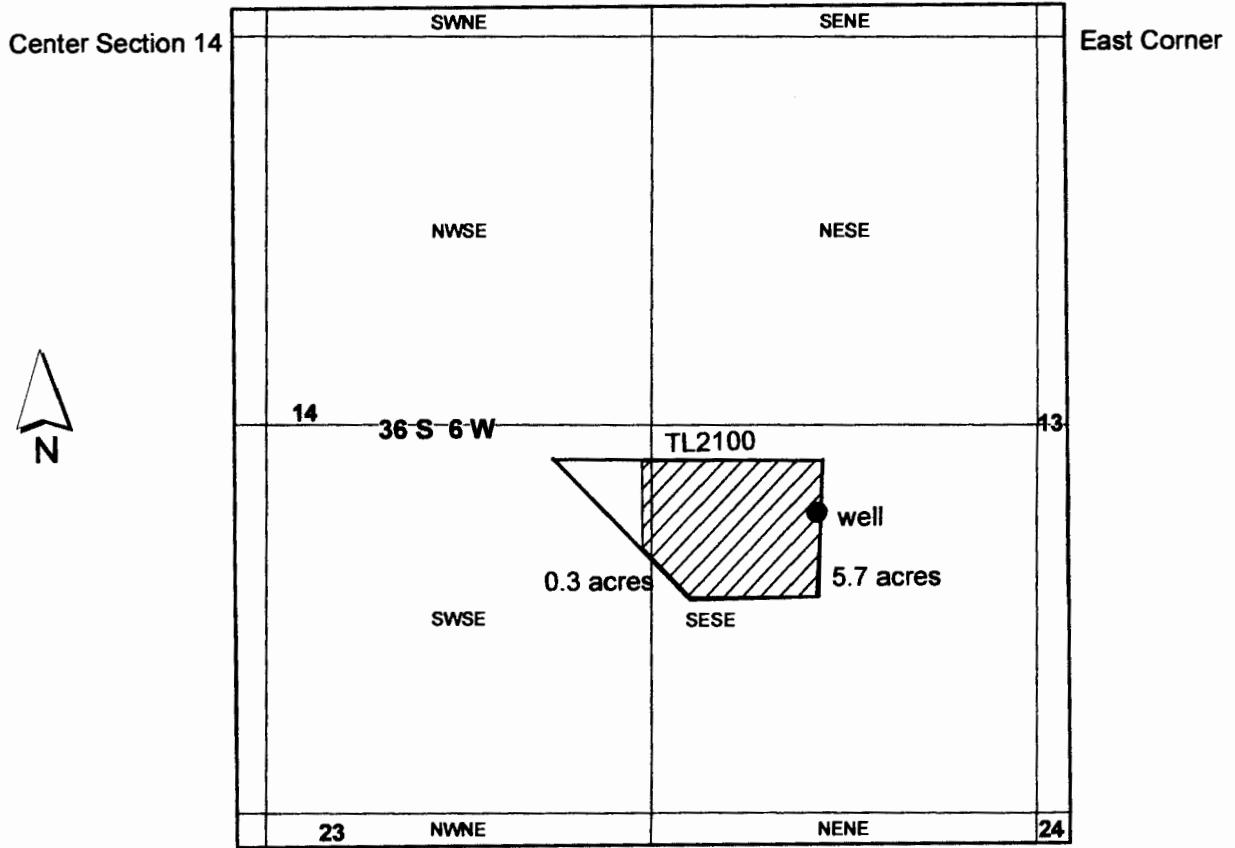

1 inch = 660 feet

Well is 766 ft west and 1646 ft south from the east corner of Section 14

RECEIVED BY OWRD

OCT 10 2014

SALEM, OR

G-77939