

OCT 17 2014

SECTION PLAT


OCT 07 2014

SALEM, OR

SALEM, OR

Section 12 Township 33 Range 30

County of Harney State of Oregon

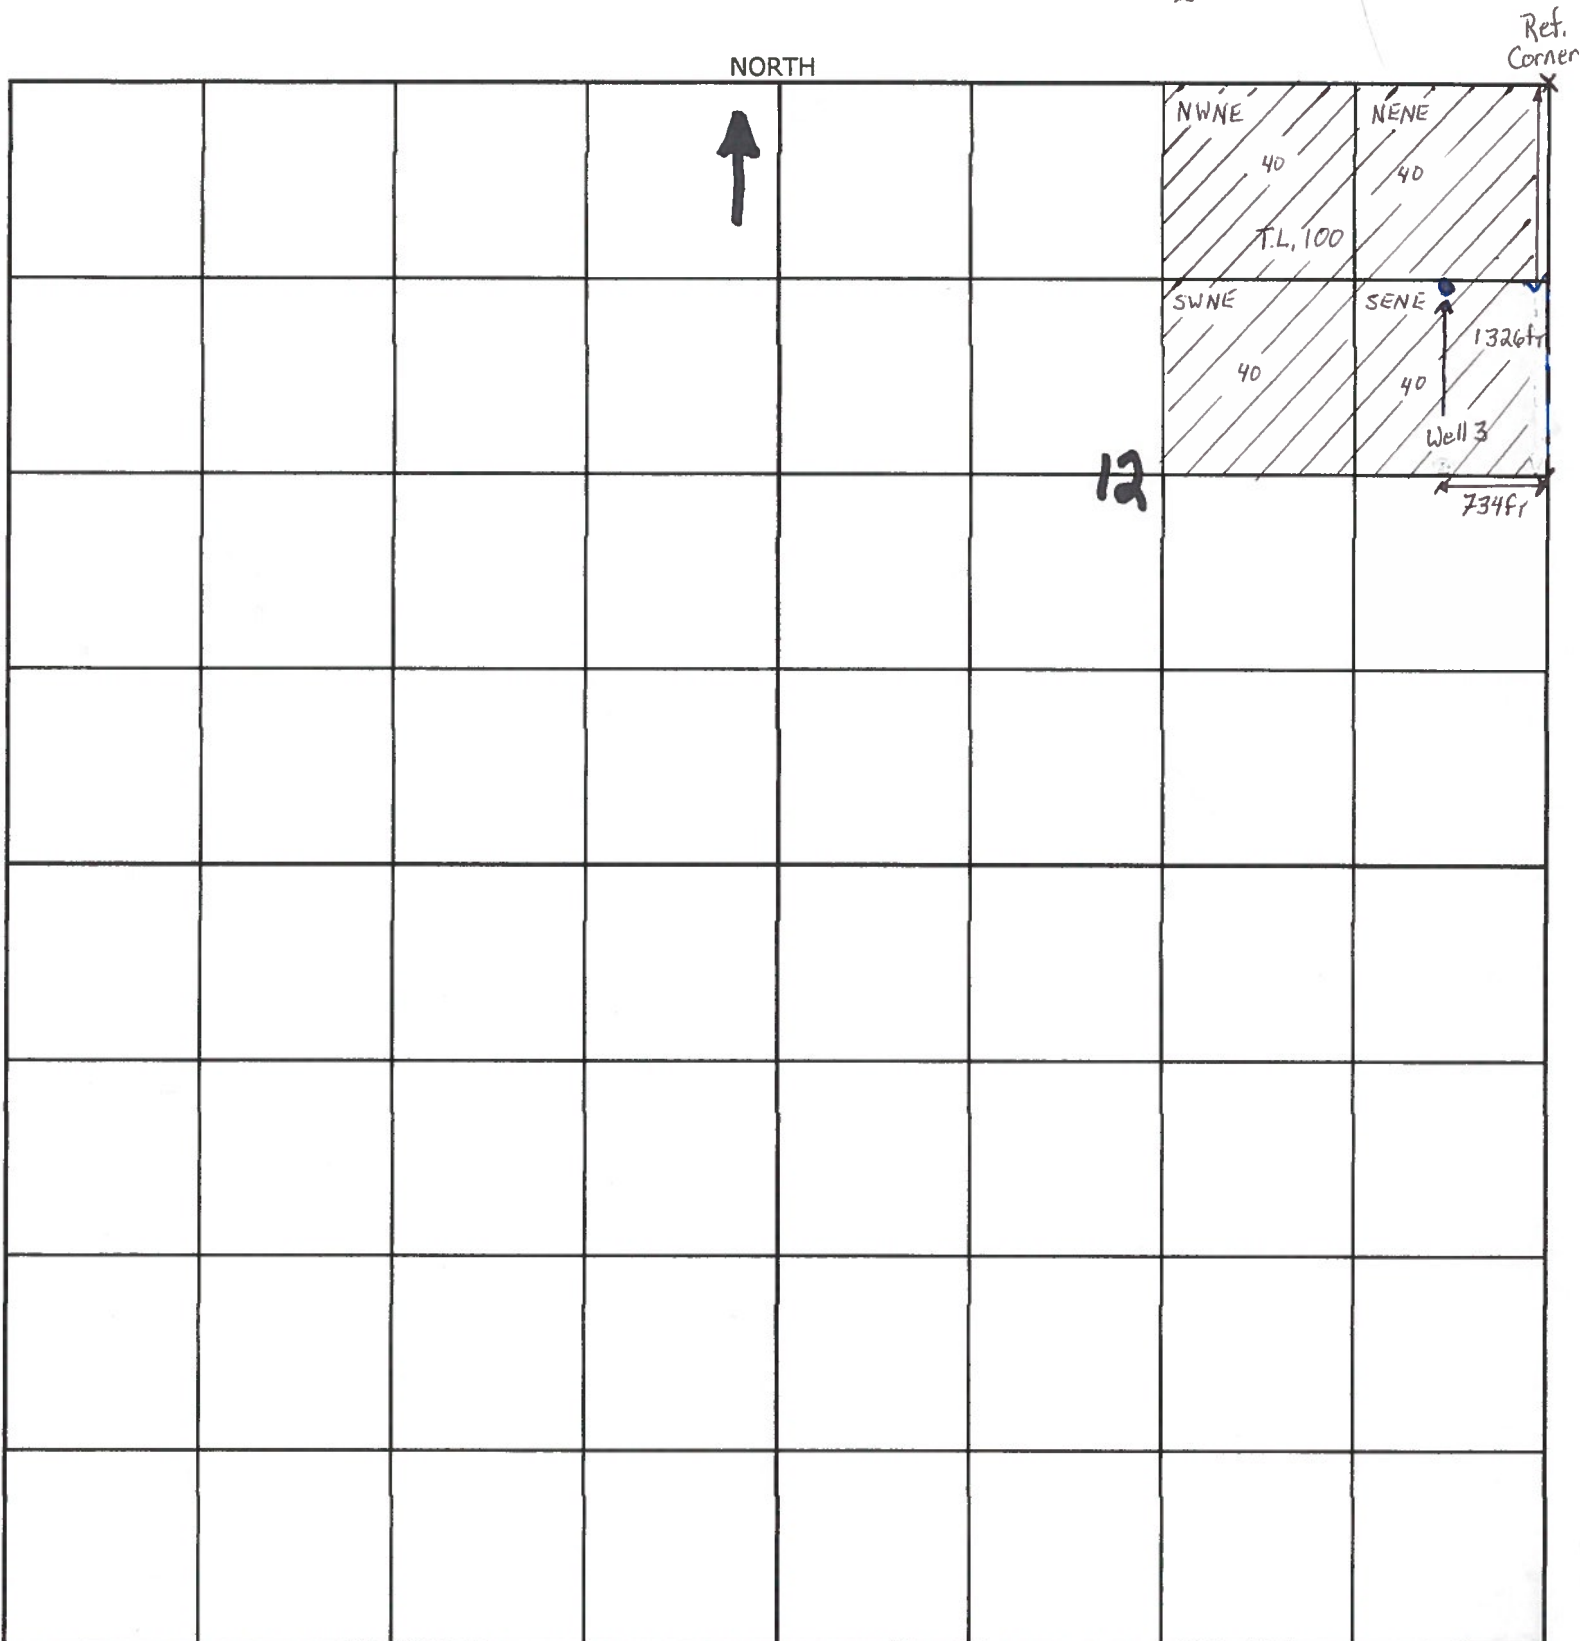

G-17943

4"=1 mile