


Appl. 62057  
Permit 46139  
Cert. 54822  
Pr. 8-3-81  
Finder: Basin 15-Vol. 6  
Applegate River

P. 46139

T. 39S., R. 3W., W.M.

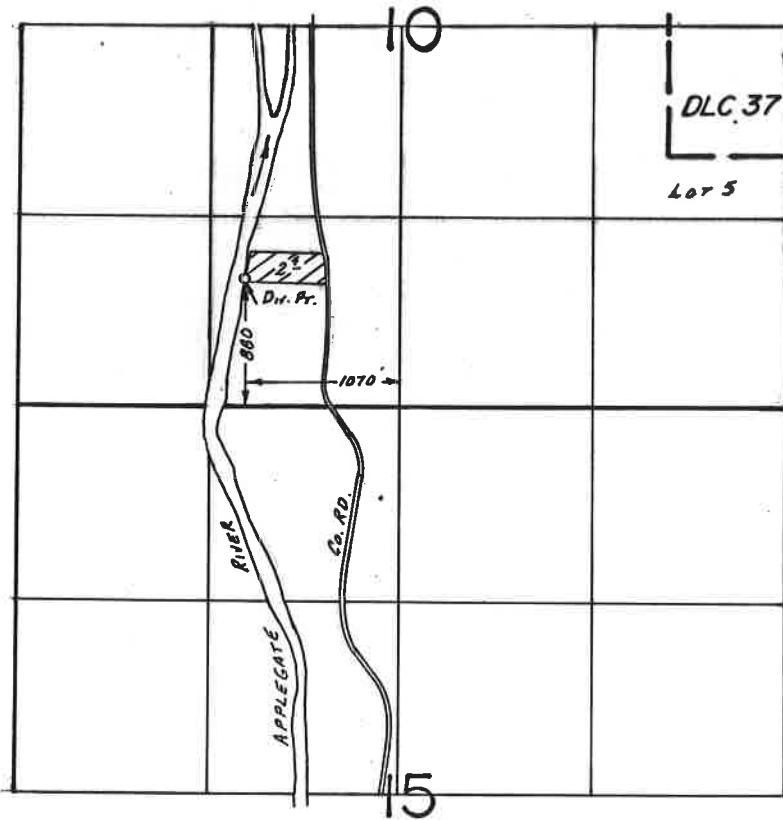

SCALE: 1" = 1320'

*Supplemental*  
*Primary*  
*# 22765*  
*Pr. 12-16-53*

**FINAL PROOF SURVEY**  
**UNDER**

Application No. 62057... Permit No. 46139... *Cert. 54822*  
IN NAME OF

.....KENNETH E. SNELLING.....


Surveyed July 3..... 19.85, by B.S. JAMES.....

RECEIVED

AUG 3 1981

WATER RESOURCES DEPT  
SALEM, OREGON

MAD  
Permit 2276 P. 46139  
Priority 12/16/80  
Applegate  
Vol 6

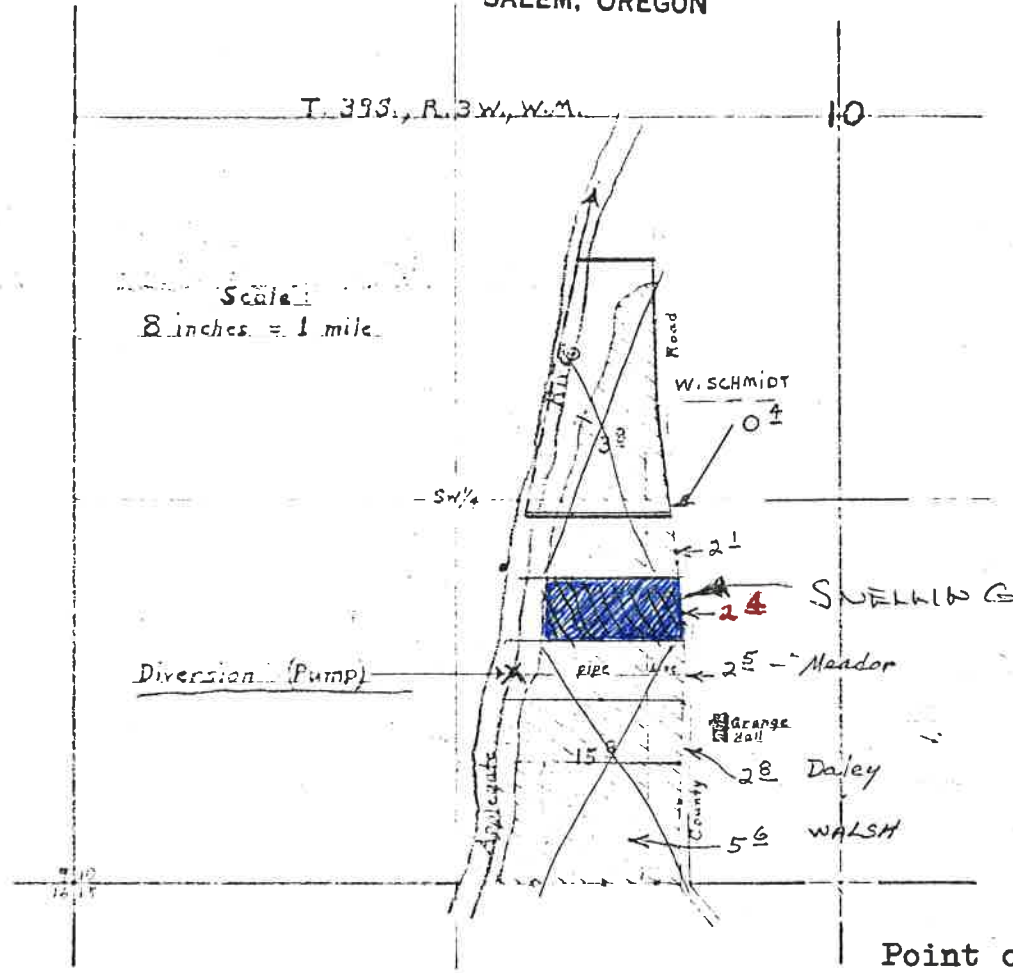

Application No. 62057  
Permit No. 46139

Point of diversion:  
725' N. and 1125 ft. W.  
from the SW 1/4 of Sec. 10  
T. 39 S., R. 3 W.  
being within the  
SE 1/4 SW 1/4.

Kenneth E. Snelling  
Application map to accompany application to appropriate  
4 acre feet of storage waters of Applegate Lake Reservoir  
to supplementally irrigate above blue shaded land.

UNDER  
Application No. 28938 Permit No. 22765

F. C. Preston, Jr.

Submitted Feb. 15 1981 by D.C. Hendrix, WM.

CERT. 22553  
RECEIVED  
FEB 1 1982  
WATER MASTER  
District 13