


Application Map T3S R1E Sec 21

Scale
1" = 1320'
1" / 1320'
↑
N

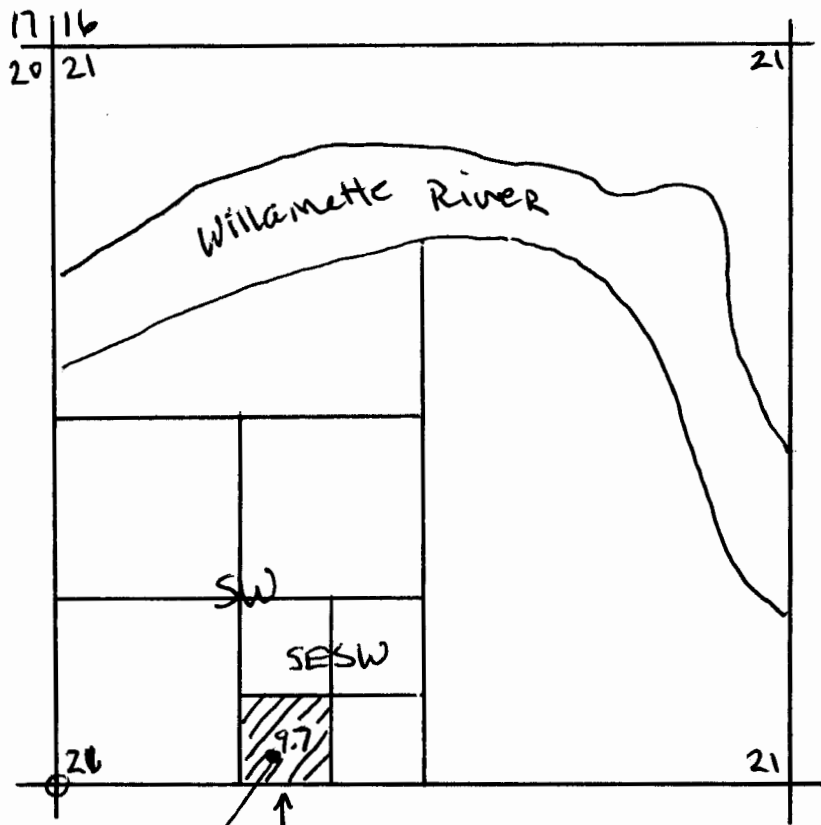

WELL LOCATION:
165' N + 1485' E from SW Corner Section 21

RECEIVED BY OWRD

NOV 19 2014

SALEM, OR