


T.5S. R.2W. Section 36, W.M.

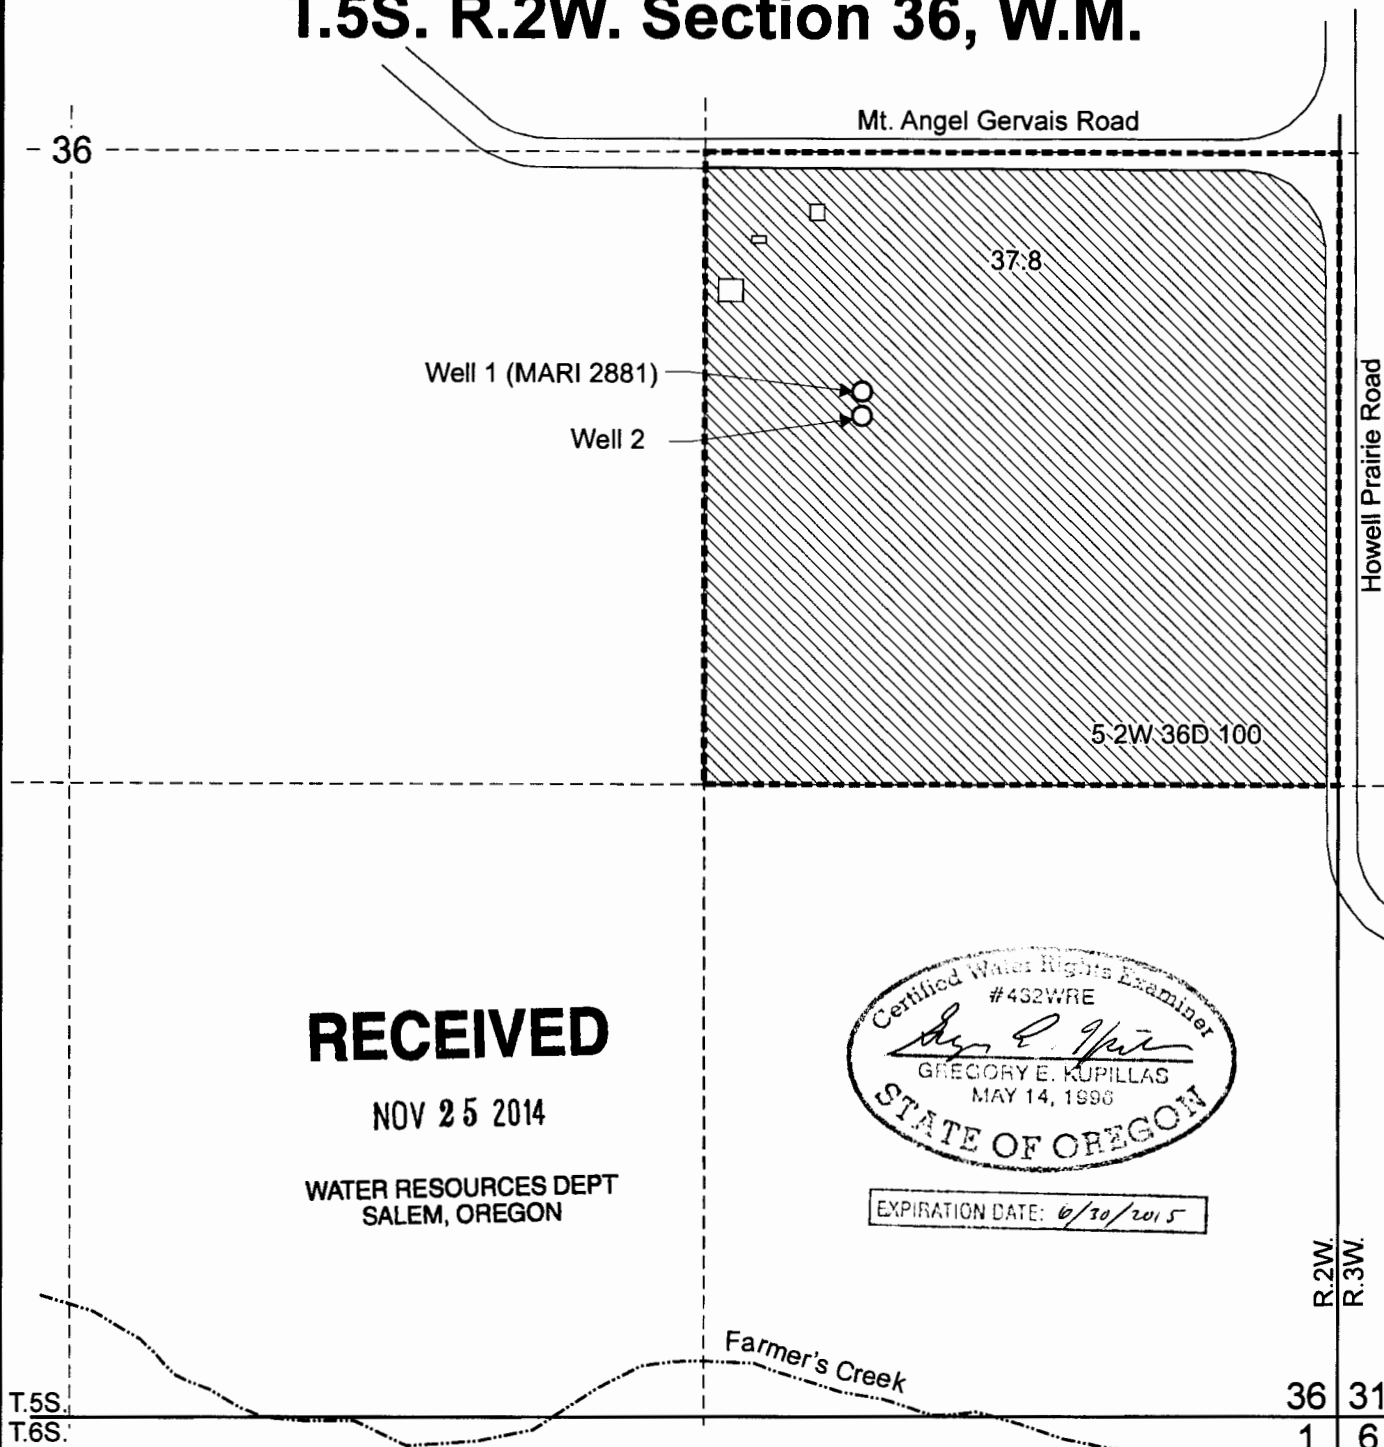


Well 1 (MARI 2881) is located 2,140 feet north and 990 feet west from the SE corner, Section 36.
Well 2 is located 2,090 feet north and 990 feet west from the SE corner, Section 36.

 Areas (37.8 acres) irrigated under GR 124
 ----- Tax lot boundary

This map was prepared for the purpose of identifying the location of a water right only and is not intended to provide legal dimensions or location of property ownership lines.

Scale: 1" = 400'

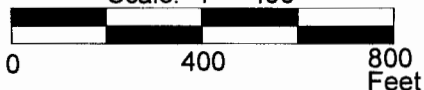

Pacific Hydro-Geology Inc.

2014 - bgp

Water Right Permit Application Map

Gardenscape Nursery Inc/Paul Kuschnick
T.5S. R.2W. Section 36, W.M.