

Fischer

Greg Fisher
1" = 1320'

$$1'' = 1320'$$


Tax Lot: 100

DEC 11 2014

↑ North

SALEM, OR

Township 3 South, Range 3 West, Section 15 NWSW

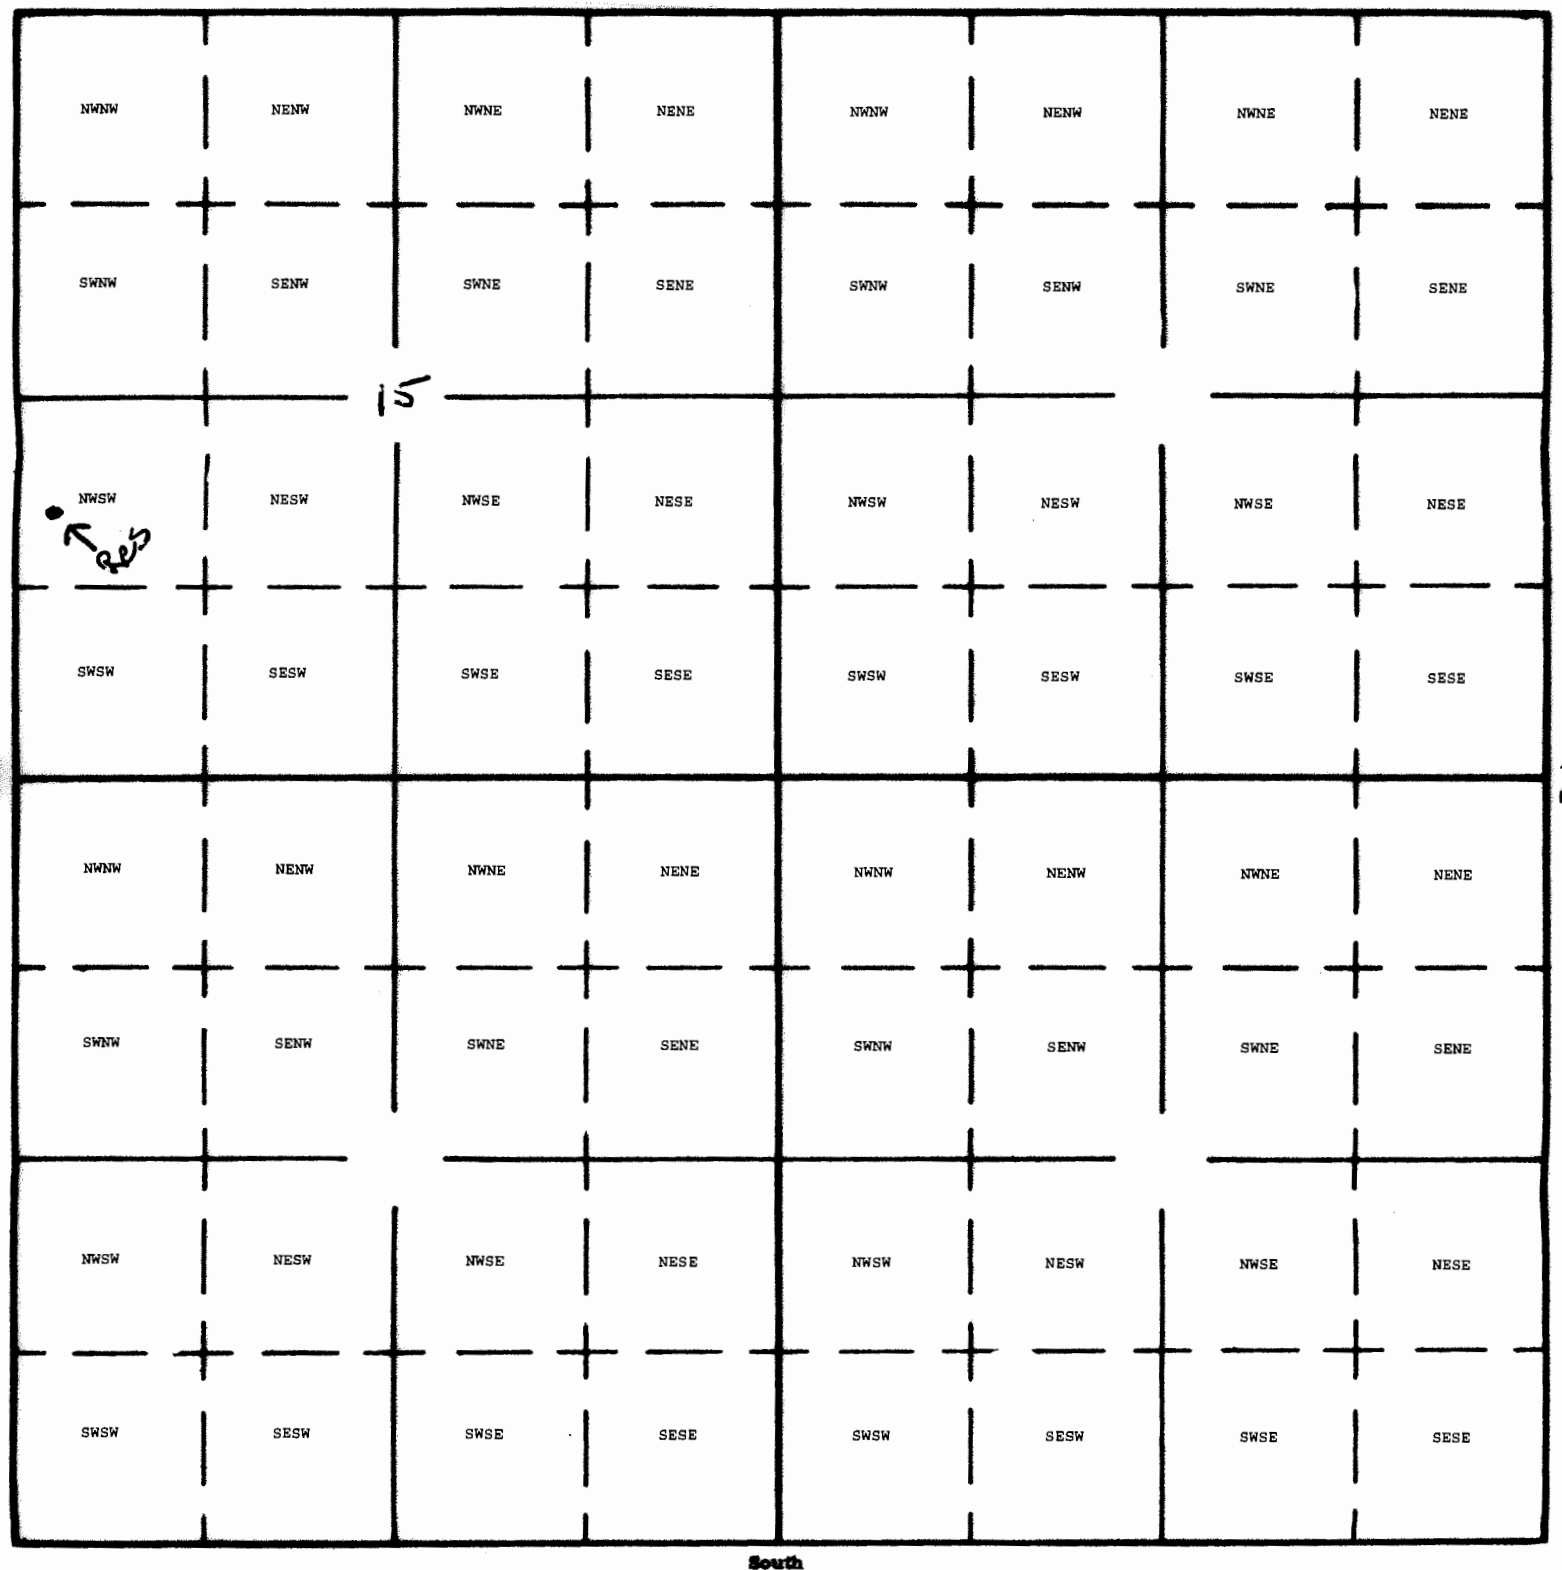

Dam Location: 1810' North and 265' East from SW Corner Section 15

SDG

R-88038

11-22-14

RECEIVED BY OWRD

DEC 11 2014

SALEM, OR


REVISED 12-11-95

THIS MAP WAS PREPARED FOR
ASSESSMENT PURPOSE ONLY

NW 1/4 SW 1/4 SEC 15 T3S R3W W.M.
YAMHILL COUNTY
1" = 100'

SEE MAP 3 3 15

SEE MAP 3 3 16

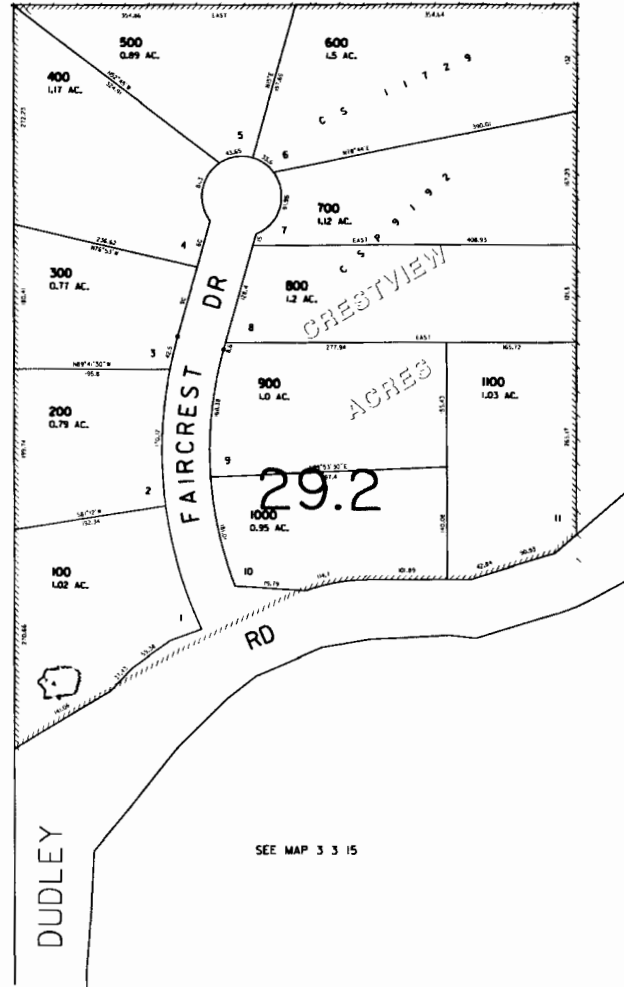

SEE MAP 3 3 15

SEE MAP 3 3 15

3 3 15CB

CANCELLED

[Handwritten signature]

h1-22-11

R-08018

3 3 15CB