


Post-it <sup>®</sup> Fax Note 7671		Date 1-3-97	# of pages 1
To <i>Suzgy II</i>	From <i>Sue</i>		
Co./Dept.	Co.		
Phone # <i>474-5389</i>	Phone #		
Fax #	Fax #		

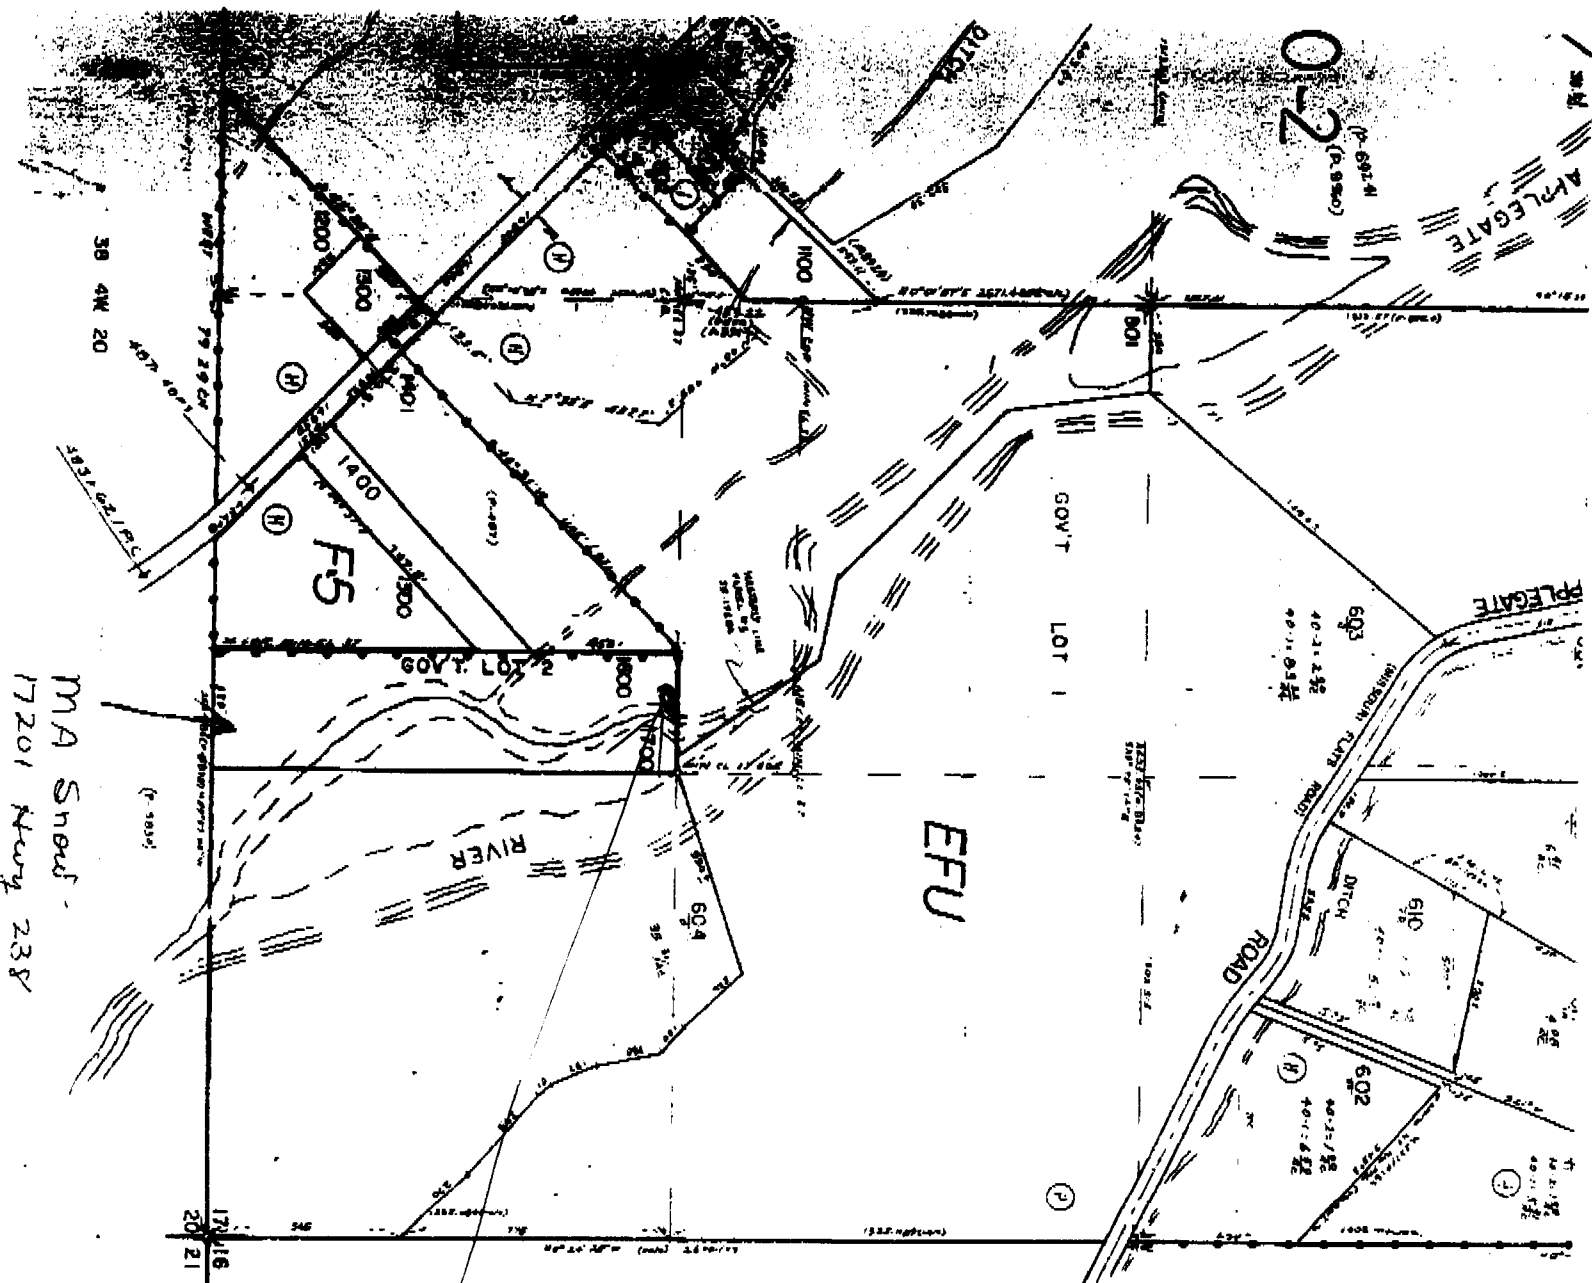

MA Shoul  
17201 Hwy 238

→ POND

Application No.  
Permit No.

P-83066