


SECTION PLAT

Section 2,3,10,11 Township 39 Range 37
County of Harney State of OR

NORTH

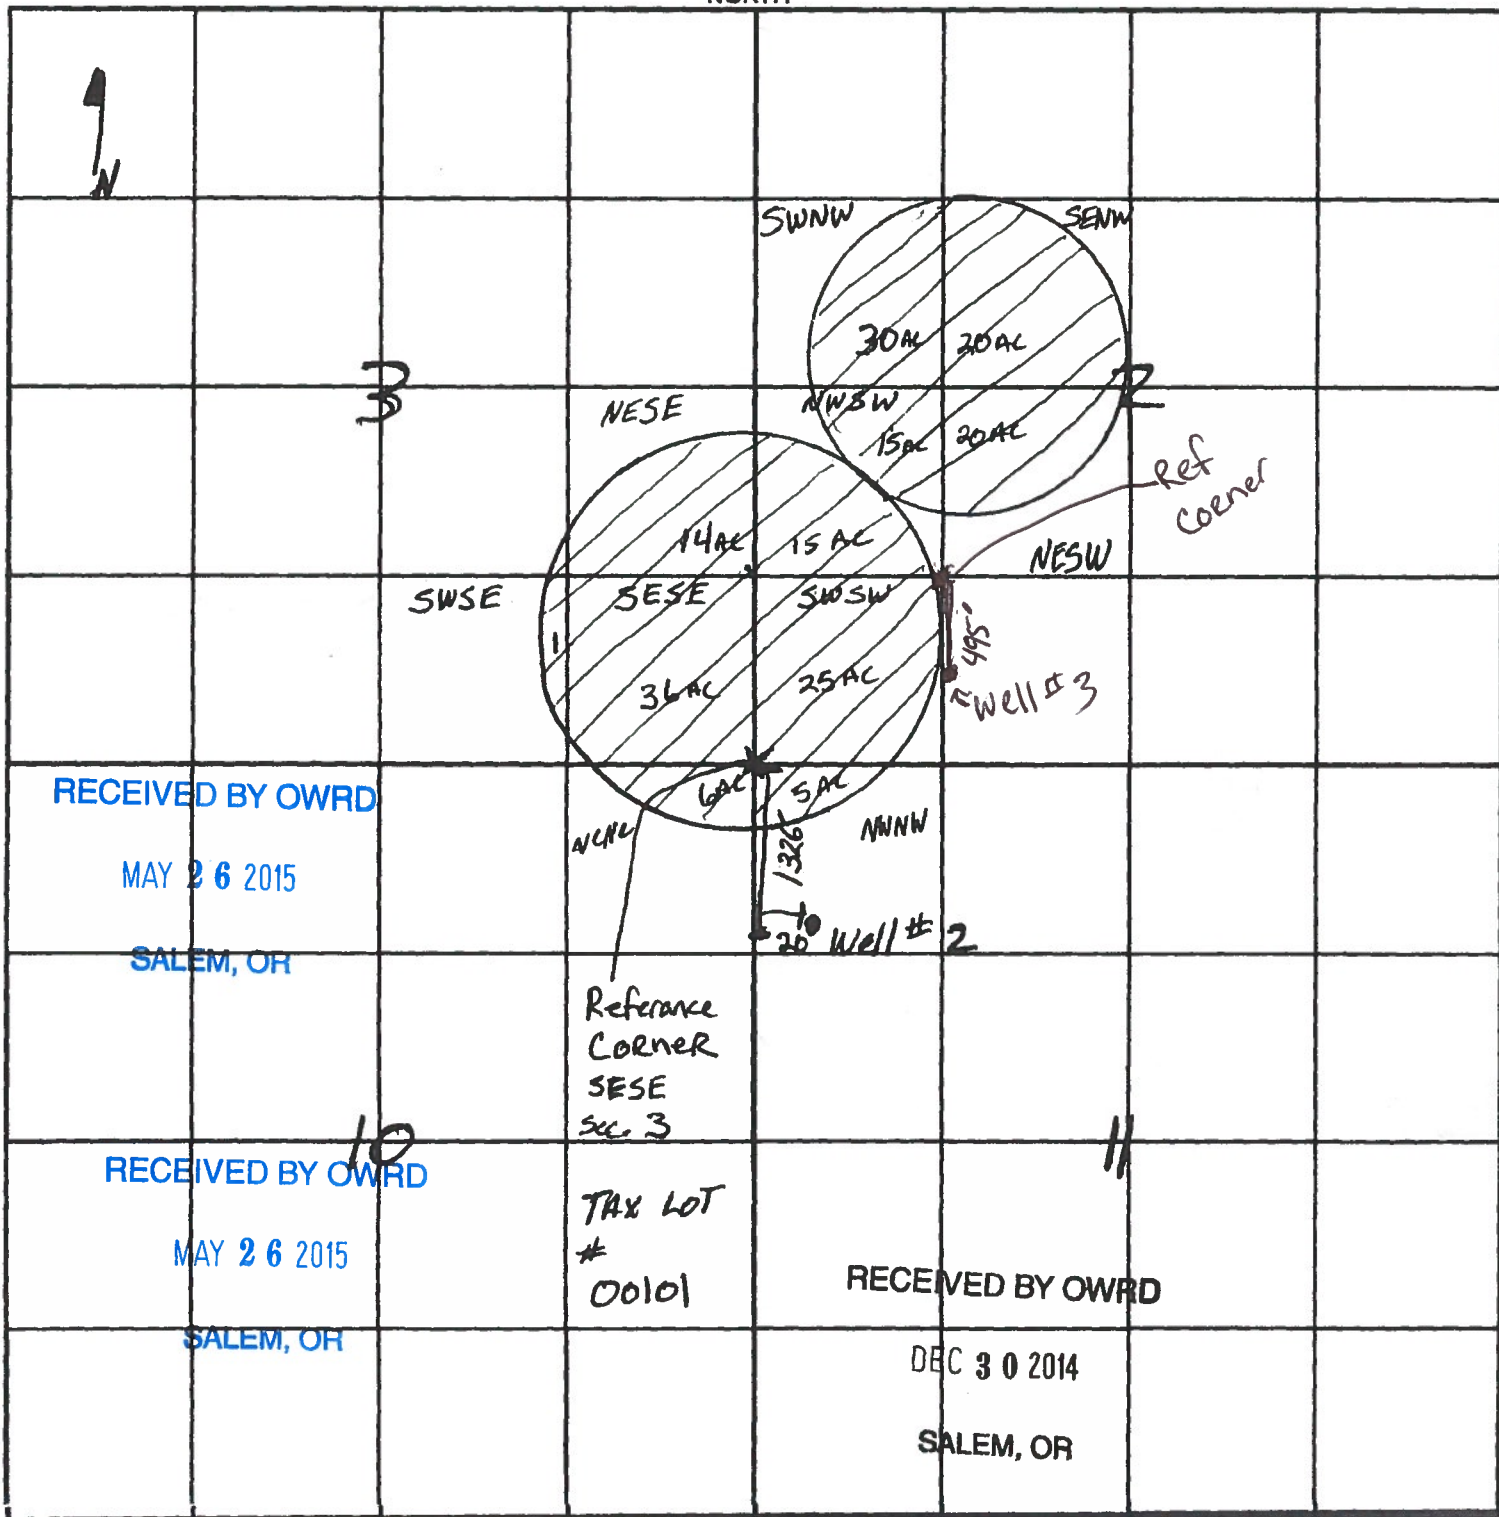

G-17979

4"=1 mile