


TAX MAP AND LOT 17 03 24 32 00201
TL 201

1" = 1320'

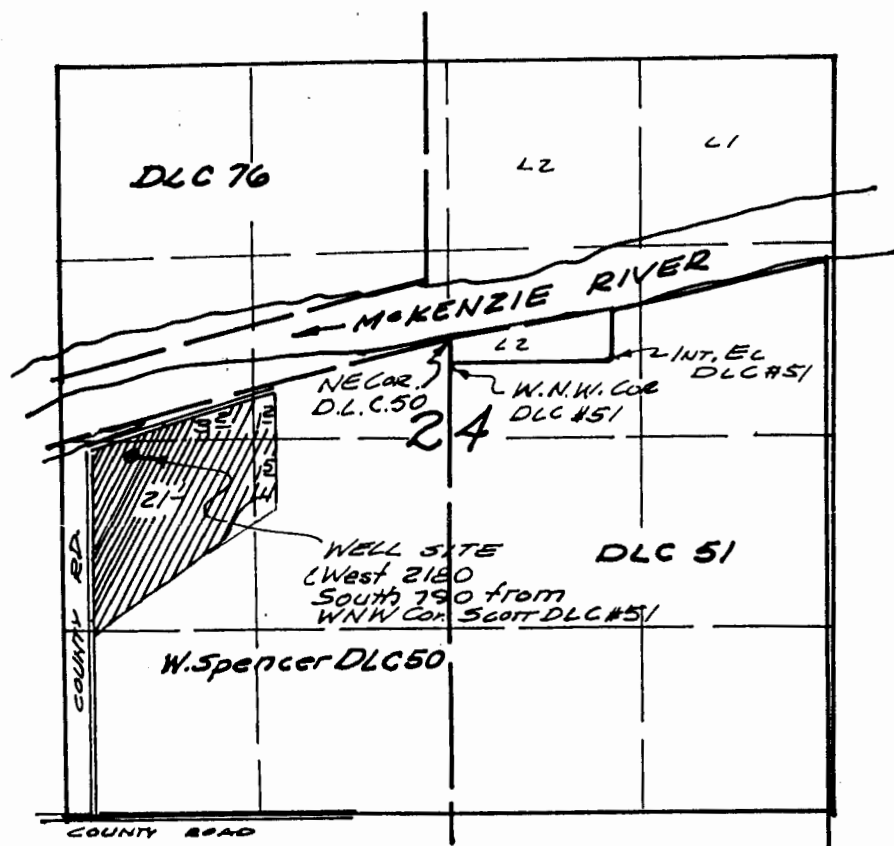

SEC. 24 - T17S - R3W - W.M.

RECEIVED BY OWRD

JAN 09 2015

SALEM, OR

Gr-17981