


T 18 S, R 5 W, Sec 6
 pond in SE 1/4, SE 1/4, TL 101
 scale 1" = 500'

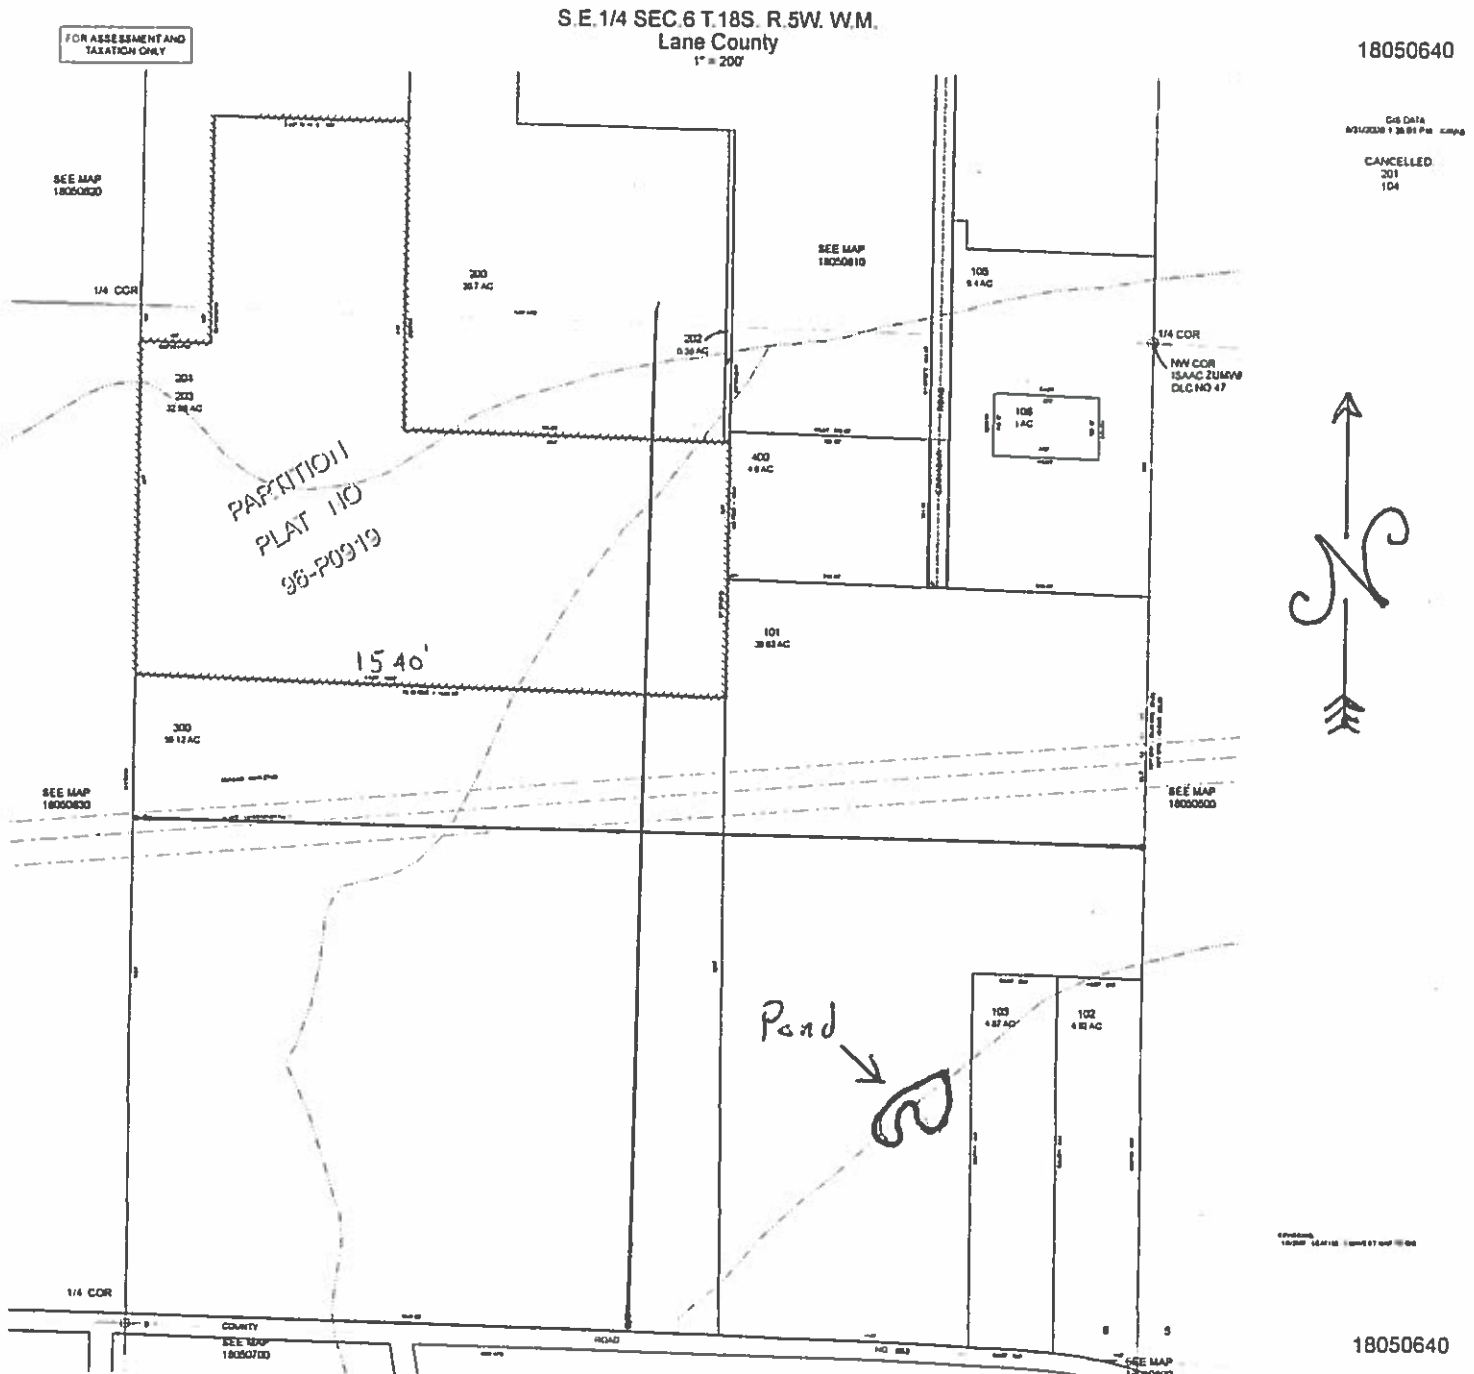

Dam is 670' N & 500' W from
 SE Cor Sec 6

R-88028