

LEGEND

LINE TYPES

- TAX LOT BOUNDARY OLD PROPERTY LINE
- ROAD RIGHT-OF-WAY VACATED RIGHT-OF-WAY
- RAILROAD RAILROAD RIGHT-OF-WAY
- STREAM, LAKE, ETC. STREAM, LAKE, ETC.
- TAX LOT BOUNDARY NON-BOUNDARY
- SUBDIVISION BOUNDARY PARTITION PLAT BDY.
- TAX CODE BOUNDARY EASEMENT

SYMBOL TYPES


- DLC
- CONTROL POINTS
- SURVEY MONUMENTS
- G.L.O. CORNERS
- SECTION 1/4 SEC 1/16 SEC

NUMBERS

TAX CODE NO.
000 00 00 0

ACREAGE - ALL ACREAGES EXCLUDE ANY PORTION THAT MAY LIE WITHIN THE INDICATED PUBLIC RIGHT OF WAYS

TICK MARKS - WHEN A TICK MARK IS INDICATED ON THE EXTENSION OF A LINE, THEN THE DIMENSION GOES TO THE TICK MARK. GENERALLY THIS IS USED WHEN DIMENSIONS GO INTO PUBLIC RIGHT OF WAYS.

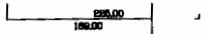

ARROWS ARE USED WITH DIMENSIONS IN AREAS OF GREATER COMPLEXITY.

NOTICE: This map was created for Assessor's Office use ONLY.




SCALE 1" = 400'
OF 1:4800

Plot file created: November 16, 2011
Assessor\071W19 of 000000

SEC.19 T7S R1W WM, MARION COUNTY

7 1 W 19

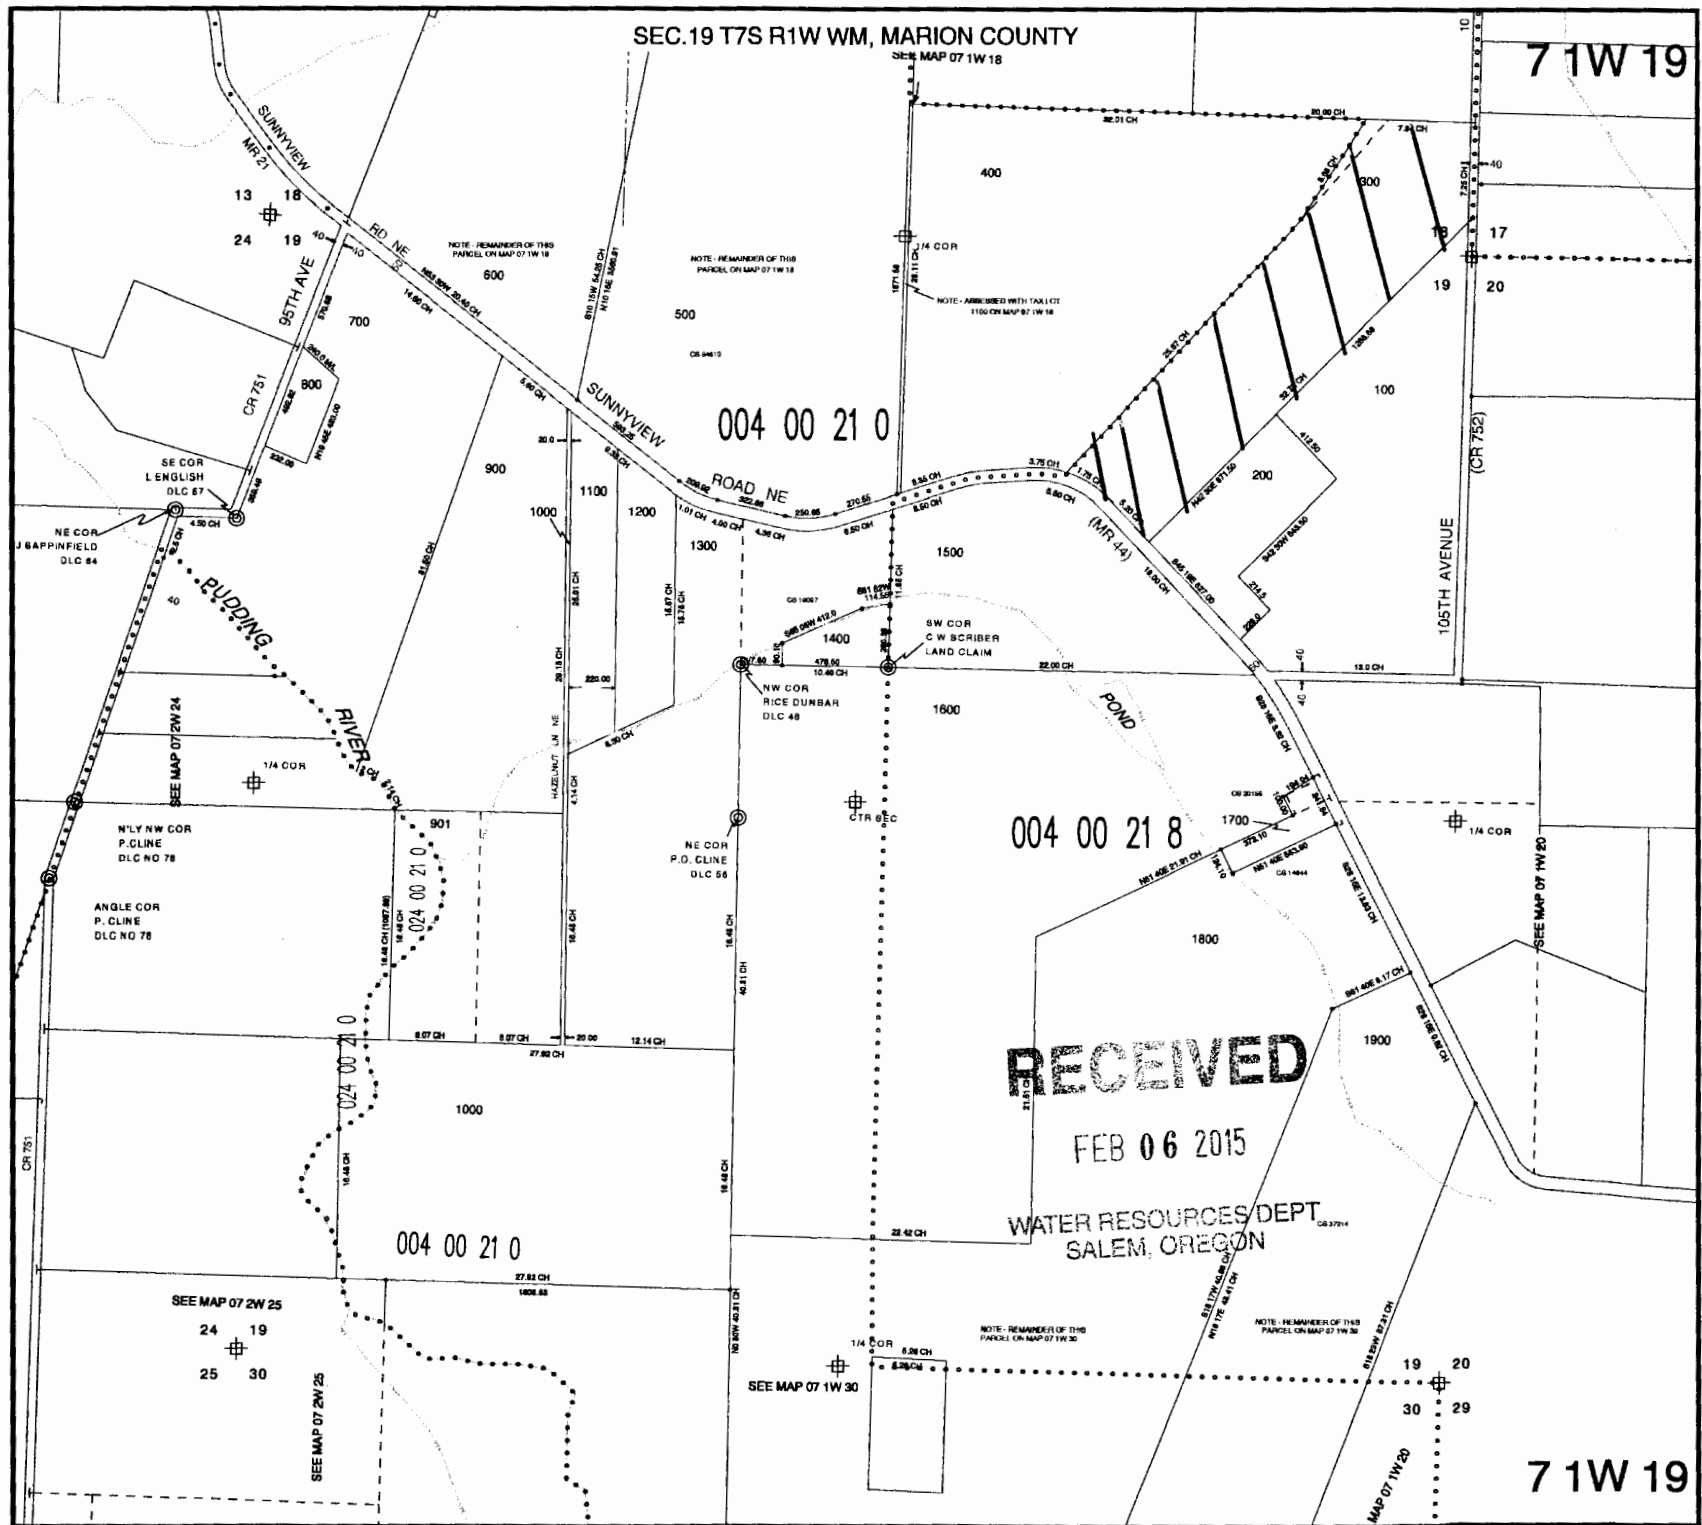


RECEIVED
FEB 06 2015
WATER RESOURCES DEPT.
SALEM, OREGON

6-17-2015

7 1 W 19

T7S, R1W

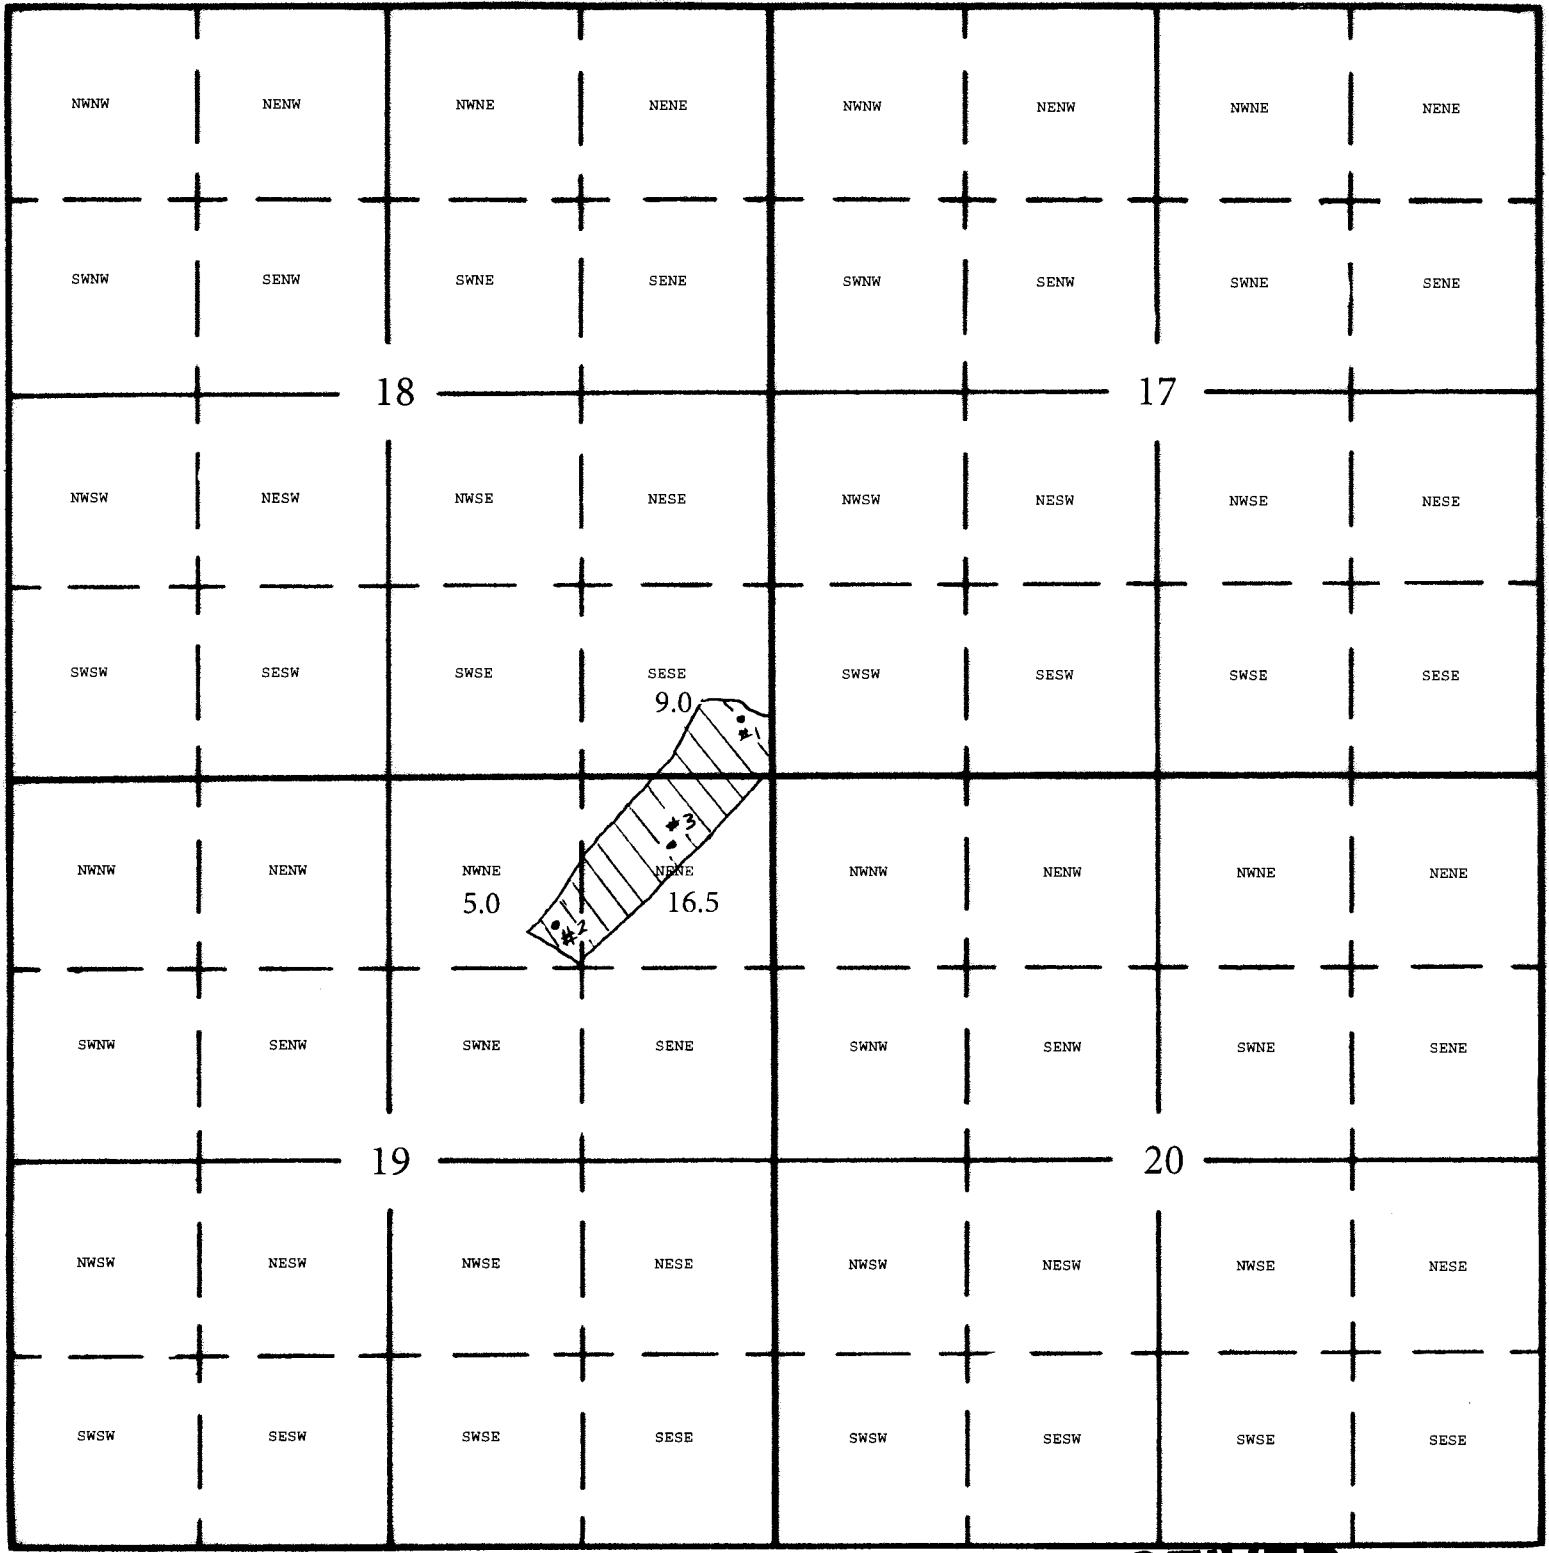

South

RECEIVED

MAR 24 2015

WATER RESOURCES DEPT
SALEM, OREGON

- WELL 1: 400' N & 200' W FR SE COR, S18
- WELL 2: 975' S & 1475' W FR NE COR, S19
- WELL 3: 450' S & 725' W FR NE COR, S19