

617995

48-102-1509

JAN 26 2015

SEC. 23, T. 20 S., R. 46 E., W. M.


SALEM, OR

THIS MAP WAS PREPARED FOR ASSESSMENT PURPOSE ONLY



SECTION 23 T.20S. R.46E. W.M.
MALHEUR COUNTY
1" = 400'

20S46E23

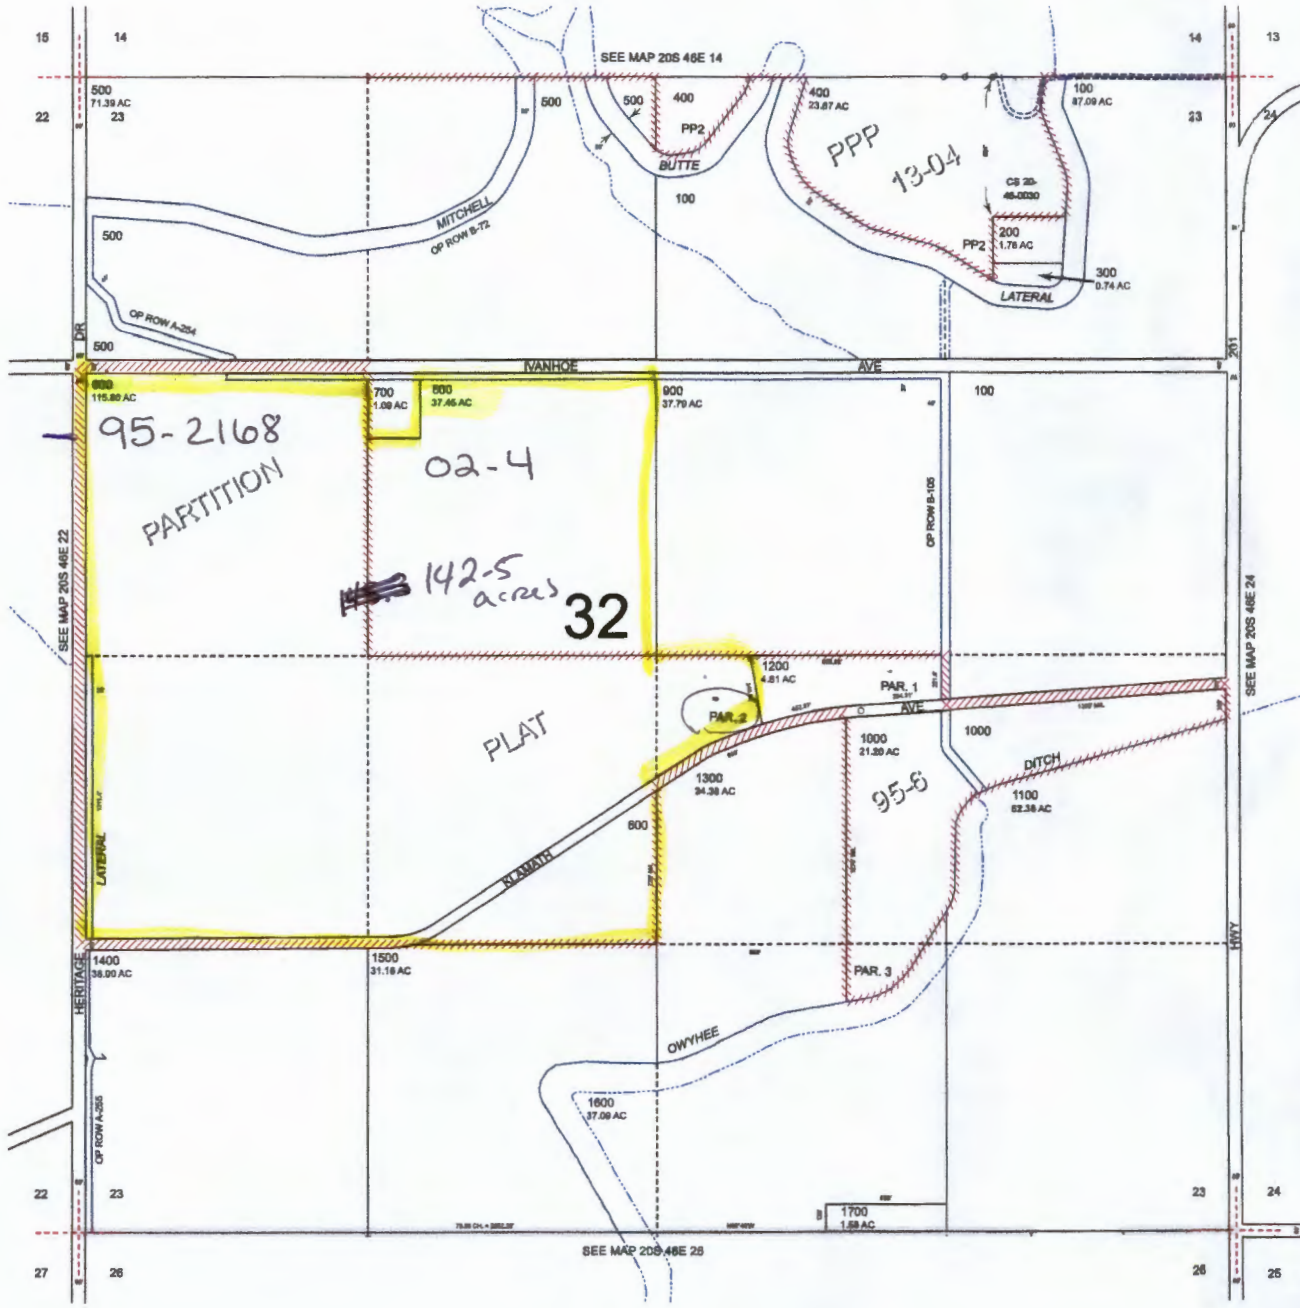

RECEIVED BY OWRD

FEB 09 2015

SALEM, OR

Pump #3

Gr-FPS

Revised by
08/28/2013

20S46E23

RECEIVED BY OWRD

MAR 19 2014

RECEIVED BY OWRD

SALEM, OR

MAR 10 2014

SALEM, OR

RECEIVED BY OWRD

SEC. 22 - T.20S. - R.46E.

RECEIVED BY OWRD


JAN 26 2015

FEB 09 2015

SALEM, OR

SALEM, OR

Well location located 170ft east and 170ft South of the $\frac{1}{16}$ quarter corner of Sec. 22-T20S-R46E

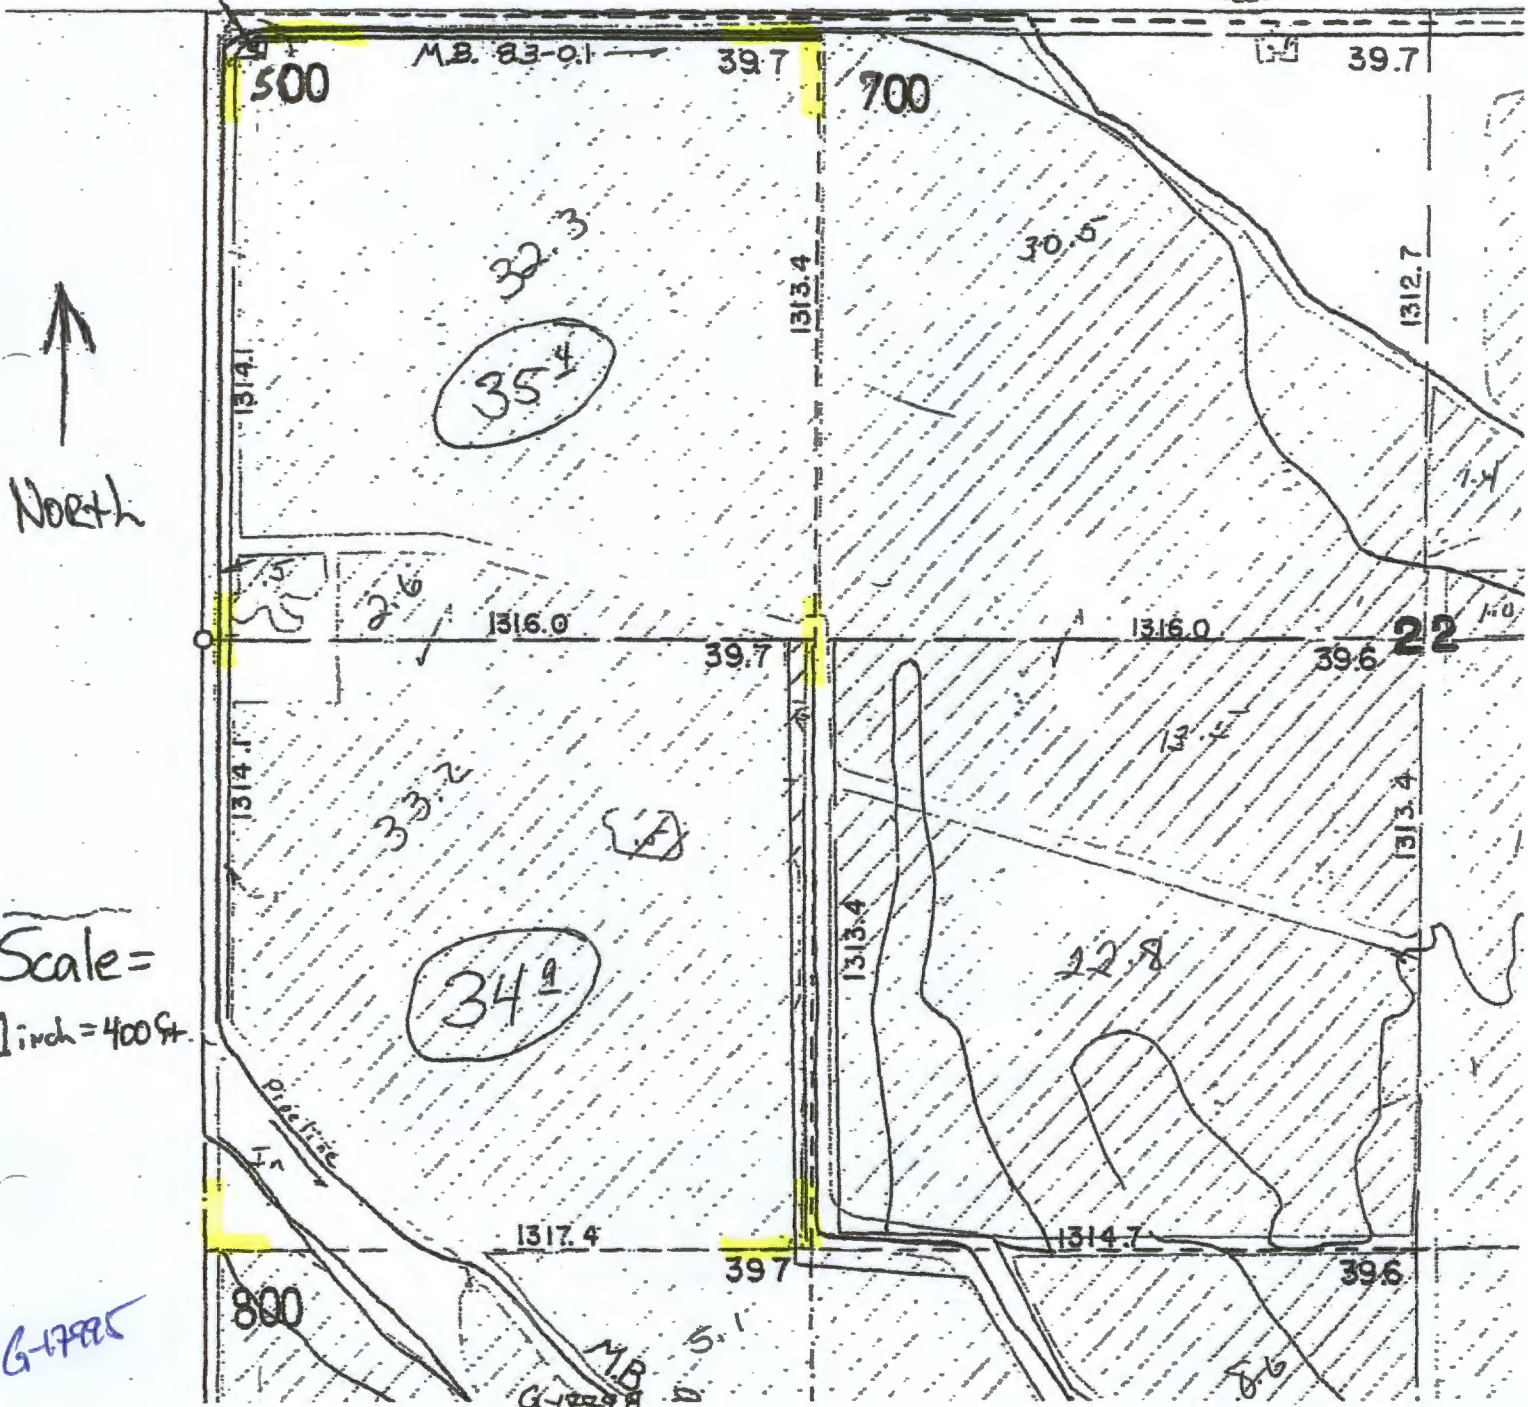

Scale =
1 inch = 400 ft.

G-17795

M.B. 5.1
G-17798

THIS MAP WAS PREPARED FOR ASSESSMENT PURPOSE ONLY




SECTION 22 T.20S. R.46E. W.M.
MALHEUR COUNTY
1" = 400'

20S 46E 22

G-17995

Pump #4

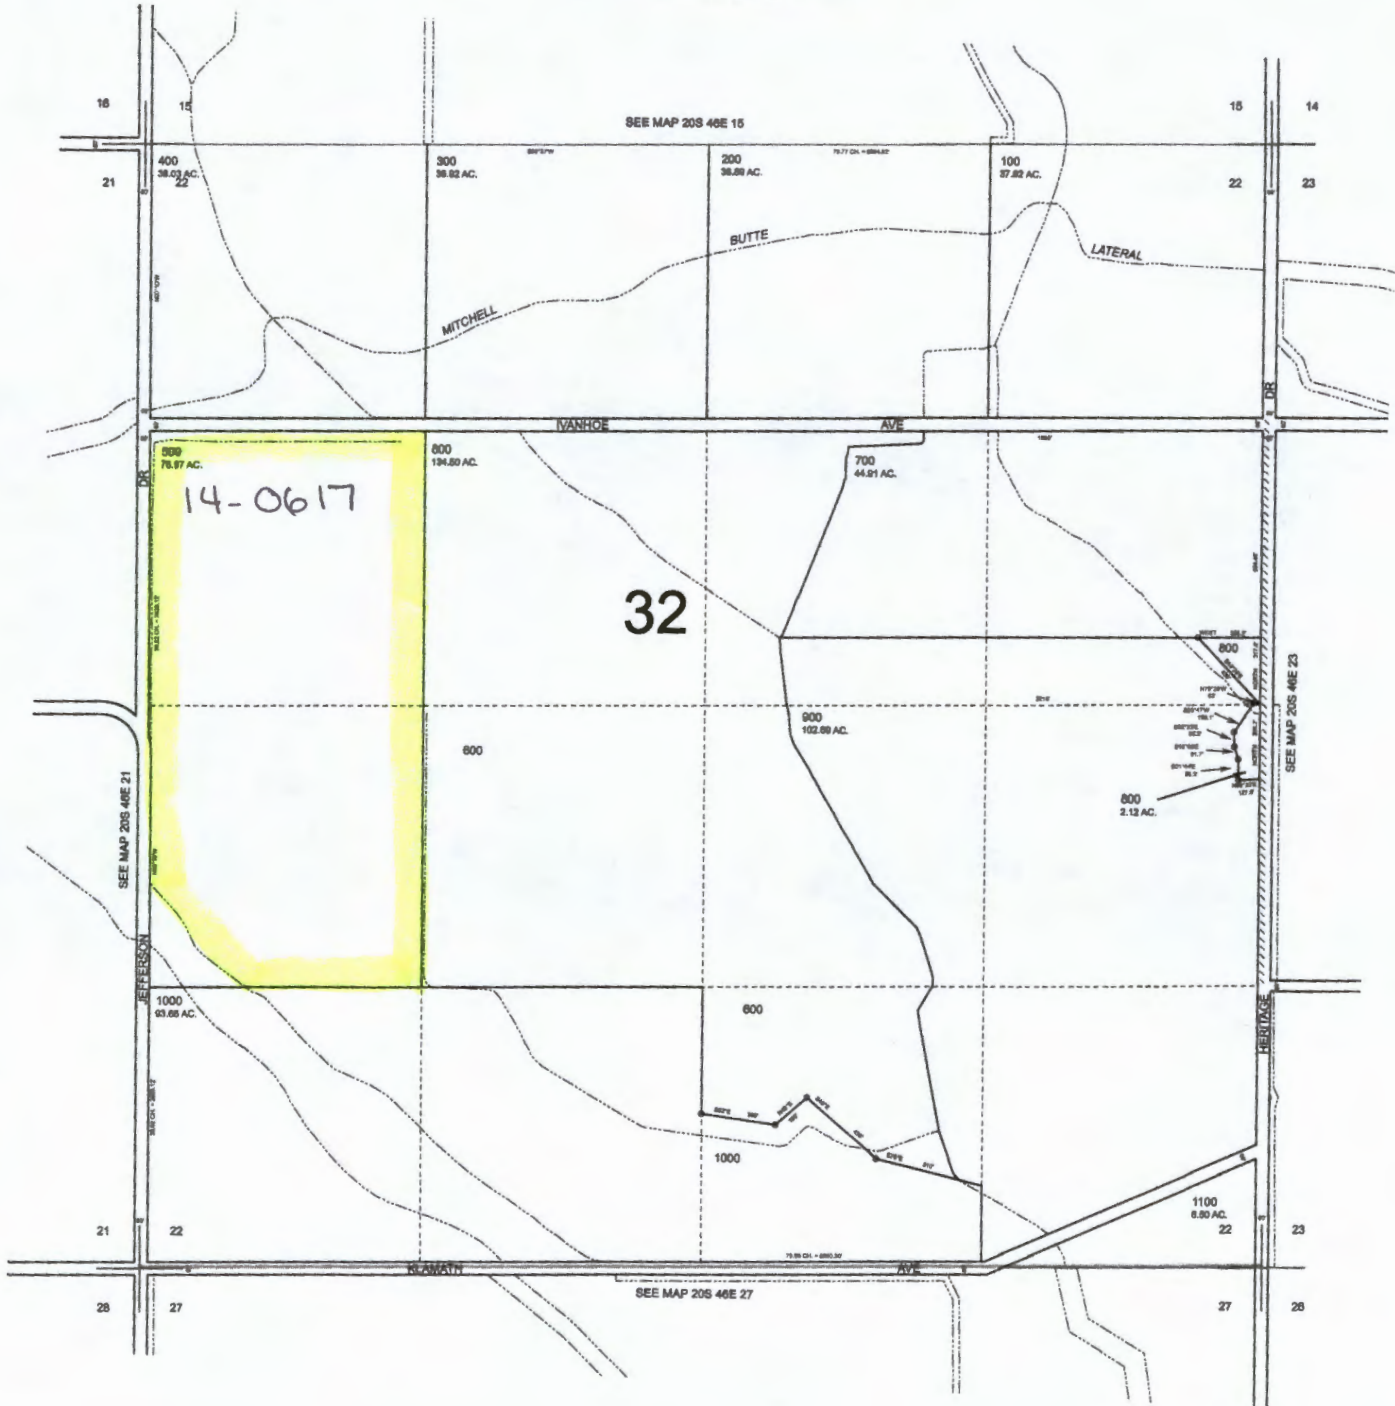


RECEIVED BY OWRD

FEB 09 2015
SALEM, OR

OWYHEE IRRIGATION [

SEC. 27 - T.20S. - R.46E.

48-102-1512

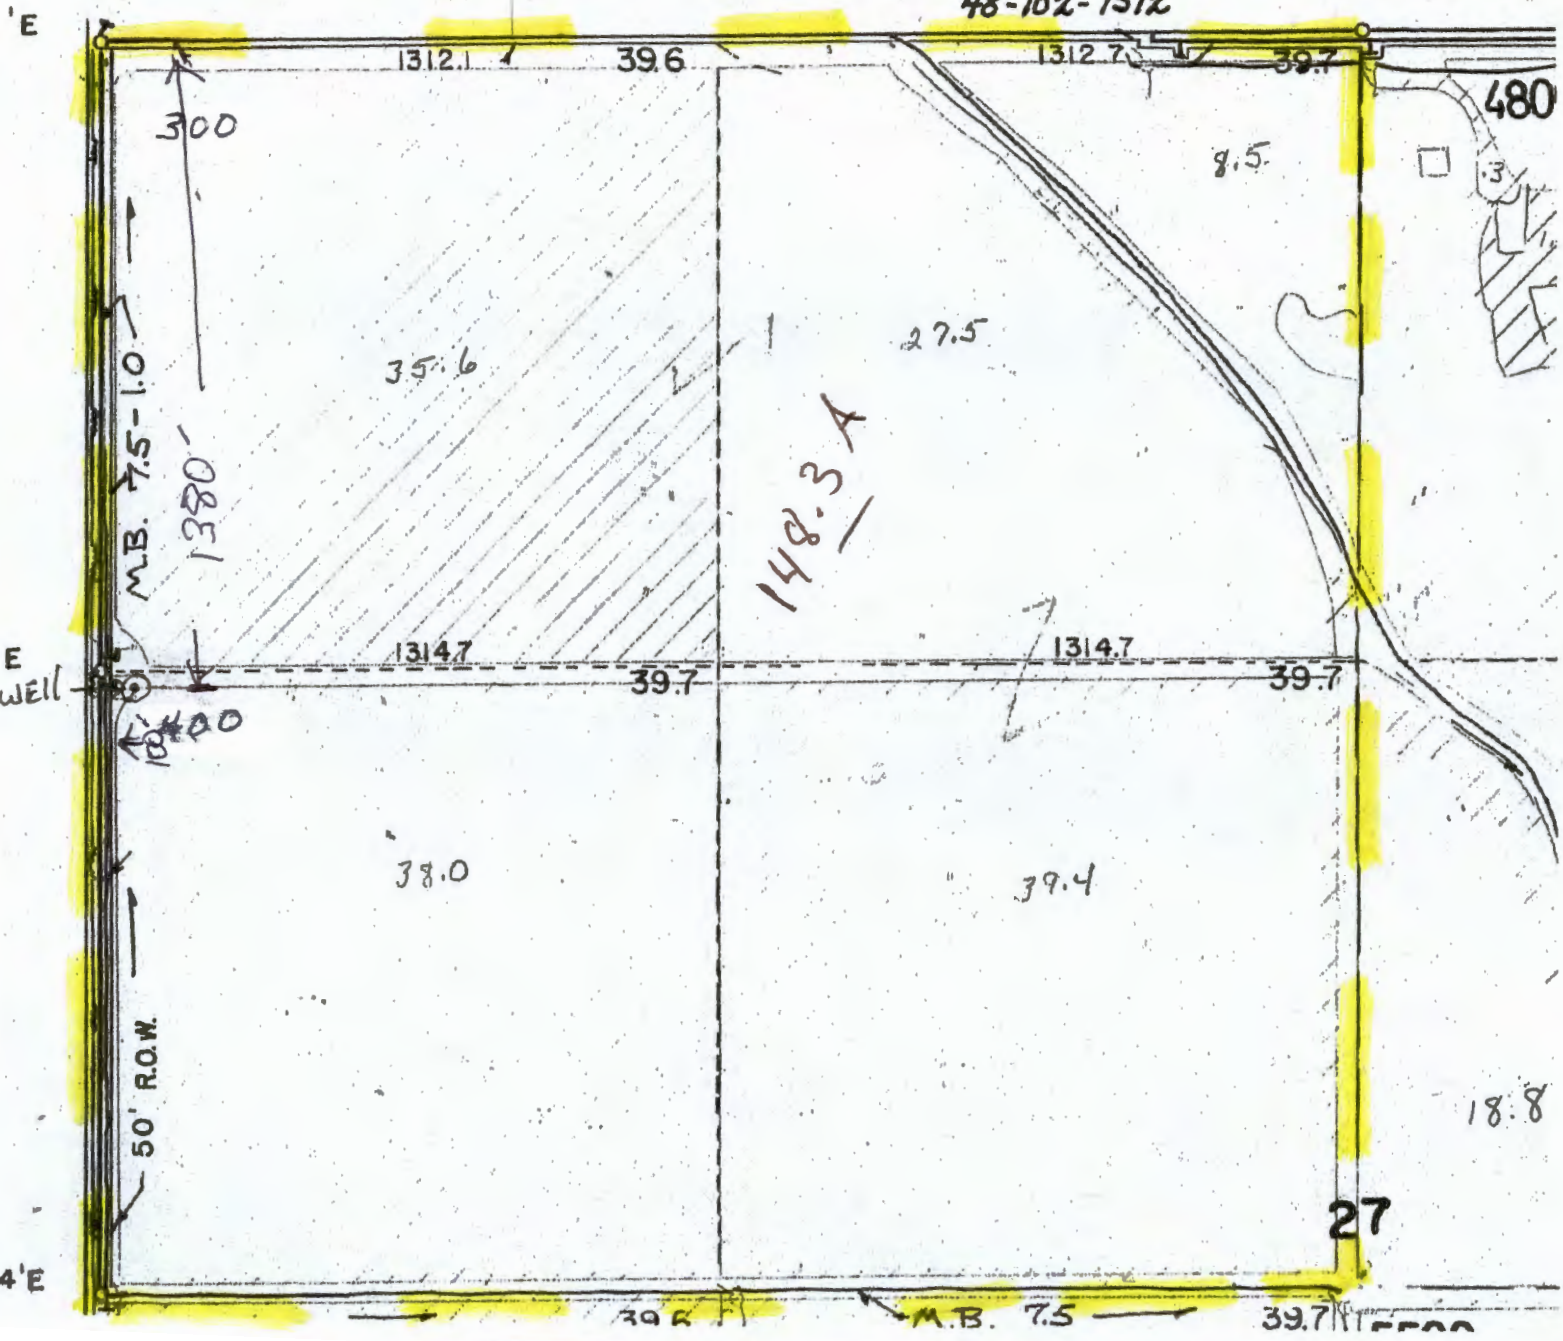

RECEIVED BY OWRD

FEB 09 2015

SALEM, OR




SCALE: 1" = 400'

Pump # 5

G-17995

THIS AREA

THIS MAP WAS PREPARED FOR ASSESSMENT PURPOSE ONLY

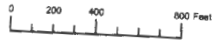


SECTION 27 T.20S. R.46E. W.M.
MALHEUR COUNTY
1" = 400'

20S 46E 27

RECEIVED BY OWRD

FEB 09 2015

SALEM, OR

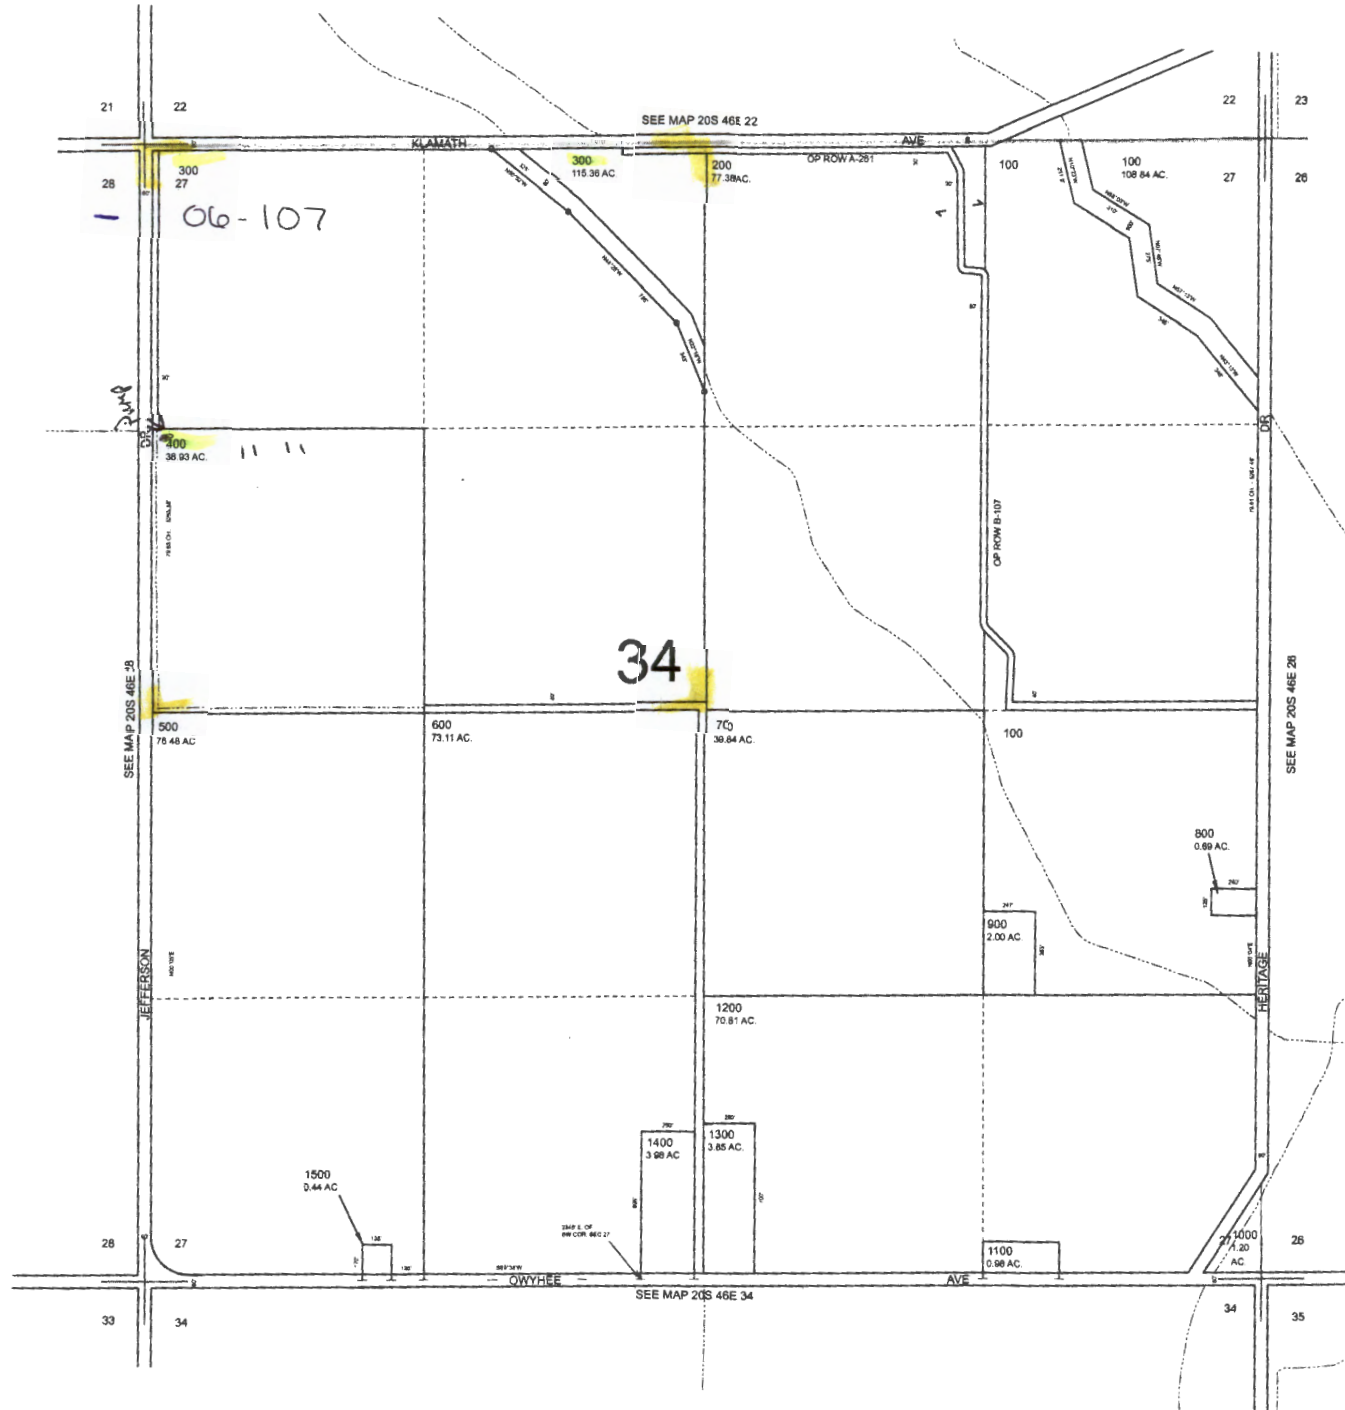

Handwritten: Pump # 5

Handwritten: Pump # 5

Handwritten: G-17895-


T710
ASSE

RECEIVED
APR 01 2015
OWRD

OWYHEE IRRIGATION I

SEC. 27 - T.20S. - R.46E.

48-102-1512

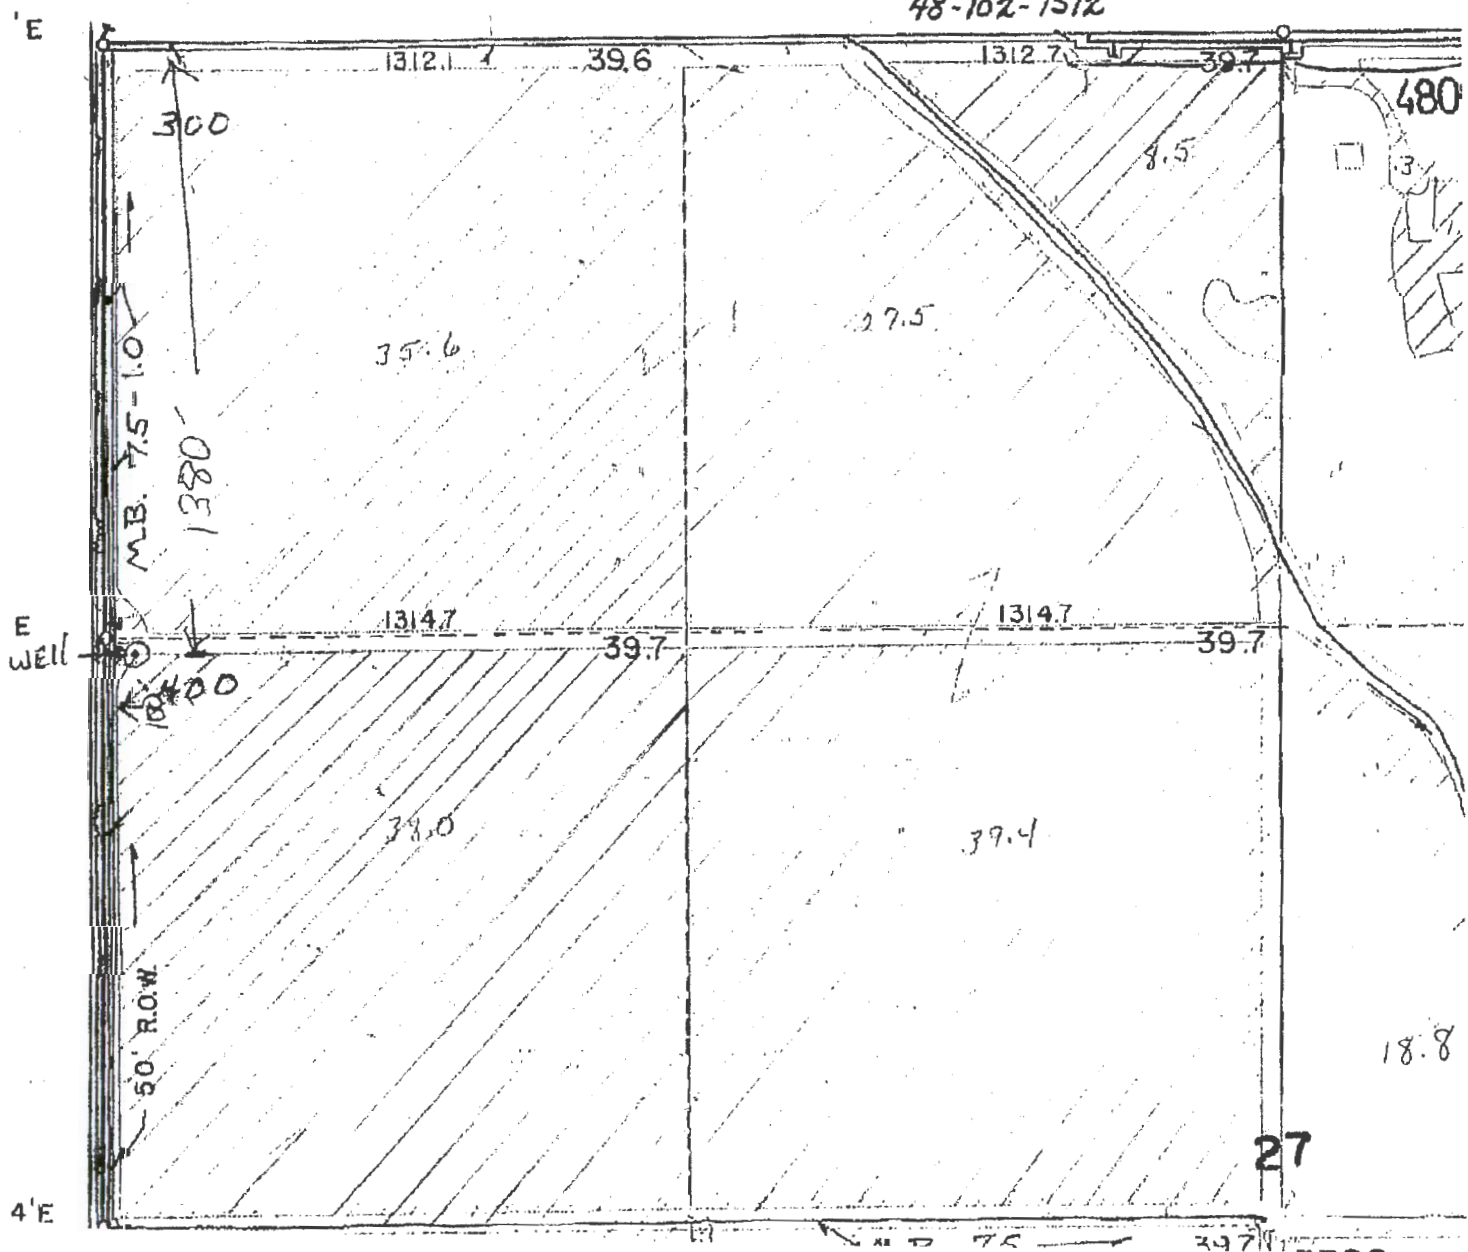

↑
N
SCALE: 1" = 400'

Pump #5

6-17995

Pump # 5

Ground Water Application

Township	Range	Section	Tax Lot	1/4 1/4	Acres
20s	46e	27	300	NENW	36
				NWNW	35.6
				SWNW	38
				SENW	39.4
				Total	149

RECEIVED
APR 01 2015
OWRD

6-17995