

T 18 S, R 5 W, Sec 9 TL 1500


Dam 470' N & 2575' W
from SE corner Sec 9

0.93 Ac., 6 Ac. Fr.

RECEIVED BY OWRD

FEB 06 2015

SALEM, OR

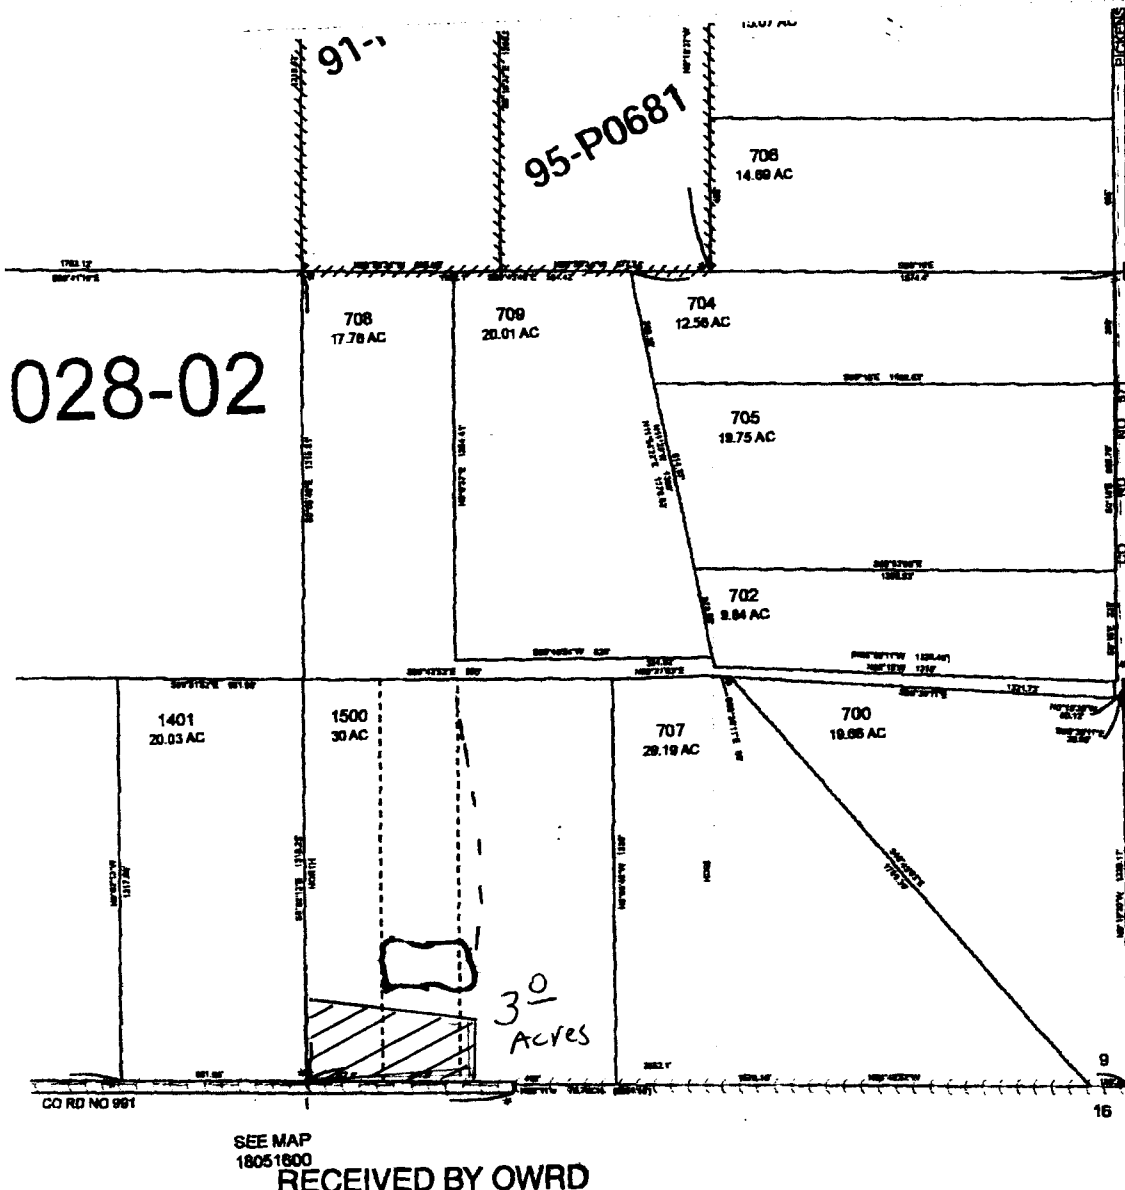

JUL 16 2014

SALEM, OR

R-87776
P-88050

18051