


Application Map for  
Lynn and Judith Niderost

NE 1/4 Sec. 31 T.24S. R.7W. W.M.  
Douglas County  
Scale: 1" = 500'

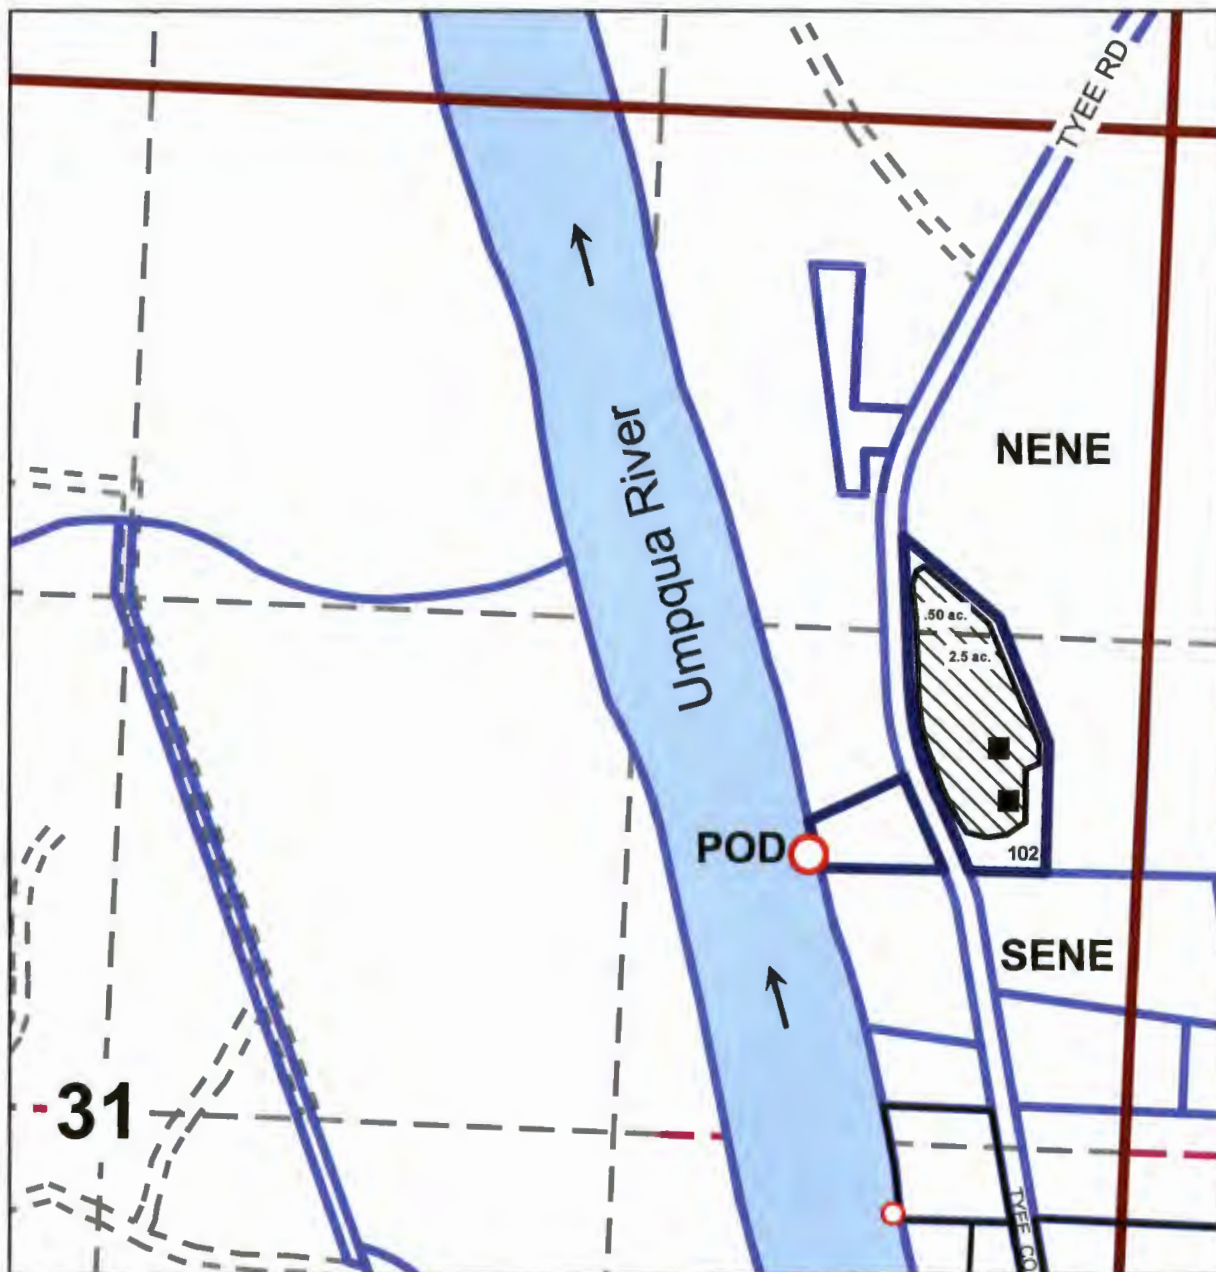

Point of Diversion is 1920 ft. south and 920 ft. west from the  
NE corner of Section 31.

RECEIVED BY OWRD

FEB 17 2015

SALEM, OR

S-88052